
PLAT OF SURVEY

KROTT SURVEYING INC. N3705 WILLOW BEND LANE LAKE GENEVA WI. 53147 PHONE # (262)248-3697 FAX # (262)249-0639

- OF -

A STRIP OF LAND 50 FEET IN WIDTH OF THE SOUTHWEST SIDE OF LOT 1 OF THE PLAT OF GOLF ADDITION, DELAVAN LAKE, IN THE TOWN OF DELAVAN, IN ACCORDANCE WITH THE RECORDED PLAT THEREOF IN VOL. 6 OF PLATS ON PAGE 120 IN THE OFFICE OF THE REGISTER OF DEEDS OF WALWORTH COUNTY, WISCONSIN.

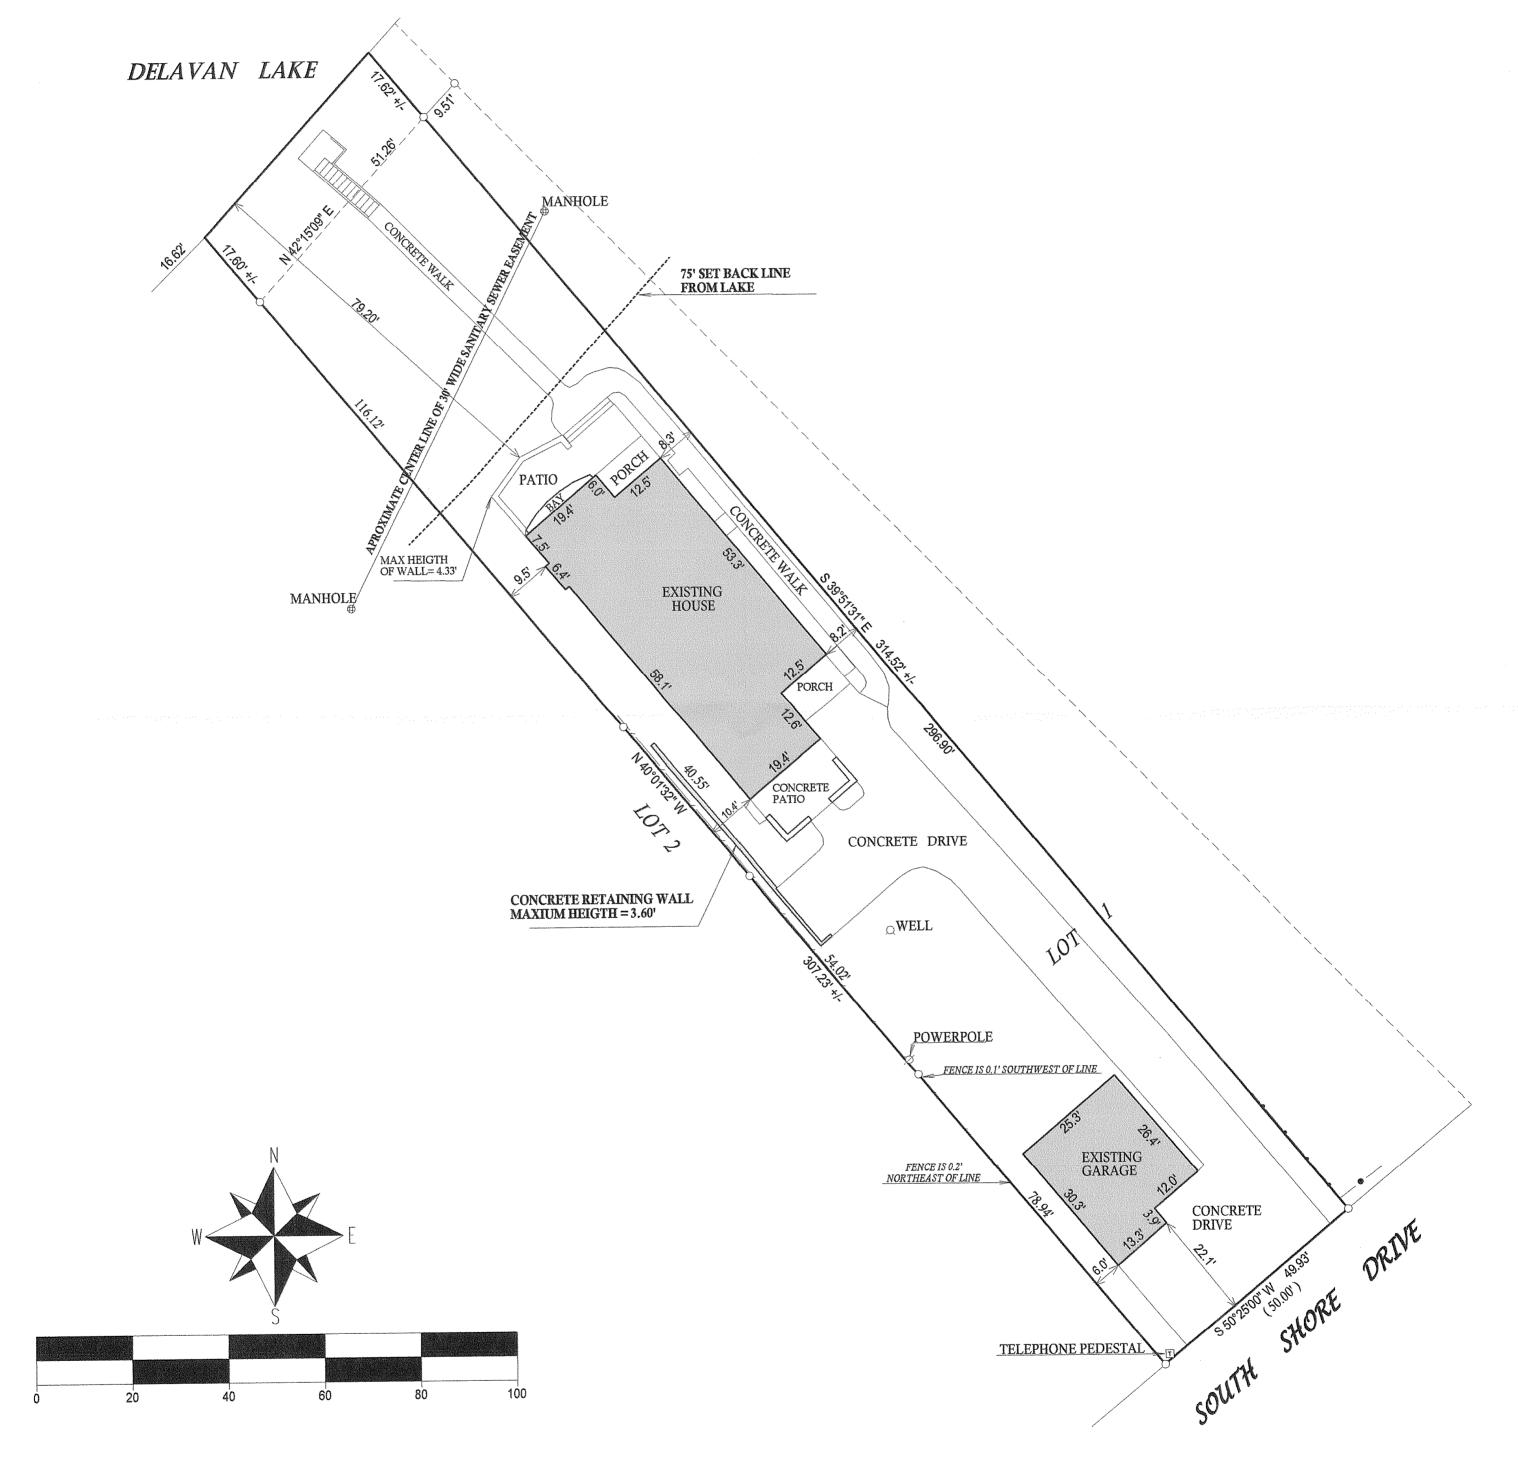

()= recorded as

 \Box = found iron bar

 \bigcirc = found iron pipe

= set iron pipe


= set iron barSCALE 1'' = 20'

JOB # 05-578UD 2009 TAX ID # FG000002 COMPARE LEGAL DESCRIPTION ABOVE AND DRAWING WITH DEED. FOR BUILDING RESTRICTIONS AND EASEMENTS NOT SHOWN, REFER TO DEED, ABSTRACT SOURCES AND LOCAL MUNICIPAL CODES. NOTIFY THE SURVEYOR IMMEDIATELY OF ANY DISCREPANCY.

"I hereby certify that I have surveyed the above described property and that the above map, to the best of my knowledge and belief, is a true representation thereof and shows the size and location of all visible structures, apparent easements and encroachmentsif any."

This survey is made for the present owners of the property, and those who purchase, mortgage, or guarentee the title thereto, within one year from the date bereof



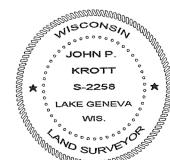

DATE OF LAST REVISION 7 / 07 / 2009



JOHN KROTT S - 2258
Wisconsin Registered Land Surveyor
(original if signed in red)
DATED THIS THE 25th DAY OF JULY 2008.