


ABELL  
SURVEYING & MAPPING  
1140 SEQUOIA STREET • DELAVAN, WISCONSIN 53115  
262-728-6737



NOTE: BEARINGS ARE REFERENCED TO  
EXISTING SURVEY RECORDS.

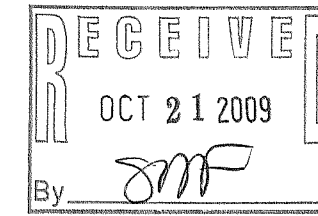


SCALE 1"=10'

LEGEND

- - IRON PIPE FOUND
- - IRON ROD FOUND
- - IRON PIPE SET
- ⊗ - MAG NAIL SET IN BLACKTOP
- △ - UTILITY POLE
- GUYWIRE
- - UTILITY PED
- - 2 1/2" DIA. IRON PIPE IN BLACKTOP FOR SUPPORT OF CANOPY.
- ( ) - RECORDED AS

NOTE: THERE IS NO CURVE DATA ON THE ORIGINAL  
PLAT OF DELAVAN LAKE ASSEMBLY GROUNDS.  
THE NORTHERLY LINES OF LOTS 20-23,  
BLOCK "Z" AND THE EASTERLY LINE OF  
LOT 19, BLOCK "Z" WERE SCALED OFF  
THE ORIGINAL PLAT.

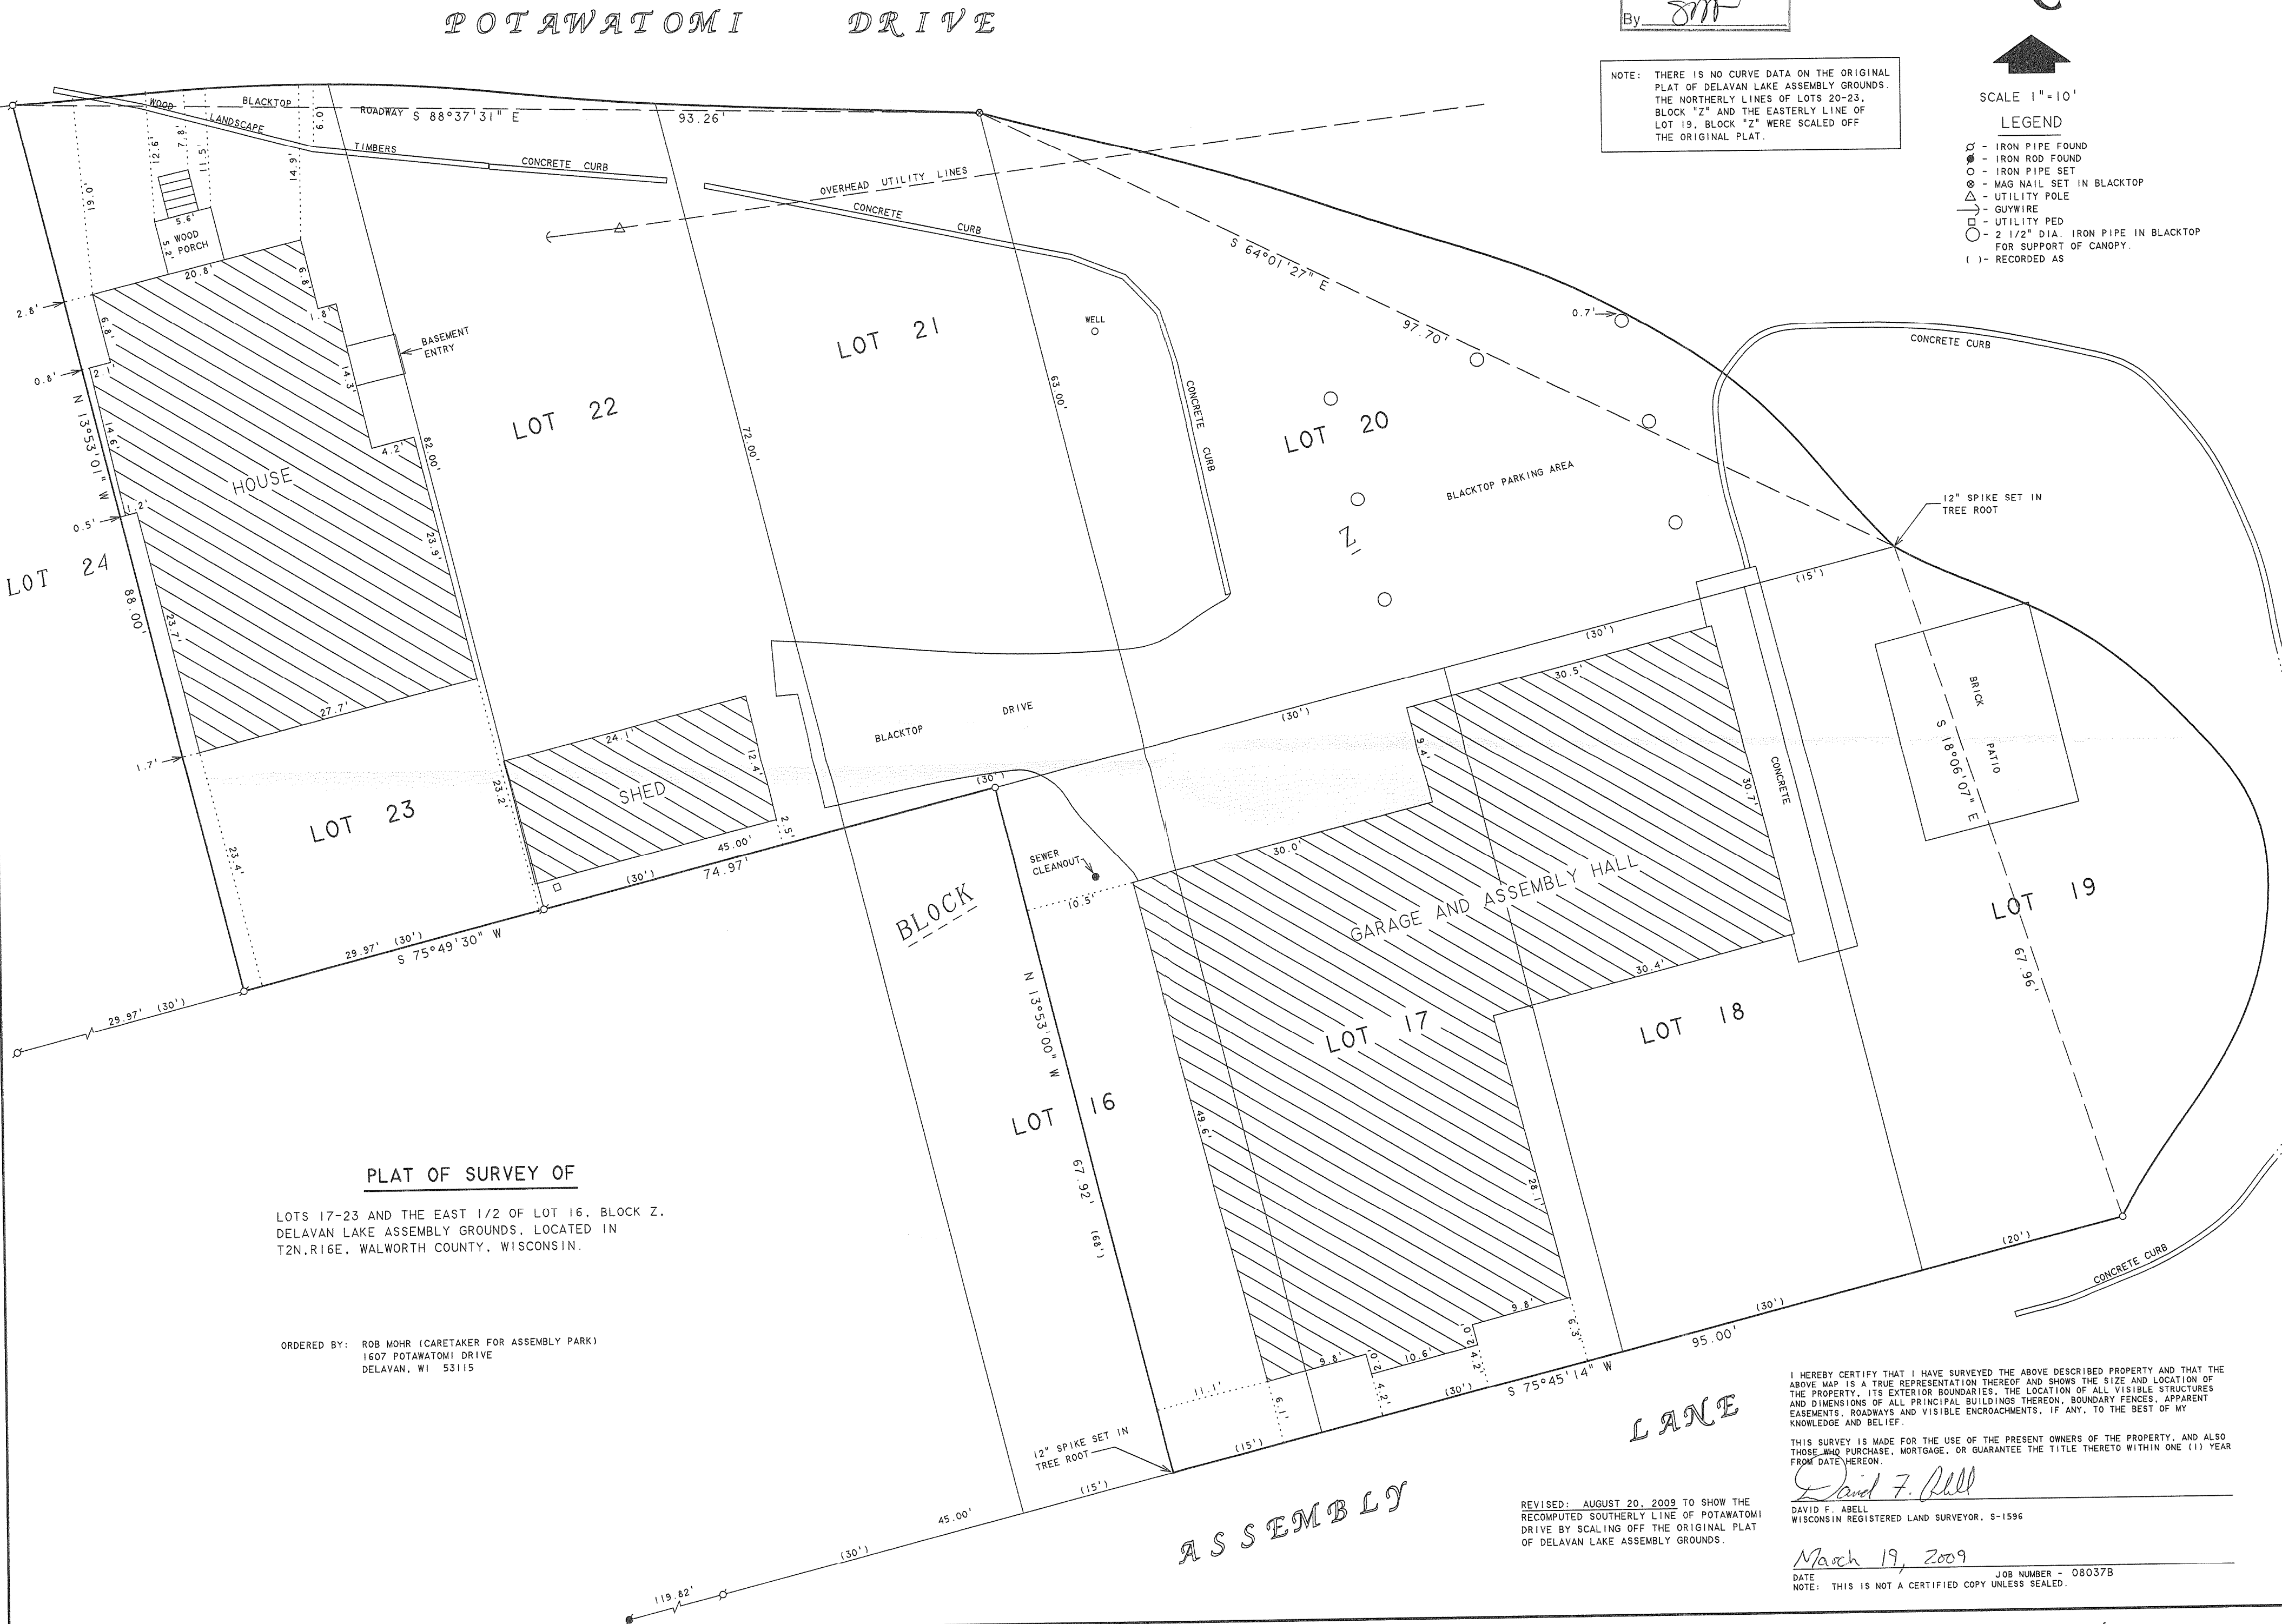

FDLA-2216

216-4694