


1140 SEQUOIA STREET • DELAVAN, WISCONSIN 53115
262-728-6737

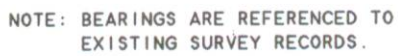

SCALE 1" = 20'

LEGEND

- ♂ - IRON PIPE FOUND
 ● - IRON ROD FOUND
 ● - CONCRETE MONUMENT FOUND
 () - RECORDED AS

ORDERED BY: COOK CONSTRUCTION
1407 RACINE STREET
SUITE C
DELAVER, WJ 53115

REVISED: AUGUST 27, 2009 TO SHOW
DISTANCES ON THE GARAGE FOUNDATION.

PLAT OF SURVEY OF

LOTS 2 AND 3, POTTERS SUBDIVISION, LOCATED IN
T2N, R16E, WALWORTH COUNTY, WISCONSIN.

I HEREBY CERTIFY THAT I HAVE SURVEYED THE ABOVE DESCRIBED PROPERTY AND THAT THE ABOVE MAP IS A TRUE REPRESENTATION THEREOF AND SHOWS THE SIZE AND LOCATION OF THE PROPERTY, ITS EXTERIOR BOUNDARIES, THE LOCATION OF ALL VISIBLE STRUCTURES AND DIMENSIONS OF ALL PRINCIPAL BUILDINGS THEREON, BOUNDARY FENCES, APPARENT EASEMENTS, ROADWAYS AND VISIBLE ENCROACHMENTS, IF ANY, TO THE BEST OF MY KNOWLEDGE AND BELIEF.

THIS SURVEY IS MADE FOR THE USE OF THE PRESENT OWNERS OF THE PROPERTY, AND ALSO THOSE WHO PURCHASE, MORTGAGE, OR GUARANTEE THE TITLE THERETO WITHIN ONE (1) YEAR FROM ~~DATE~~ HEREON.

DAVID F. ABELL
WISCONSIN REGISTERED LAND SURVEYOR, S-1596

August 12, 2009

DATE _____ JOB NUMBER - 03003F
NOTE: THIS IS NOT A CERTIFIED COPY UNLESS SEALED.

RECEIVED
DEC 23 2009
By *smf*

FPO-2

216-4706