PREPARED FOR:


LUANNE SMITH KEEFE REAL ESTATE 751 GENEVA PARKWAY LAKE GEVEVA, WI.

PLAT OF SURVEY


- OF -

PATHFINDER SURVEYING INC. (formerly) J.K. SURVEYING INC. W2888 KRUEGER RD. STE. "D" 262-248-8303

LOTS 25 AND THE WEST 1/2 OF LOT 24, BLOCK 3 INLET OAKS SUBDIVISION No. 3, LOCATED IN SECTIONS 15 AND 22, TOWN 2 NORTH, RANGE 16 EAST OF THE FOURTH PRINCIPAL MERIDIAN, TOWN OF DELAVAN, COUNTY OF WALWORTH AND STATE OF WISCONSIN.

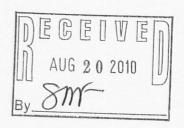

BREEZY DRIVE

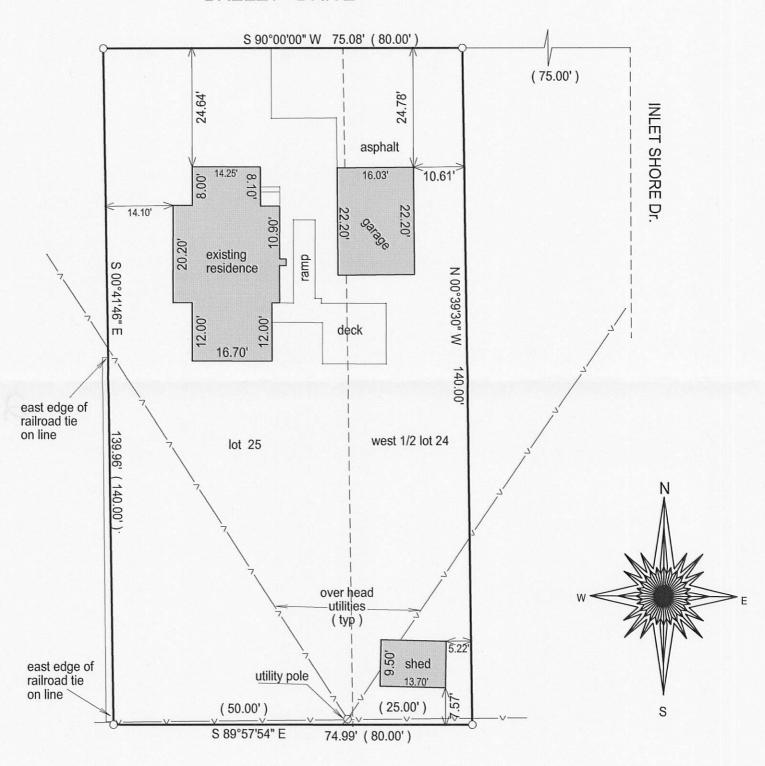

()= recorded as

□ = found iron bar

= found iron pipe

= set iron pipe

= set iron bar

SCALE 1" = 20'

JOB # 10-32

TAX ID #

FIN3 00070

BASIS OF BEARING OF THIS PLAT: THE SOUTH LINE OF BREEZY ST. WAS ASSUMED TO BEAR EAST - WEST.

"I hereby certify that I have surveyed the above described property and that the above map is a true representation of its exterior boundaries and shows the size and location of all visible structures, apparent easements and encroachments if any."

This survey is made for the present owners of the property, and those who purchase, mortgage, or guarantee the title thereto, within one year from the date hereof.

DATED THIS 25TH DAY OF MARCH, 2009.



Wisconsin Registered Land Surveyor (original if signed in red)