
## FARRIS, HANSEN & ASSOC. INC.

7 RIDGWAY COURT— P.O. BOX 437 ELKHORN, WSCONSIN 53121 PHONE (262) 723—2098 FAX (262) 723—5886 PLAT OF SURVEY
LOT 36 OF KRUMHAAR'S ADDITION TO RAVENSWOOD
LOCATED IN THE SE 1/4 SECTION 31
TOWN 2 NORTH, RANGE 16 EAST, WALWORTH COUNTY, WI.

ORDERED BY: MIKE FIORING FOR SUSAN ROMBERG

5 BITTERSWEET COURT

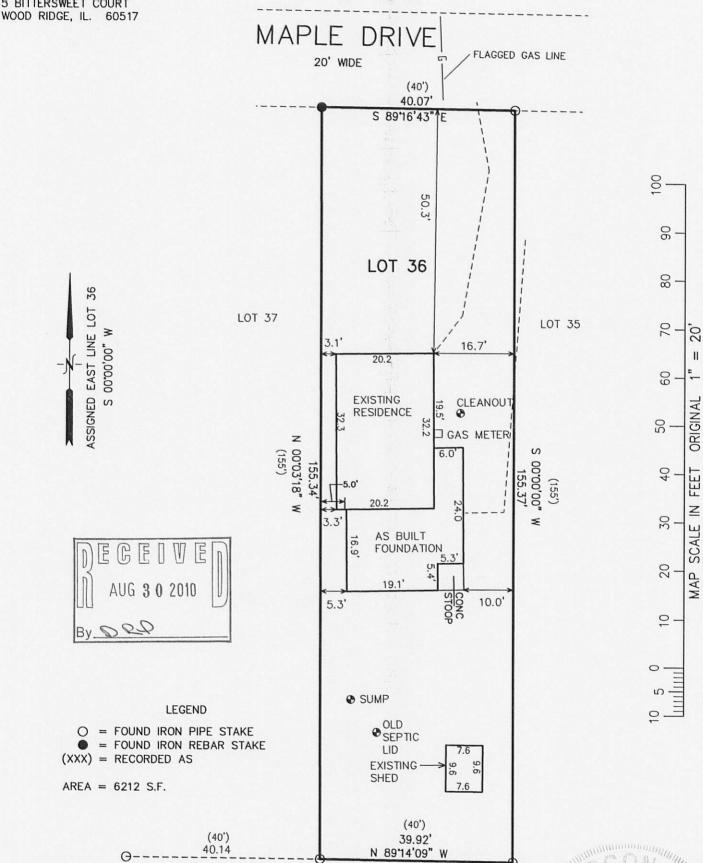

NOTE: COPIES OF THIS MAP TO WHICH THE FOLLOWING CERTIFICATE WILL APPLY SHOW SURVEYOR'S ORIGINAL SEAL AND SIGNATURE IN RED INK. COPIES BY ANY OTHER MEANS MAY HAVE ALTERATIONS WHICH DO NOT REPRESENT THE SURVEYOR'S WORK PRODUCT.

I HEREBY CERTIFY THAT THE ABOVE DESCRIBED PROPERTY HAS BEEN SURVEYED UNDER MY DIRECTION AND THAT THE ABOVE MAP IS A TRUE REPRESENTATION THEREOF AND SHOWS THE SIZE AND LOCATION OF THE PROPERTY AND ITS EXTERIOR BOUNDARIES. THIS SURVEY IS MADE FOR THE USE OF THE PRESENT OWNERS OF THE PROPERTY, AND ALSO THOSE WHO PURCHASE, MORTGAGE, OR GUARANTEE THE TITLE THERETO WITHIN ONE YEAR FROM THE DATE HEREOF.

REVISED 05-07-2010

DATED: \_\_APRIL\_28, 2010

REVISED 08-25-2010 TO SHOW AS BUILT FOUNDATION

PETER S. GORDON R.L.S. 2101

AUG 2 5 2010

FRA-33

PROJECT NO. 8124 DATED: 04-28-2010 SHEET 1 OF 1 SHEETS

ELKHORN,

216-4768