

# ABELL SURVEYING & MAPPING

1140 SEQUOIA STREET • DELAVAN, WISCONSIN 53115  
262-728-6737

BEARINGS ARE REFERENCED TO THE  
RECORDED SUBDIVISION PLAT.




SCALE 1"=20'

## LEGEND

- - IRON PIPE FOUND
- MHC - MANHOLE COVER
- ▲ - YARD LIGHT
- - UTILITY PDS
- - WOOD FENCE
- ( ) - RECORDED AS

## PLAT OF SURVEY OF

LOT 5 OF LAKEWOOD ESTATES, LOCATED IN THE  
SOUTHWEST 1/4 OF SECTION 21, T2N, R16E,  
TOWN OF DELAVAN, WALWORTH COUNTY, WISCONSIN.

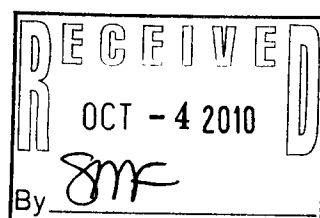

I HEREBY CERTIFY THAT I HAVE SURVEYED THE ABOVE DESCRIBED PROPERTY AND THAT THE ABOVE MAP IS A TRUE REPRESENTATION THEREOF AND SHOWS THE SIZE AND LOCATION OF THE PROPERTY, ITS EXTERIOR BOUNDARIES, THE LOCATION OF ALL VISIBLE STRUCTURES AND DIMENSIONS OF ALL PRINCIPAL BUILDINGS THEREON, BOUNDARY FENCES, APPARENT EASEMENTS, ROADWAYS AND VISIBLE ENCROACHMENTS, IF ANY, TO THE BEST OF MY KNOWLEDGE AND BELIEF.

THIS SURVEY IS MADE FOR THE USE OF THE PRESENT OWNERS OF THE PROPERTY, AND ALSO THOSE WHO PURCHASE, MORTGAGE, OR GUARANTEE THE TITLE THERETO WITHIN ONE (1) YEAR FROM DATE HEREON.

*David F. Abell*  
DAVID F. ABELL  
WISCONSIN REGISTERED LAND SURVEYOR, S-1596

ORDERED BY: MARY QUARTARARO  
6907 N. OWEN AVENUE  
CHICAGO, IL 60631

August 9, 2010

DATE: August 9, 2010 JOB NUMBER - 88089A  
NOTE: THIS IS NOT A CERTIFIED COPY UNLESS SEALED.