
ABELL SURVEYING & MAPPING

1140 SEQUOIA STREET . DELAVAN, WISCONSIN 53115

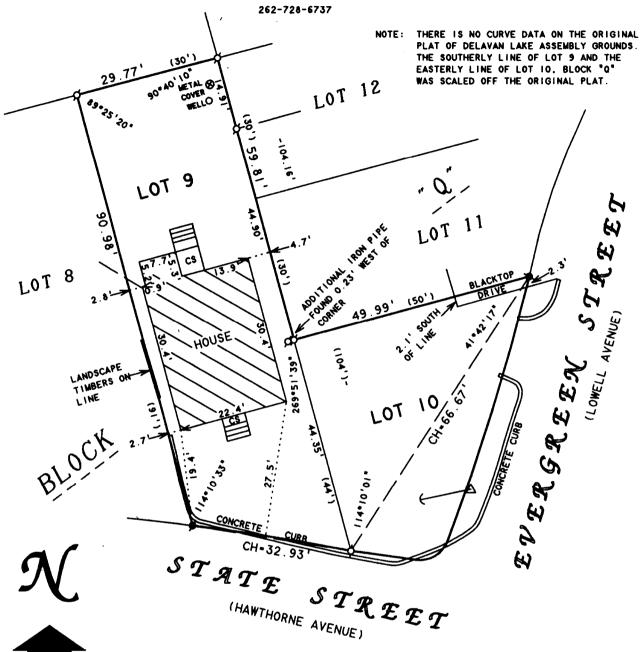

SCALE | " = 20 '

LEGEND


-IRON PIPE FOUND -IRON ROD FOUND -CONCRETE STOOP -UTILITY POLE

ćs ∆

-GUY WIRE

PLAT OF SURVEY OF

LOTS 9 AND 10. BLOCK "Q". DELAVAN LAKE ASSEMBLY GROUNDS, LOCATED IN T2N, RIGE. TOWN OF DELAVAN. WALWORTH COUNTY, WISCONSIN.

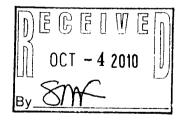

I HEREBY CERTIFY THAT I HAVE SURVEYED THE ABOVE DESCRIBED PROPERTY AND THAT THE ABOVE MAP IS A TRUE REPRESENTATION THEREOF AND SHOWS THE SIZE AND LOCATION OF THE PROPERTY, ITS EXTERIOR BOUNDARIES. THE LOCATION OF ALL VISIBLE STRUCTURES AND DIMENSIONS OF ALL PRINCIPAL BUILDINGS THEREON, BOUNDARY FENCES, APPARENT EASEMENTS, ROADWAYS AND VISIBLE ENCROACHMENTS, IF ANY, TO THE BEST OF MY KNOWLEDGE AND BELIEF.

THIS SURVEY IS MADE FOR THE USE OF THE PRESENT OWNERS OF THE PROPERTY, AND ALSO THOSE WHO PURCHASE, MORTGAGE, OR GUARANTEE THE TITLE THERETO WITHIN ONE (I) YEAR FROM BALE HEREON.

ORDERED BY: BARB TOUCHETT 227 HASTINGS WAY

POPLAR GROVE. IL 61065

Glill

DAVID F. ABELL WISCONSIN REGISTERED LAND SURVEYOR, S-1596

July 28, 2010

DATE JOB NUMBER - 10030 NOTE: THIS IS NOT A CERTIFIED COPY UNLESS SEALED.