


Plat of Survey

of

Lot 11 of Lakewood Estates,

a subdivision located in the Southwest 1/4 of Section 21, Town 2 North,
Range 16 East, Town of Delavan, Walworth County, Wisconsin.

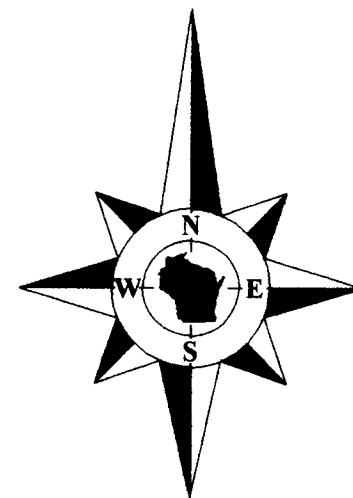


Bearings reference to the
plat of Lakewood Estates.

Delavan

Lake

Surveyed for: **John Davis**
618 Wesley Drive
Park Ridge, Illinois. 60068

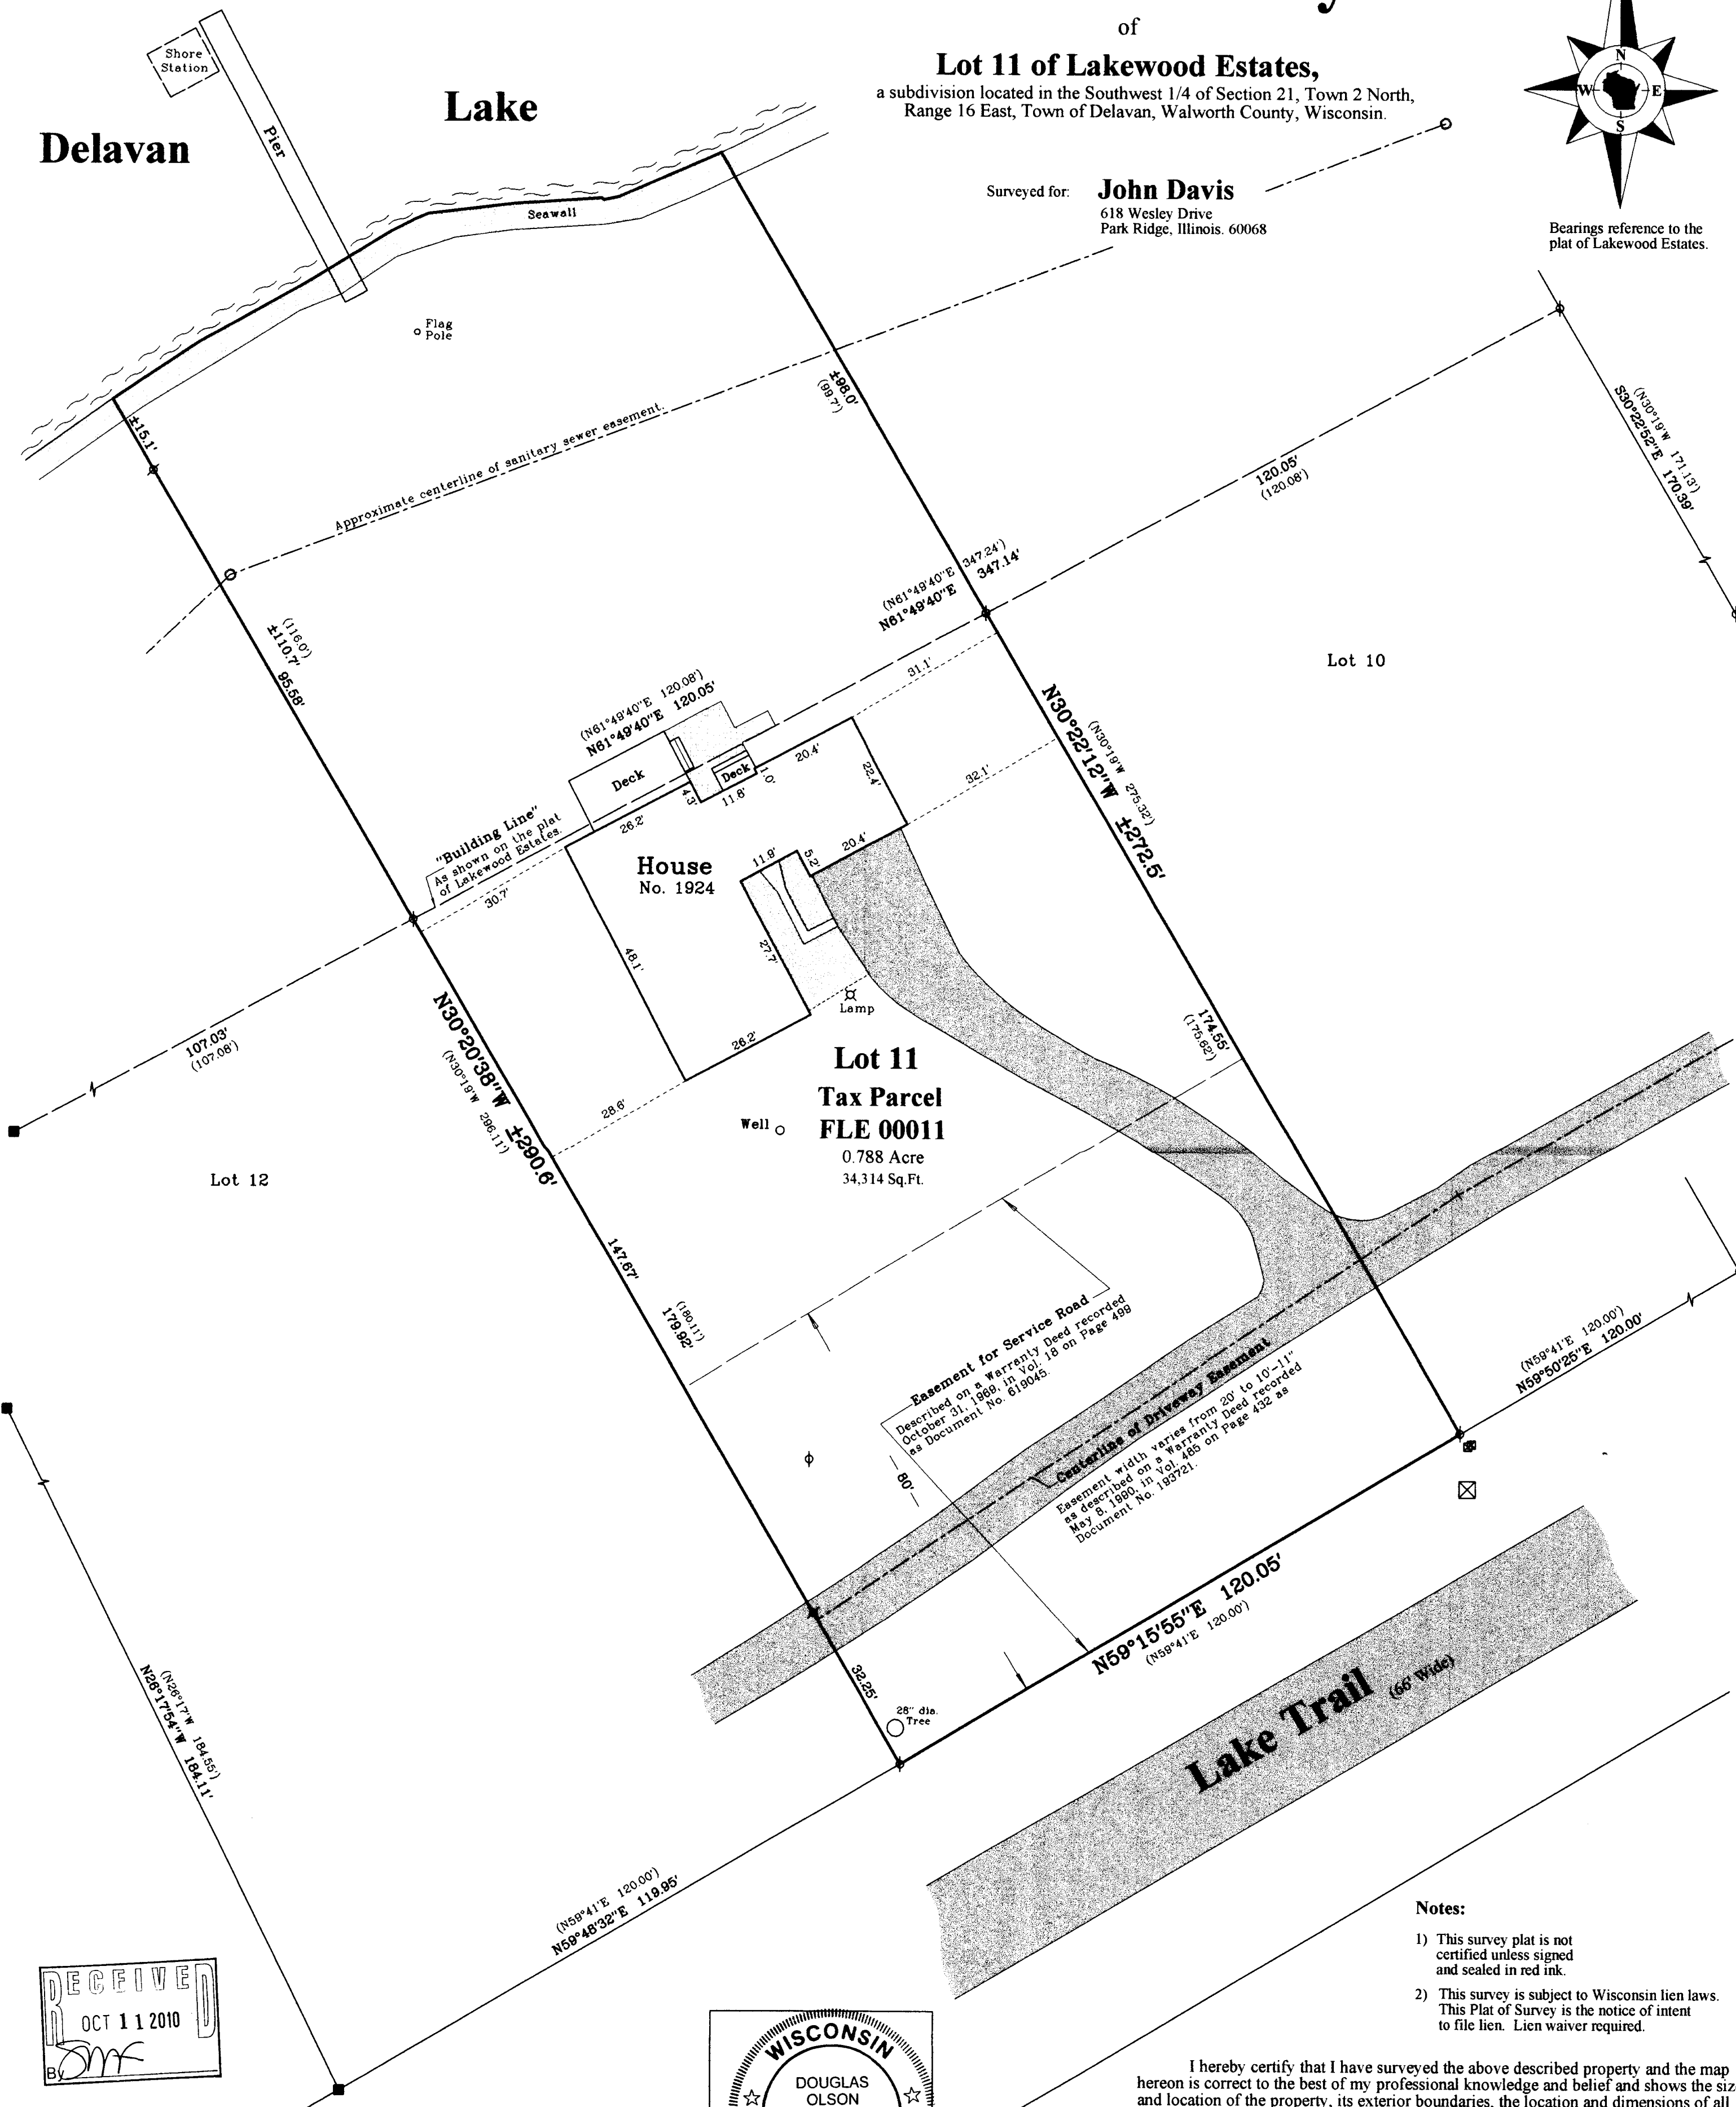


Notes:

- 1) This survey plat is not certified unless signed and sealed in red ink.
- 2) This survey is subject to Wisconsin lien laws. This Plat of Survey is the notice of intent to file lien. Lien waiver required.

I hereby certify that I have surveyed the above described property and the map hereon is correct to the best of my professional knowledge and belief and shows the size and location of the property, its exterior boundaries, the location and dimensions of all visible structures thereon, boundary fences, apparent easements and roadways and visible encroachments, if any.


This survey is made for the exclusive use of the present owners of the property, and also those who purchase, mortgage or guarantee title thereto, within one year from the date hereof.

Douglas G. Olson
Wisconsin Registered Land Surveyor - 2093

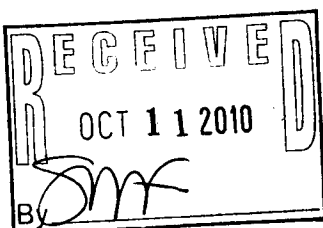

Copyright 2010 by Jensen & Olson Land Surveying, LLC.

All rights reserved. No part of this survey plat may be reproduced or transmitted in any form by any means - graphic, electronic, or mechanical, including photocopying, tracing, or information storage and retrieval systems - without permission in writing from Douglas G. Olson, Jensen & Olson Land Surveying, LLC.

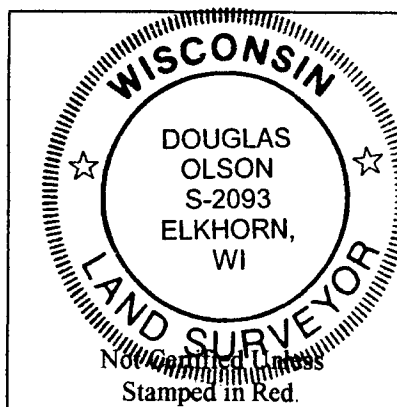

2010.067

Sheet 1 of 1 Sheets

Drawing Name: t2nr16-2010067-2010067Plat.scj

Job Reference Number

2010.067

Legend

- Found Concrete Monument
- Found Iron Pipe
- Set Mag Nail
- Recorded Information
- Utility Box or Pedestal
- Asphalt Surface
- Concrete Surface
- Gravel Surface
- Pavers



Jensen & Olson Land Surveying, LLC

45 South Wisconsin Street * P.O. Box 322 * Elkhorn, Wisconsin. 53121

Telephone: (262) 723-3434 * Facsimile: (262) 723-8044

Email: jensen.olson@elknet.net

Scale in Feet

1" = 20'

0' 10' 20' 40'

Survey Date: July 29, 2010.

Revisions: