

## Plat of Survey Lot 47 of High Pointe Addition No. 1,

Outlot 1 Pointe

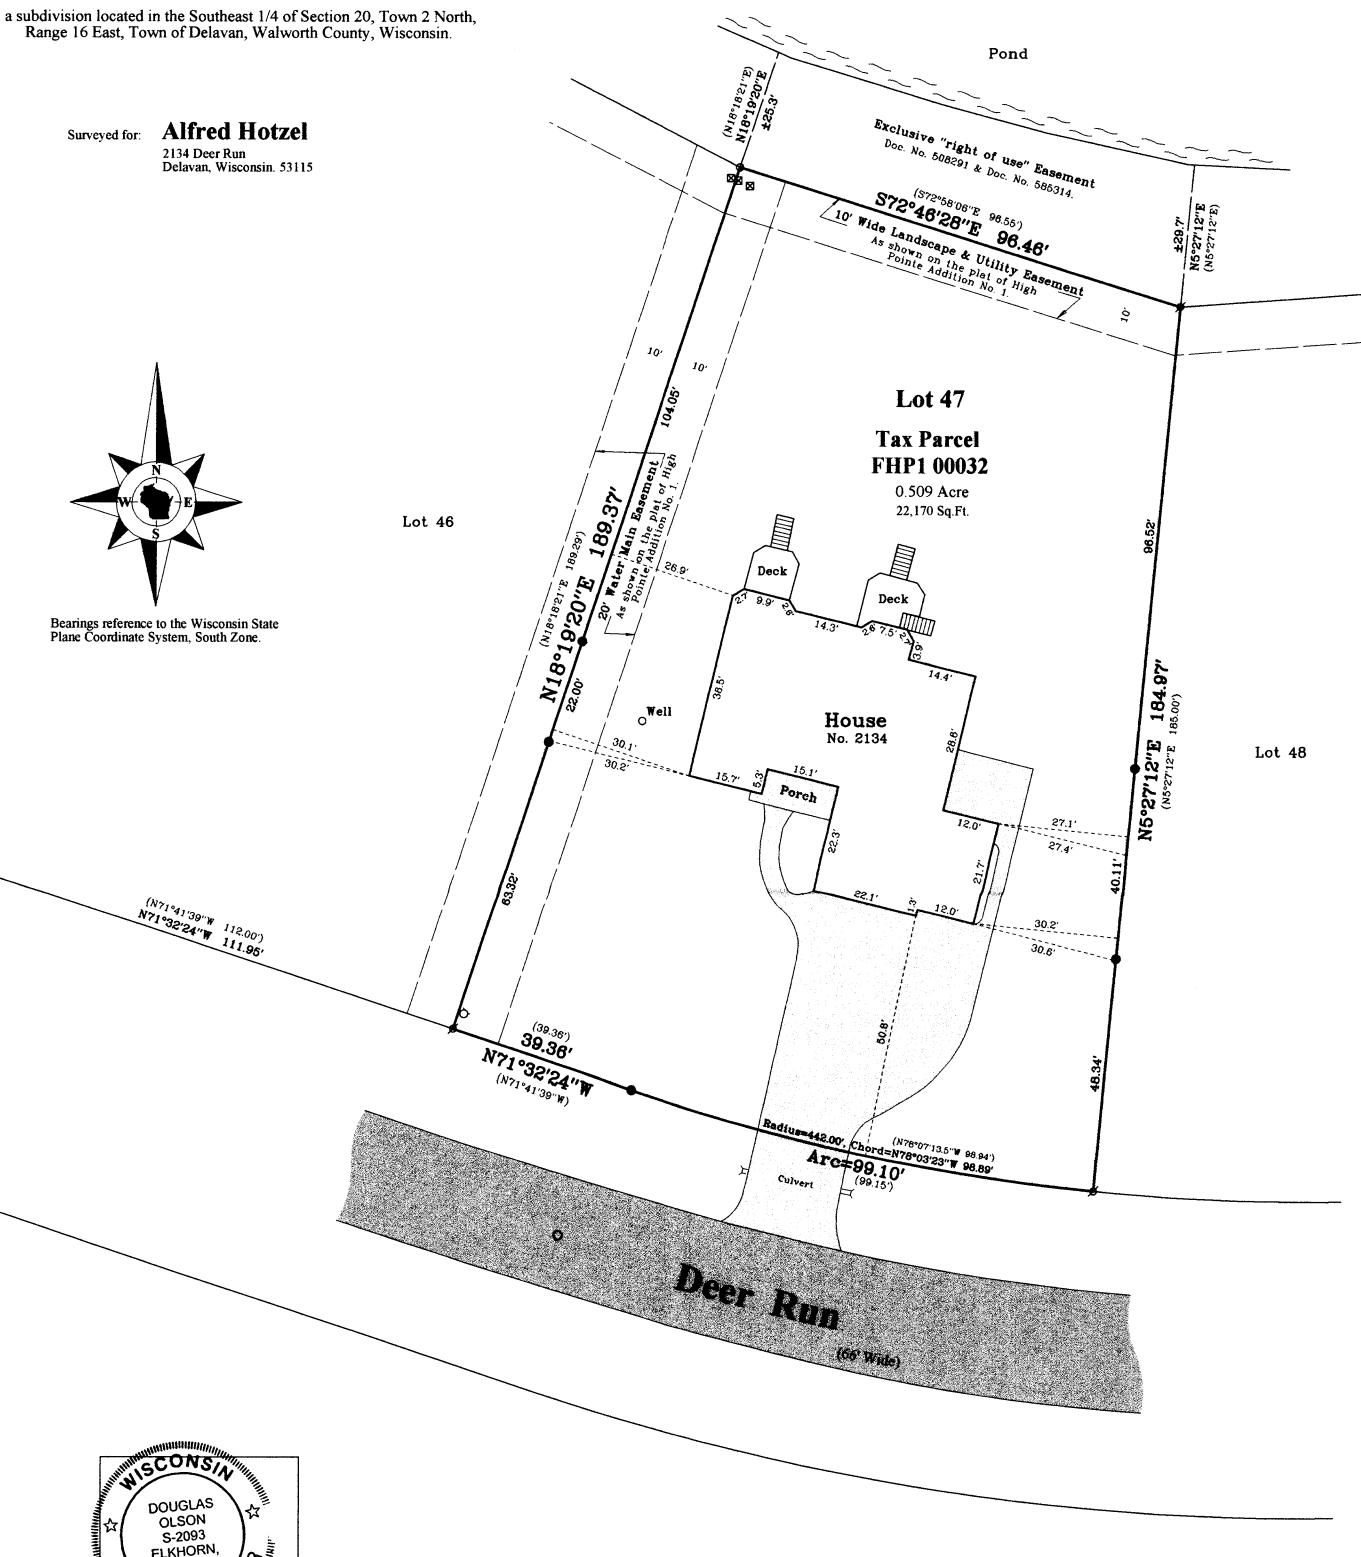

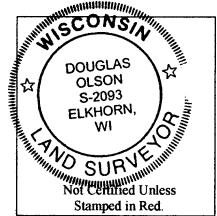

**Notes:** 

- 1) This survey plat is not certified unless signed and sealed in red ink.
- 2) This survey is subject to Wisconsin lien laws. This Plat of Survey is the notice of intent to file lien. Lien waiver required.



Copyright 2010 by Jensen & Olson Land Surveying, LLC.

216-4802

All rights reserved. No part of this survey plat may be reproduced or transmitted in any form by any means - graphic, electronic, or mechanical, including photocopying, tracing, or information storage and retrieval systems - without permission in writing from Douglas G. Olson, Jensen & Olson Land Surveying, LLC.

I, Douglas G. Olson, Wisconsin Registered Land Surveyor, do hereby certify that this survey was performed by me, or under my direction in full compliance with the owner's/agent's instructions and Chapter A-E 7 of the Wisconsin Administrative Code "Minimum Standards for Property Surveys"; and that this map is an accurate representation thereof to the best of my whedge and belief.

Douglas G. Olson Wisdonsin Registered Land Surveyor - 2093

FHP1-32


Sheet 1 of 1 Sheets

Drawing Name: t2nr16e-2010045-2010045Plat.scj Job Reference Number 2010.045

Legend

Jensen & Olson Land Surveying, LLC 45 South Wisconsin Street \* P.O. Box 322 \* Elkhorn, Wisconsin. 53121

Telephone: (262) 723-3434 \* Facsimile: (262) 723-8044 Email: jensen.olson@elknet.net

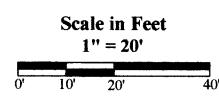

Survey Date: June 9, 2010. Revisions: No. 1 - Easement on