

PREPARED FOR
MICHAEL KLOSS
4321 EAST DR.
DELAVER, WI. 53115


PLAT OF SURVEY

-OF-

LOTS 21 AND 22 IN BLOCK 7 IN SOUTH SHORE MANOR, BEING A
SUBDIVISION LOCATED IN SECTION 32, TOWN 2 NORTH, RANGE
16 EAST, TOWN OF DELAVAN, WALWORTH COUNTY, WISCONSIN.

KROTT SURVEYING INC.


N3705 WILLOW BEND LANE
LAKE GENEVA, WI. 53147
PHONE # (262)248-3697
FAX # (262)249-0639

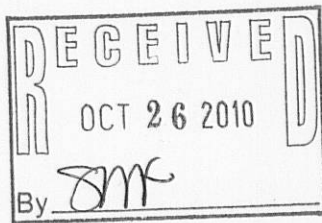


LEGEND

- FOUND IRON PIPE
- FOUND IRON BAR
- ⊗ WELL
- ⊗ UTILITY POLE
- E— OVERHEAD WIRES

(XX) RECORDED AS
TAX ID # FSS00096
JOB # 10-155

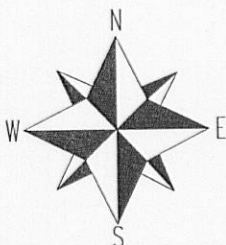


SCALE 1" = 20'

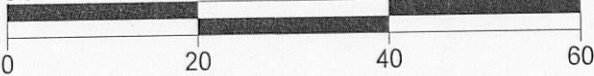

I have surveyed the above-described property and the above map is a true representation thereof and shows the size and location of the property, its exterior boundaries, the location and dimensions of all structures thereon, fences apparent easements and roadways and visible encroachments, if any.

This survey is made for the exclusive use of the present owners of the property, and also those who purchase, mortgage, or insure the title thereto within one (1) year from date hereof; and as to them I warrant the accuracy of said survey map.

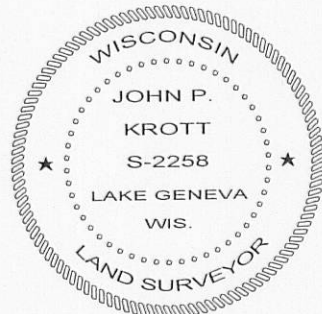

DATED THIS 21st DAY OF SEPTEMBER 2010.

John P. Krott

JOHN KROTT S - 2258
Wisconsin Registered Land Surveyor
(original if signed in red)

2112-4814