



PREPARED FOR:  
RYAN SIMONS  
KEEFE REAL ESTATE

PLAT OF SURVEY

PATHFINDER SURVEYING INC.  
(formerly)  
J.K. SURVEYING INC.  
P.O. BOX 322  
LAKE GENEVA, WI.  
262-248-8303


- OF -

LOT 19 OF WOODLAND SHORES SUBDIVISION, LOCATED IN TOWN 2  
NORTH, RANGE 16 EAST OF THE FOURTH PRINCIPAL MERIDIAN, TOWN  
OF DELAVAN, COUNTY OF WALWORTH COUNTY, STATE OF WISCONSIN

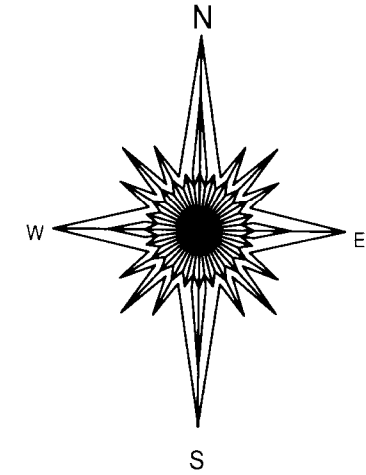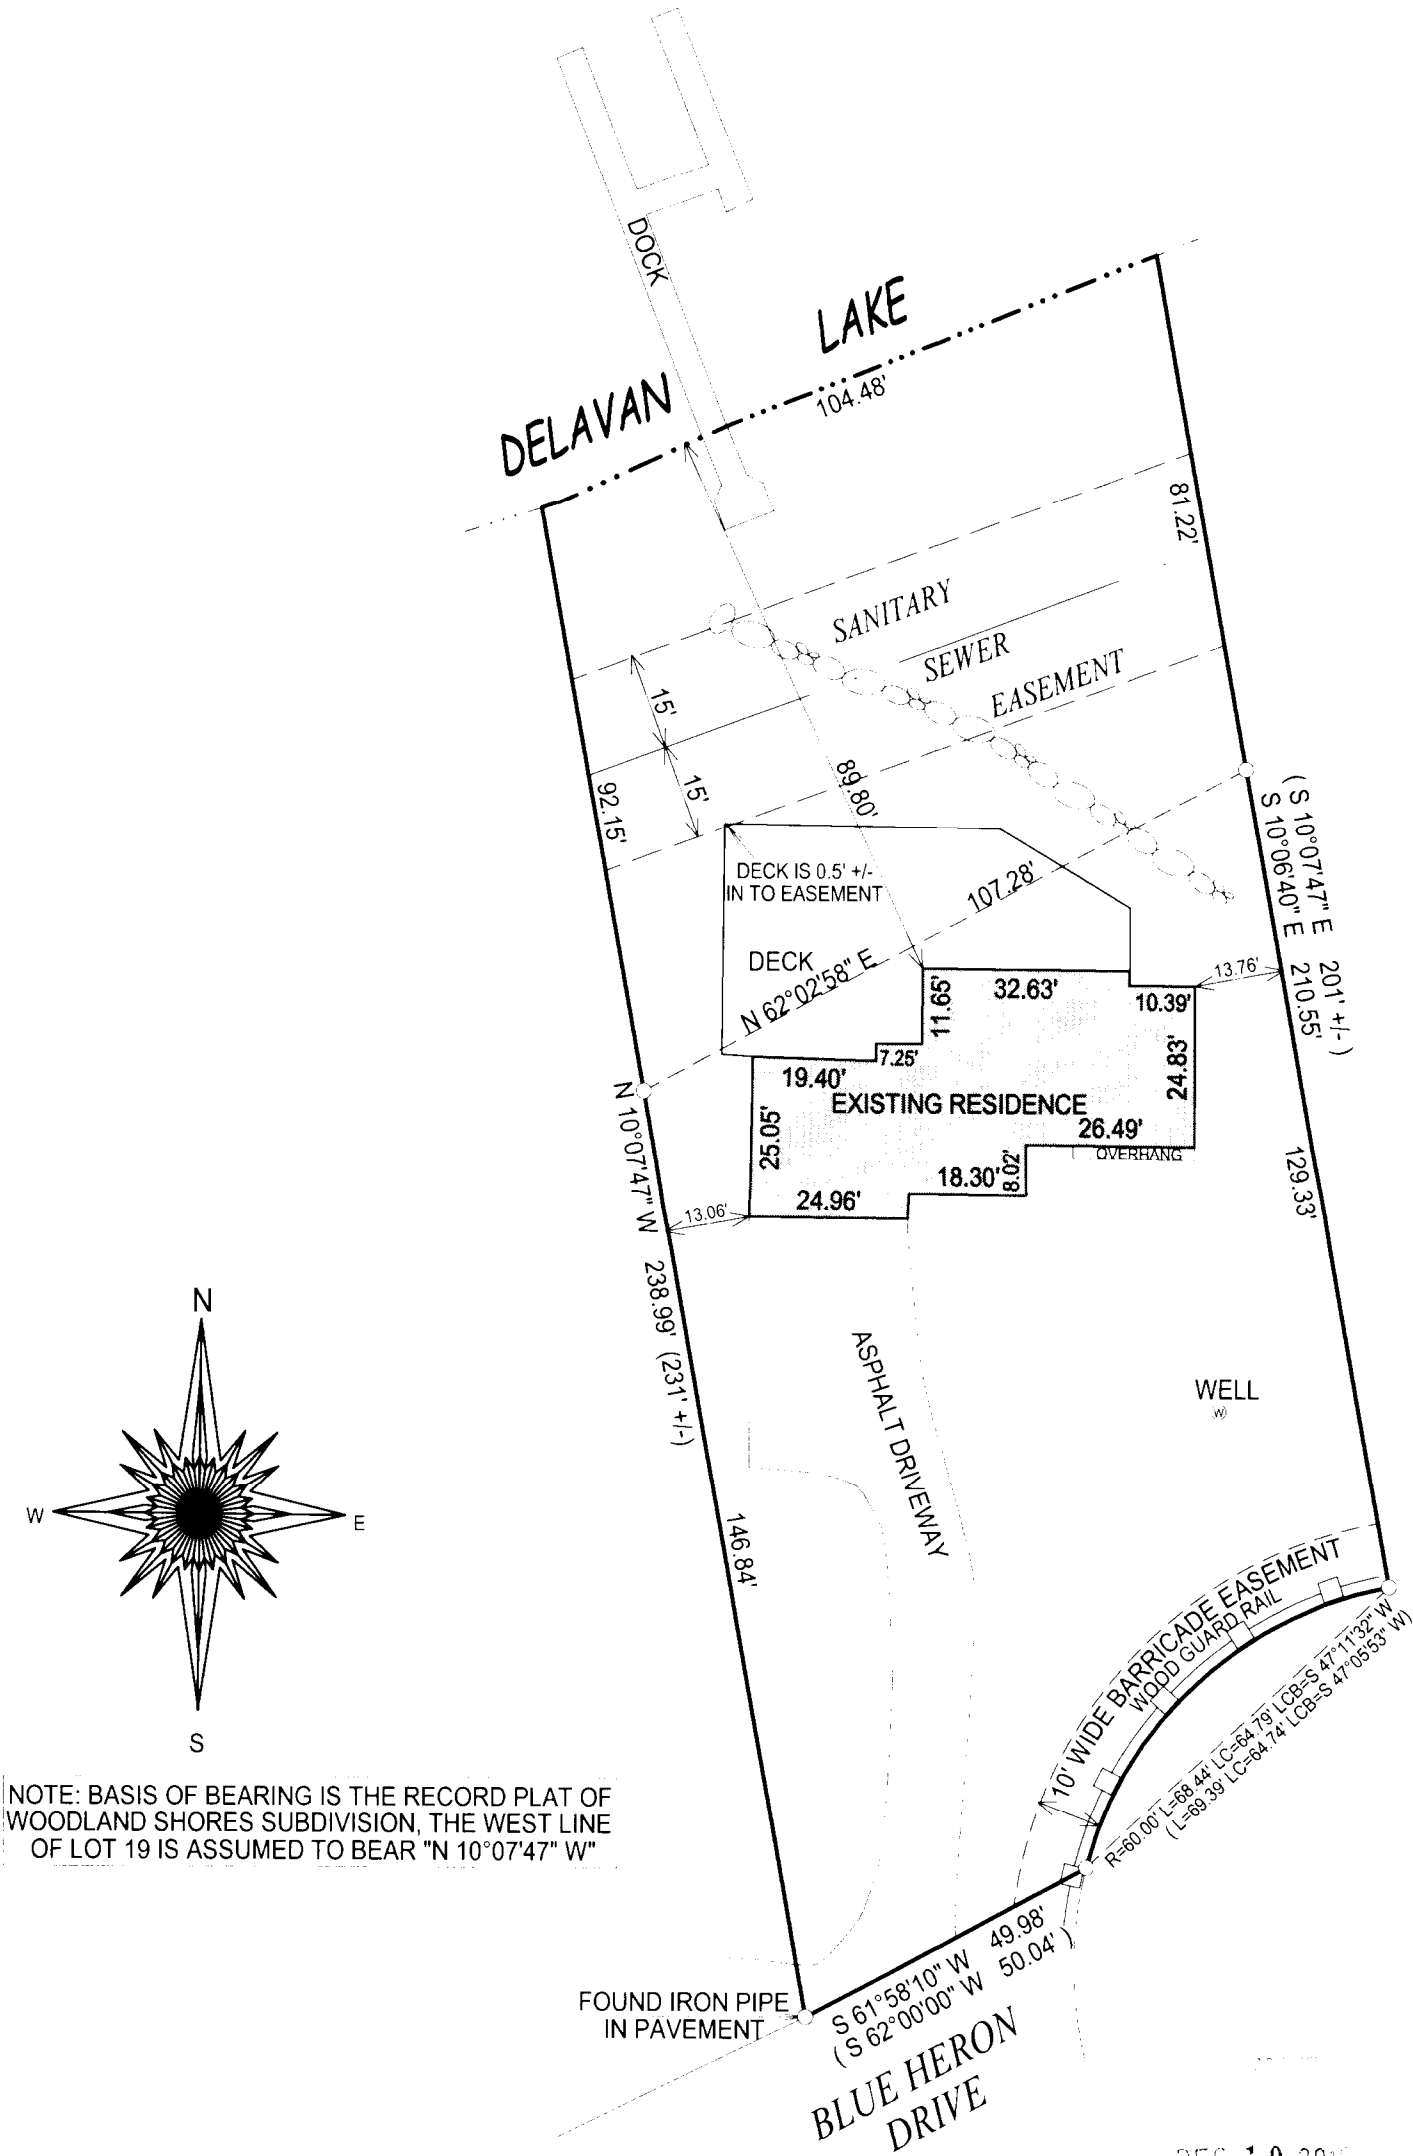

NOTE: BASIS OF BEARING IS THE RECORD PLAT OF  
WOODLAND SHORES SUBDIVISION, THE WEST LINE  
OF LOT 19 IS ASSUMED TO BEAR "N 10°07'47" W"

- ( ) = recorded as
- = found iron bar
- = found iron pipe
- = set iron pipe
- = set iron bar

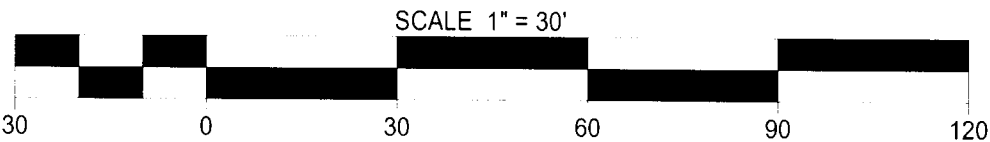

"I hereby certify that I have surveyed the above described property and that the above map is a true representation of its exterior boundary and shows the size and location of all visible structures, apparent easements and encroachments if any."

This survey is made for the present owners of the property, and those who purchase, mortgage, or guarantee the title thereto, within one year from the date hereof.

JOB # 10-175

TAX ID # FWLS 00019

DATED THIS 7th, DAY OF DECEMBER, 2010.

DEC 10 2010

*JK*



*Jeffrey L. Kimps*

JEFFREY L. KIMPS S - 2436  
Wisconsin Registered Land Surveyor  
(original if signed in red)