PREPARED FOR: HIBL'S REAL ESTATE 1034 B ANN ST. DELAVAN, WI 53115


PLAT OF SURVEY

OF-

LOT 219 IN LAKE DELAVAN HIGHLANDS, BEING A SUBDIVISION OF THE SOUTH 1/2 OF THE SOUTHEAST 1/4 OF SECTION 31, TOWNSHIP 2 NORTH, RANGE 16 EAST, TOWN OF DELAVAN, WALWORTH COUTNY, WISCONSIN.

KROTT SUR VEYING INC.

N3705 WILLOW BEND LANE
LAKE GENEVA WI. 53147
PHONE # (262)248-3697
FAX # (262)249-0639

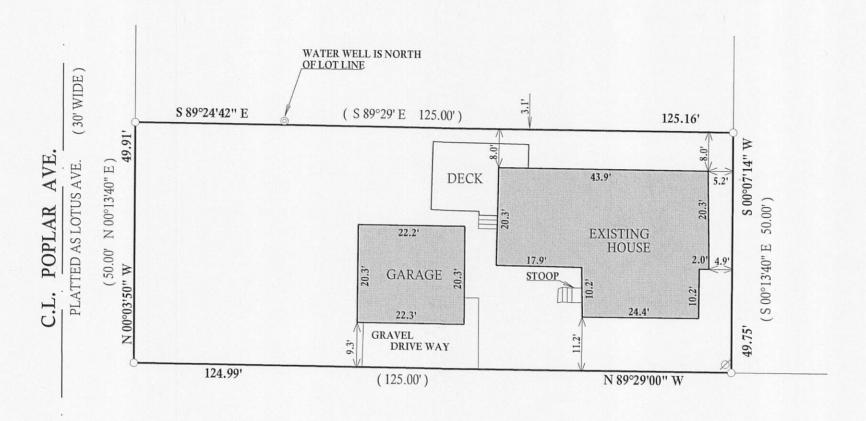

LEGEND

Ø UTILITY POLE

O FOUND IRON PIPE

☐ FOUND IRON BAR

■ SET IRON BAR

(XX) RECORDED AS

JOB #11-058

TAXID # FLAD00165


C.L. SOUTH SHORE DRIVE


(66' WIDE)


BEARINGS REFERENCED TO THE RECORD PLAT OF LAKE DELAVAN HIGHLANDS

I have surveyed the above-described property and the above map is a true representation thereof and shows the size and location of the property, its exterior boundaries, the location and dimensions of all structures thereon, fences apparent easements and roadways and visible encroachments. if any.

This survey is made for the exclusive use of the present owners of the property, and also those who puchase, mortgage, or insure the title therto within one (1) year from date hereof; and as to them I warrant the accuracy of said survey map.

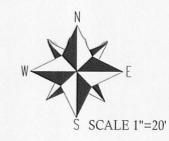

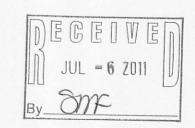

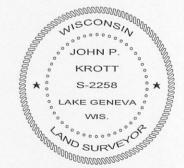

DATED THIS 28th, DAY OF APRIL, 2011

JOHN KROTT S 2258

JOHN KROTT S - 2258 Wisconsin Registered Land Surveyor (original if signed in red)