


PLAT OF SURVEY
LOT 5 AND THE NORTHEASTERLY 25 FEET OF LOT 6
MEACHAMS PARK
PART OF THE FRACTIONAL SECTION 22
TOWN 2 NORTH, RANGE 16 EAST
WALWORTH COUNTY, WISCONSIN

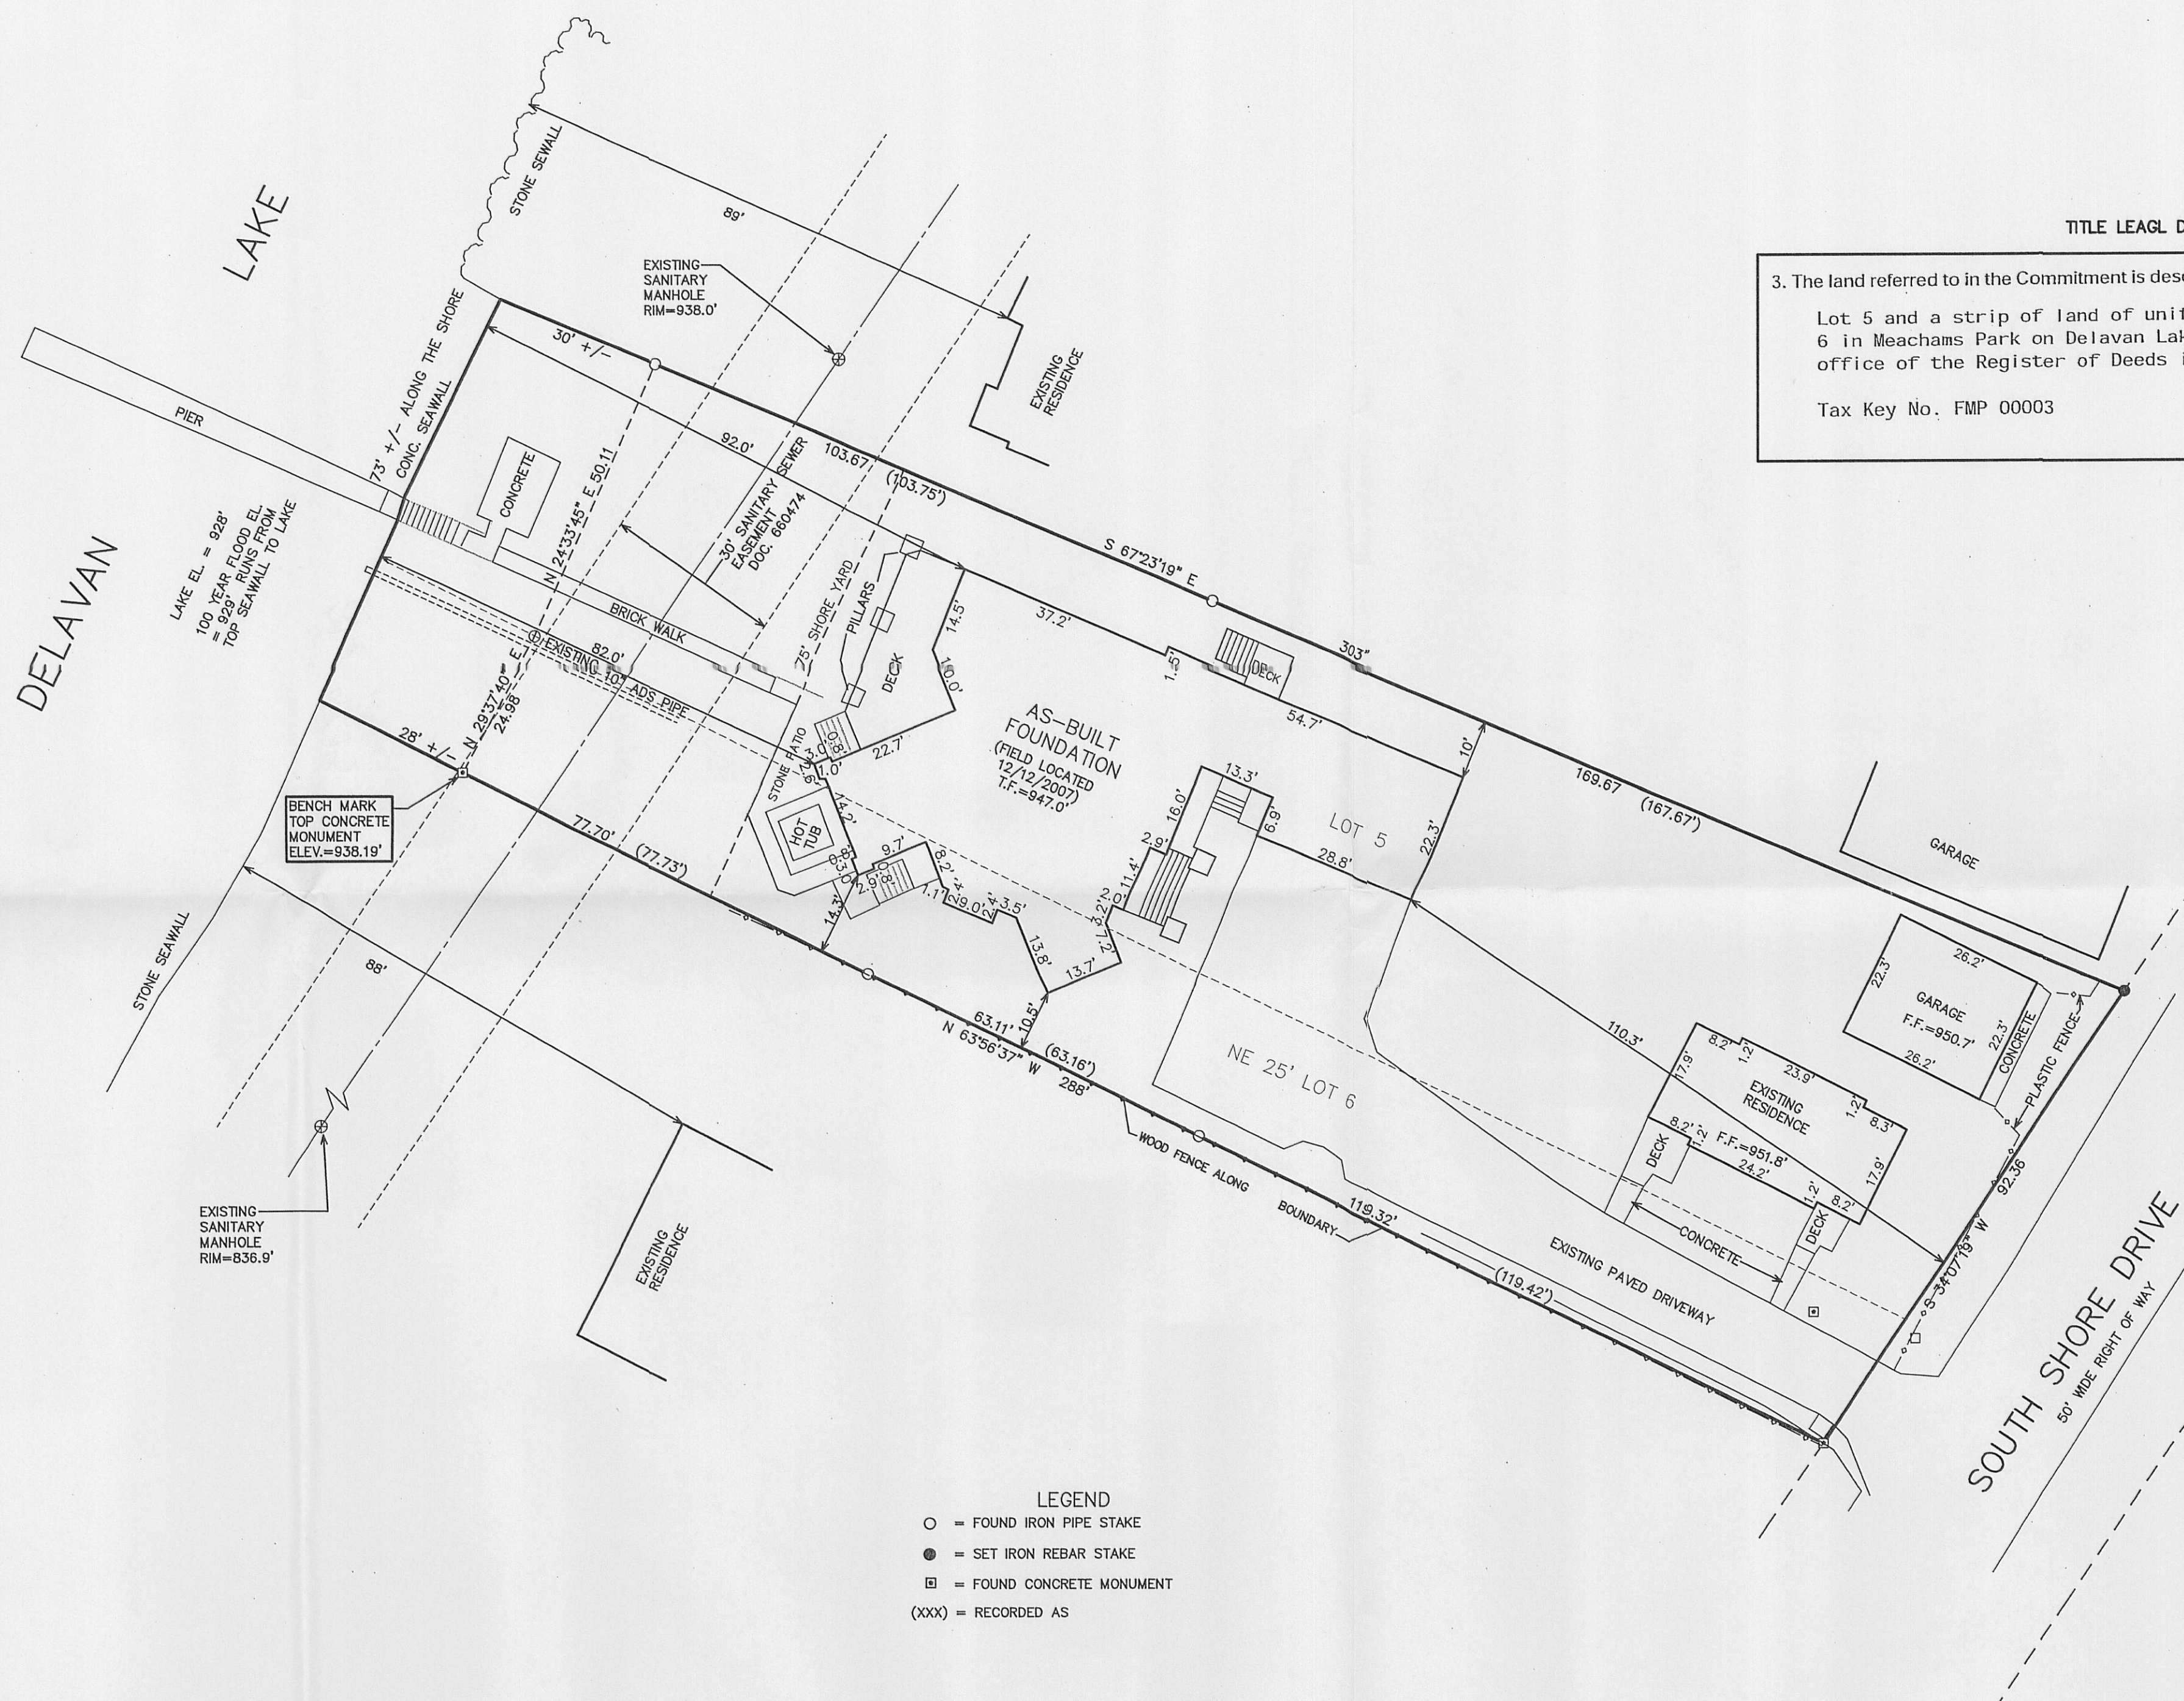


TITLE LEAGL DESCRIPTION

3. The land referred to in the Commitment is described as follows:

Lot 5 and a strip of land of uniform width of 25 feet off the Northerly side of Lot 6 in Meachams Park on Delavan Lake, according to the Plat thereof of record in the office of the Register of Deeds in and for Walworth County, Wisconsin.


Tax Key No. FMP 00003

LEGEND
○ = FOUND IRON PIPE STAKE
● = SET IRON REBAR STAKE
■ = FOUND CONCRETE MONUMENT
(XXX) = RECORDED AS

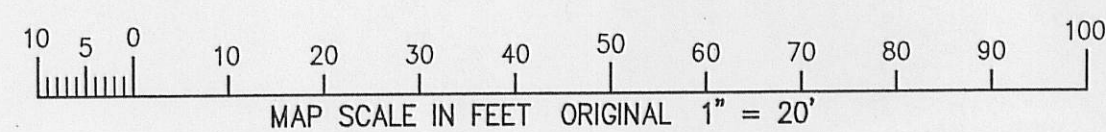

NOTE: COPIES OF THIS MAP TO WHICH THE FOLLOWING CERTIFICATE WILL APPLY SHOW SURVEYOR'S ORIGINAL SEAL AND SIGNATURE IN RED INK. COPIES BY ANY OTHER MEANS MAY HAVE ALTERATIONS WHICH DO NOT REPRESENT THE SURVEYOR'S WORK PRODUCT.



I HEREBY CERTIFY THAT THE ABOVE DESCRIBED PROPERTY HAS BEEN SURVEYED UNDER MY DIRECTION AND THAT THE ABOVE MAP IS A TRUE REPRESENTATION THEREOF AND SHOWS THE SIZE AND LOCATION OF THE PROPERTY, ITS EXTERIOR BOUNDARIES, THE LOCATION OF ALL VISIBLE STRUCTURES, AND DIMENSIONS OF ALL PRINCIPLE BUILDINGS THEREON, BOUNDARY FENCES, APPARENT EASEMENTS, ROADWAYS, AND VISIBLE ENCROACHMENTS, IF ANY. THIS SURVEY IS MADE FOR THE USE OF THE PRESENT OWNERS OF THE PROPERTY, AND ALSO THOSE WHO PURCHASE, MORTGAGE, OR GUARANTEE THE TITLE THERETO WITHIN ONE YEAR FROM THE DATE HEREOF.

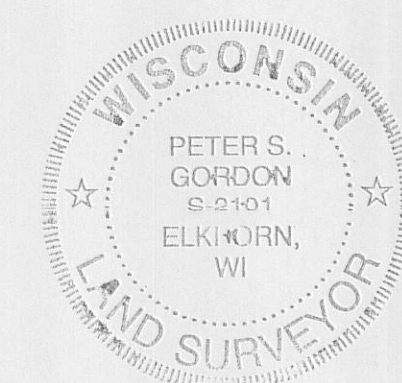

DATED: OCTOBER 20, 2010

REVISED 08-11-2011 TO SHOW STONE PATIO & BRICK WALK

PETER S. GORDON R.L.S. 2101

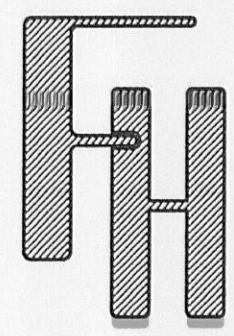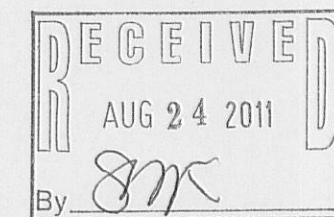

WORK ORDERED BY:
SCOTT STONEBREAKER
5 N579 CREEKVIEW LANE
ST. CHARLES, IL 60175

FARRIS, HANSEN & ASSOCIATES, INC.
ENGINEERING - ARCHITECTURE - SURVEYING
7 RIDGWAY COURT P.O. BOX 437
ELKHORN, WISCONSIN 53121
OFFICE: (262) 723-2098 FAX: (262) 723-5996

REVISIONS

PROJECT NO.
7371
DATE
10-26-2010
SHEET NO.
1 OF 1