

Plat of Survey


of

Lot 8 in Block 1 of Woodlawn Bay Community,

a subdivision located in Government Lot 1 in the Northeast 1/4 of Section 28,
Town 2 North, Range 16 East, Town of Delavan, Walworth County, Wisconsin.

Surveyed for: **Shorewest Realtors**
830 East Geneva Street
Delavan, Wisconsin. 53115

Survey Date: June 22, 2011.
Revisions:

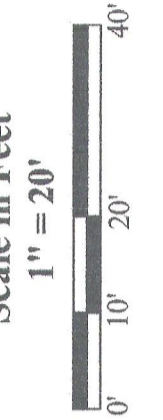


Jensen & Olson Land Surveying, LLC
45 South Wisconsin Street * P.O. Box 322 * Elkhorn, Wisconsin. 53121
Telephone: (262) 723-3434 * Facsimile: (262) 723-8044
Email: jensen.olson@elknet.net


Legend
 Found Concrete Monument
 Found Iron Pipe
 Recorded Information
 Utility Pole
 Utility Pedestal
 Asphalt Surface
 Concrete Surface

Sheet 1 of 1 Sheets
Drawing Name: Chri(6-2011062-2011062)Plat.sjg
Job Reference Number
2011.062

2011.062

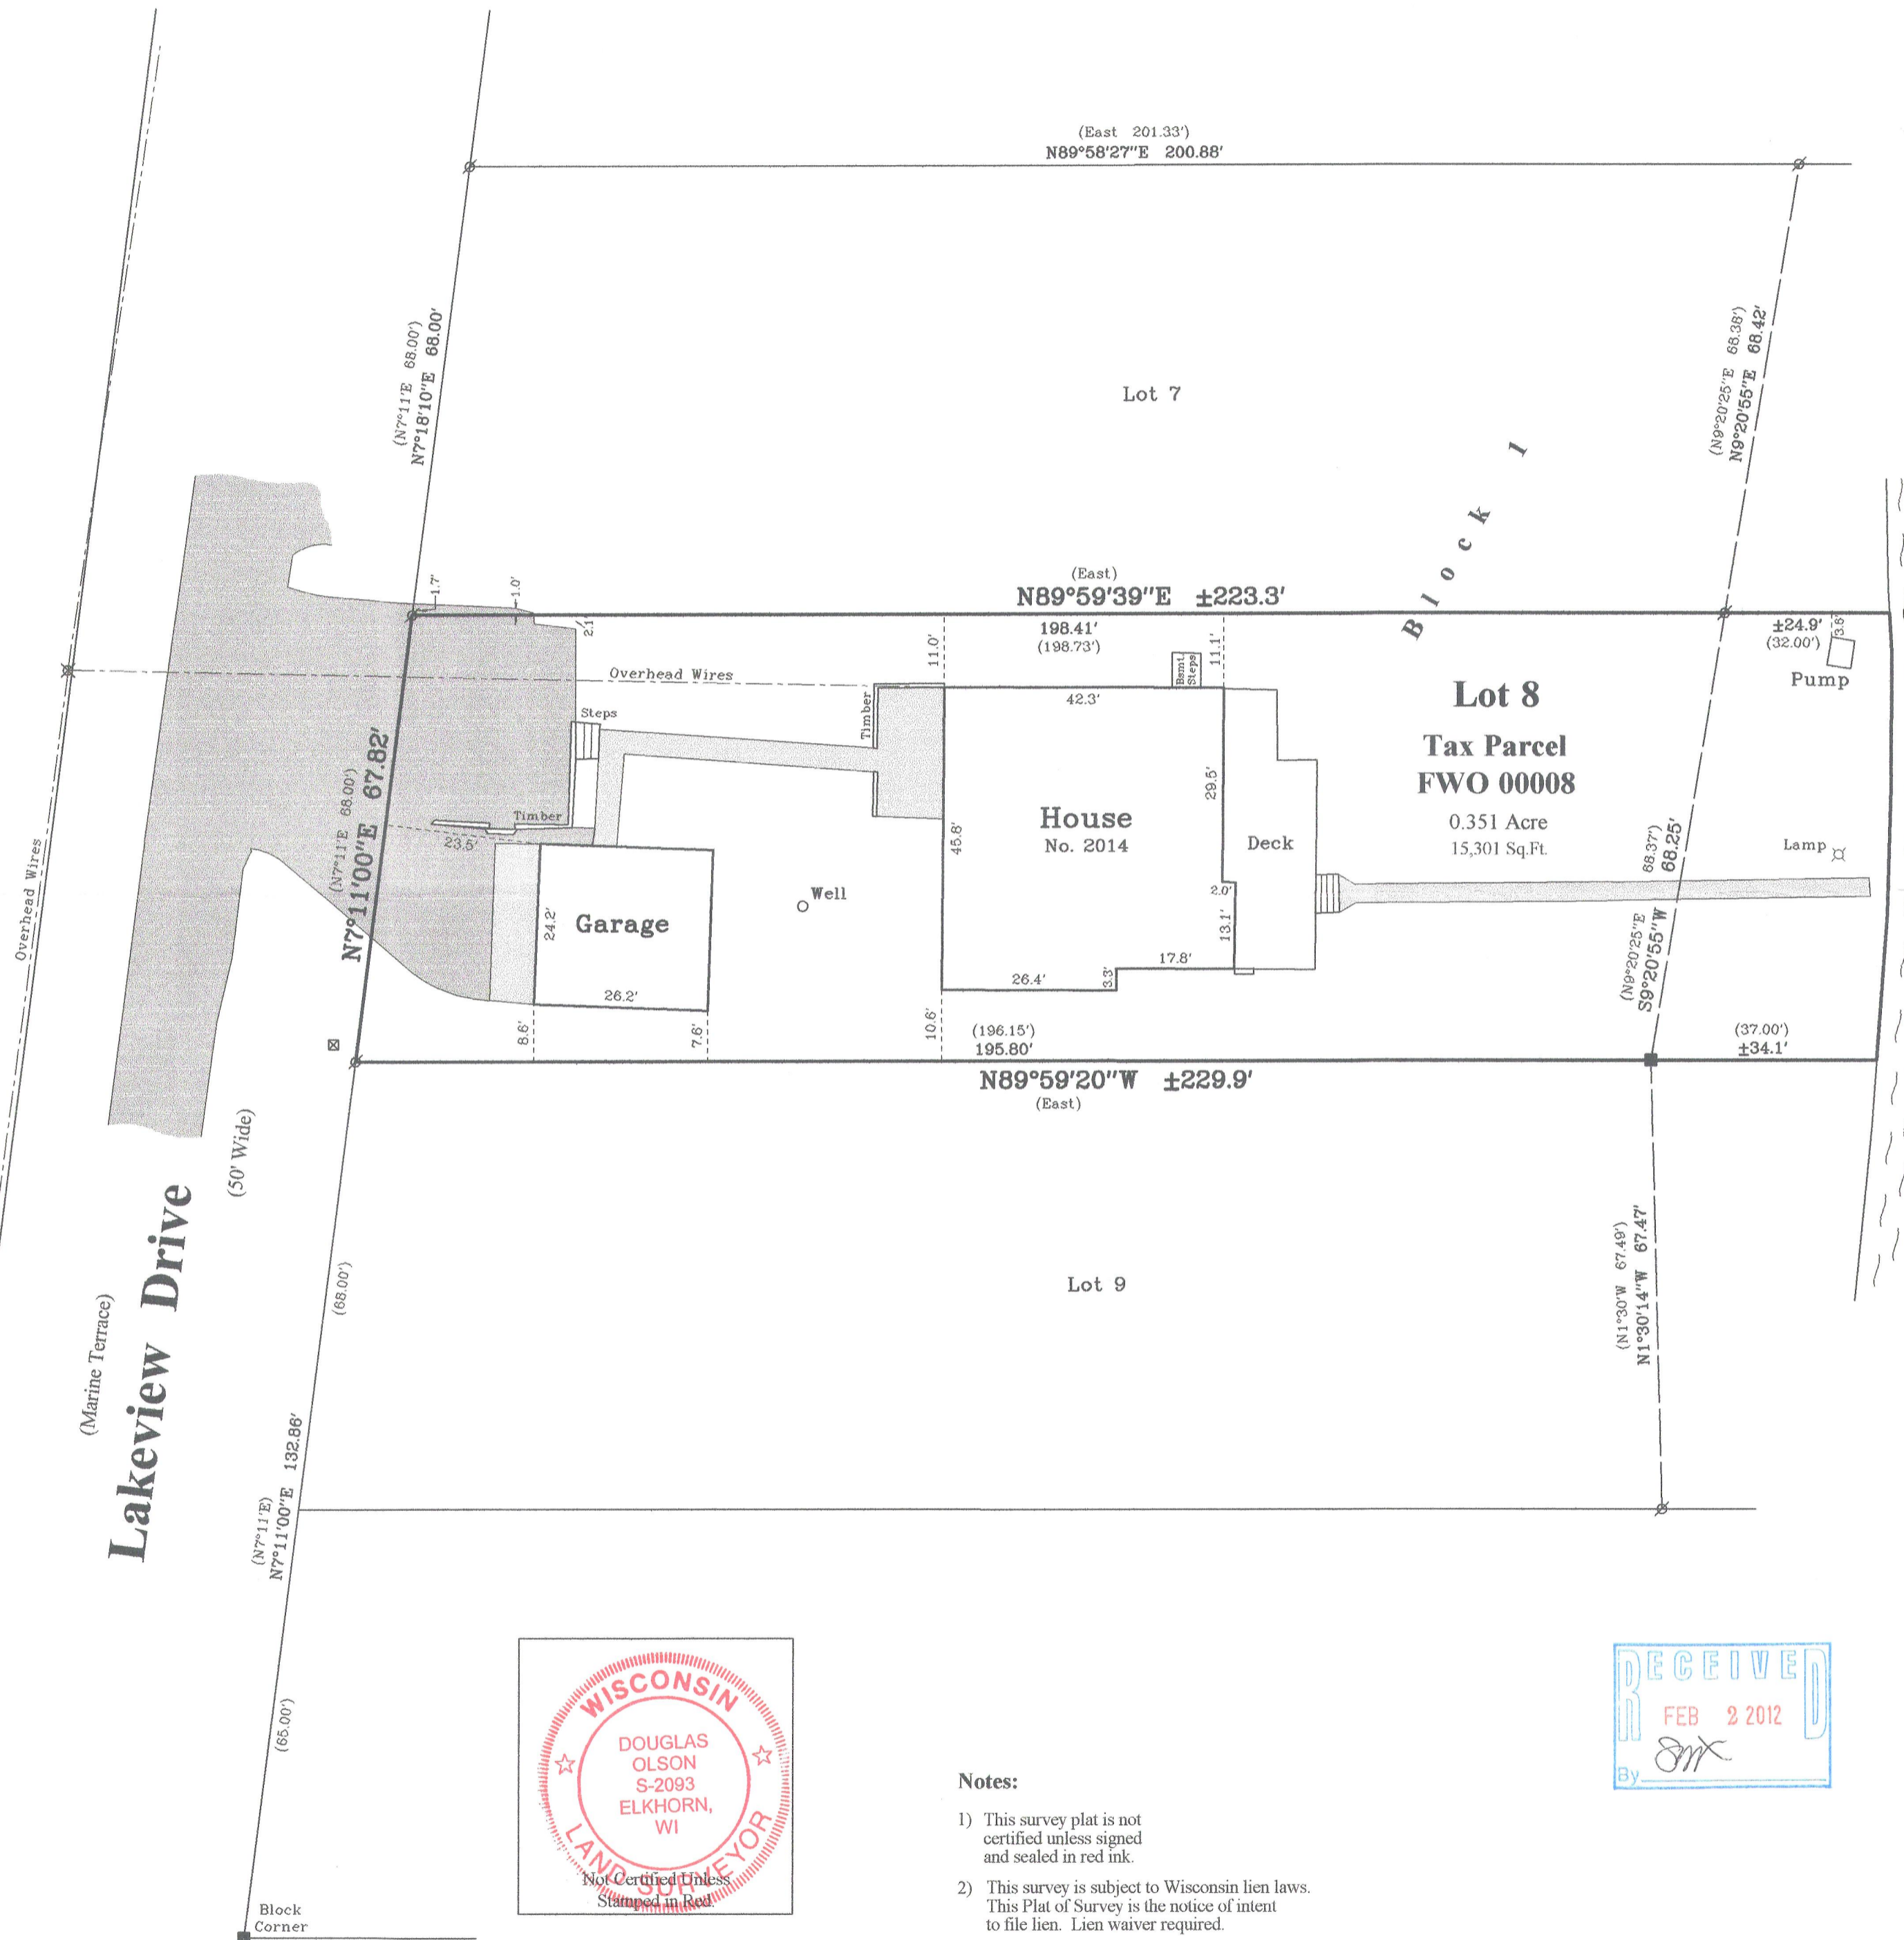

Delavan Lake

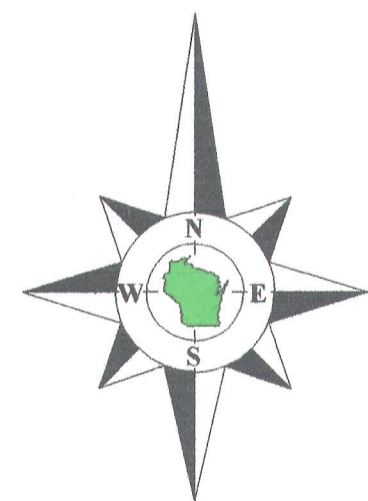

Bearings reference to the plat of Woodlawn Bay Community.

Copyright 2011 by Jensen & Olson Land Surveying, LLC.

All rights reserved. No part of this survey plat may be reproduced or transmitted in any form by any means - graphic, electronic, or mechanical, including photocopying, tracing, or information storage and retrieval systems - without permission in writing from Douglas G. Olson, Jensen & Olson Land Surveying, LLC.

I hereby certify that I have surveyed the above described property and the map hereon is correct to the best of my professional knowledge and belief and shows the size and location of the property, its exterior boundaries, the location and dimensions of all visible structures thereon, boundary fences, apparent easements and roadways and visible encroachments, if any.


This survey is made for the exclusive use of the present owners of the property, and also those who purchase, mortgage or guarantee title thereto, within one year from the date hereof.

Douglas G. Olson
Wisconsin Registered Land Surveyor - 2093



Notes:

- 1) This survey plat is not certified unless signed and sealed in red ink.
- 2) This survey is subject to Wisconsin lien laws. This Plat of Survey is the notice of intent to file lien. Lien waiver required.

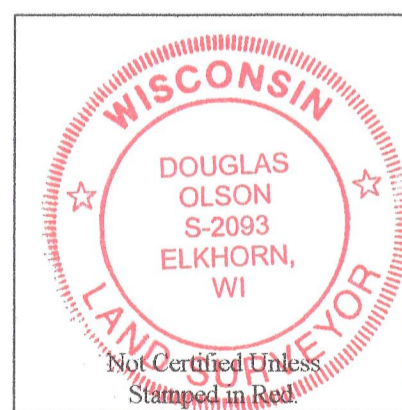

FWO-8

216-4912