


North 1/4 Corner
Section 28-2-16.
N. 225,921.05
E. 2,374,287.09

West line of the Northeast 1/4 of Section 28-2-16.
S0°59'43"E 1784.88'
(S0°59'43"E 1784.93') State Plane

Witness Corner
Section 28-2-16.
N. 224,136.42
E. 2,374,318.09

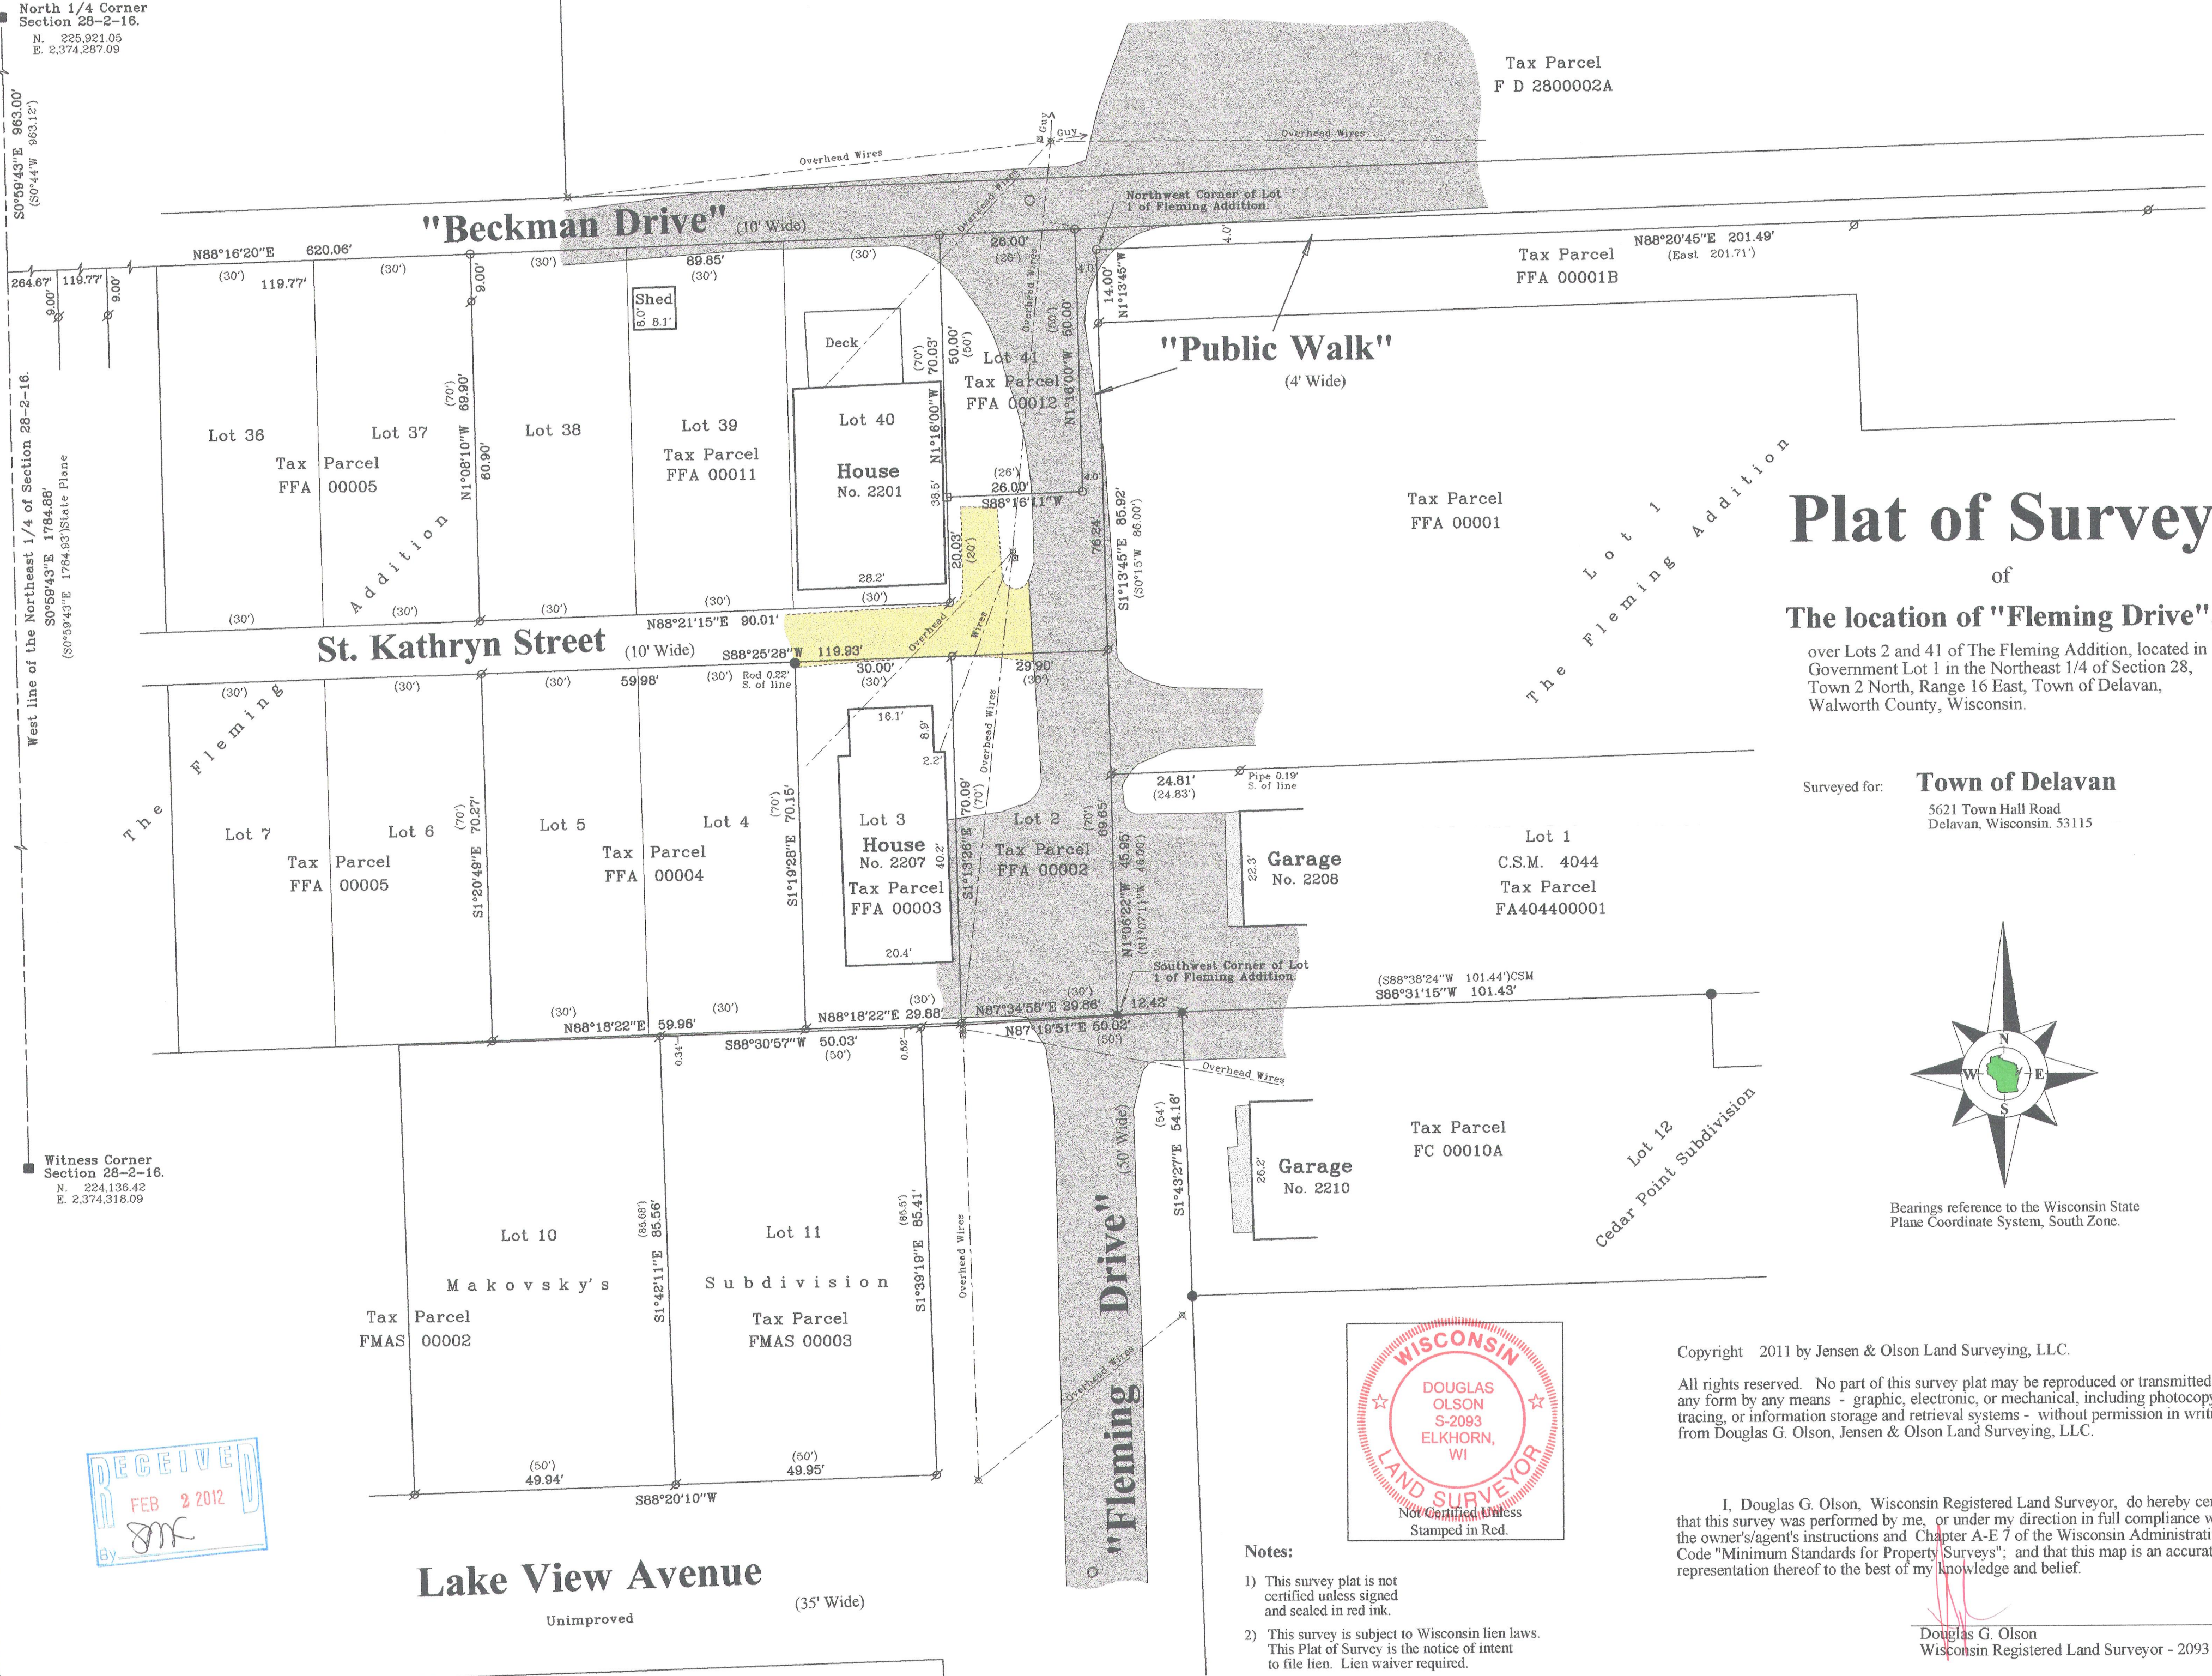

Tax Parcel
F D 2800002A

Tax Parcel
FFA 00001B
N88°20'45"E 201.49'
(East 201.71')

Tax Parcel
FFA 00001


St. Kathryn Street
(10' Wide)

"Public Walk"
(4' Wide)


Plat of Survey

of
The location of "Fleming Drive",
over Lots 2 and 41 of The Fleming Addition, located in
Government Lot 1 in the Northeast 1/4 of Section 28,
Town 2 North, Range 16 East, Town of Delavan,
Walworth County, Wisconsin.

Surveyed for: **Town of Delavan**
5621 Town Hall Road
Delavan, Wisconsin. 53115

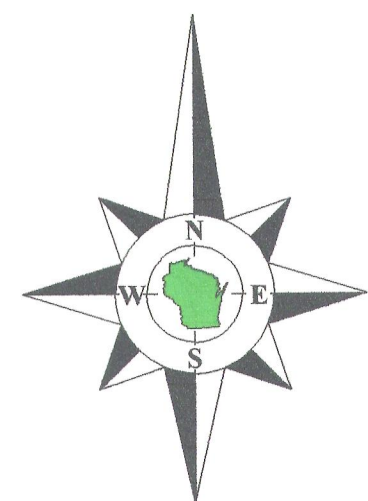

Bearings reference to the Wisconsin State
Plane Coordinate System, South Zone.

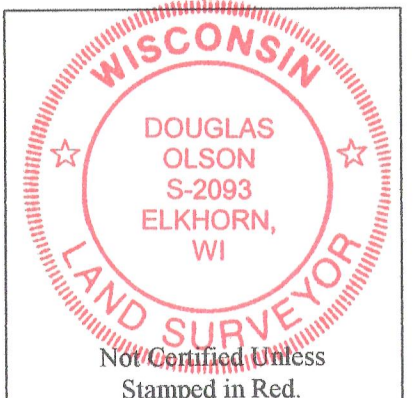

- Notes:**
- 1) This survey plat is not certified unless signed and sealed in red ink.
 - 2) This survey is subject to Wisconsin lien laws. This Plat of Survey is the notice of intent to file lien. Lien waiver required.


Copyright 2011 by Jensen & Olson Land Surveying, LLC.

All rights reserved. No part of this survey plat may be reproduced or transmitted in any form by any means - graphic, electronic, or mechanical, including photocopying, tracing, or information storage and retrieval systems - without permission in writing from Douglas G. Olson, Jensen & Olson Land Surveying, LLC.

I, Douglas G. Olson, Wisconsin Registered Land Surveyor, do hereby certify that this survey was performed by me, or under my direction in full compliance with the owner's/agent's instructions and Chapter A-E 7 of the Wisconsin Administrative Code "Minimum Standards for Property Surveys"; and that this map is an accurate representation thereof to the best of my knowledge and belief.

Douglas G. Olson
Wisconsin Registered Land Surveyor - 2093

Survey Date: May 19, 2011.
Revisions:

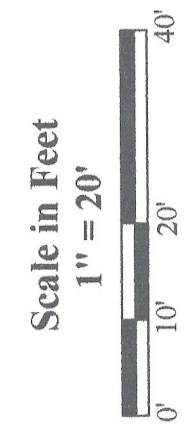


Jensen & Olson Land Surveying, LLC
45 South Wisconsin Street * P.O. Box 322 * Elkhorn, Wisconsin. 53121
Telephone: (262) 723-3434 * Facsimile: (262) 723-8044
Email: jensen.olson@elknet.net

- Legend**
- Found County Section Corner
 - Found Iron Pipe
 - Found Spindle
 - Set Iron Rod
 - Set Mag Nail
 - Recorded Information
 - Utility Pedestal
 - Manhole
 - Gravel Surface
 - Concrete Surface

Sheet 1 of 1 Sheets
Drawing Name: C:\p\2010122-2010122\p1a.sj
Job Reference Number
2010.122

2010.122

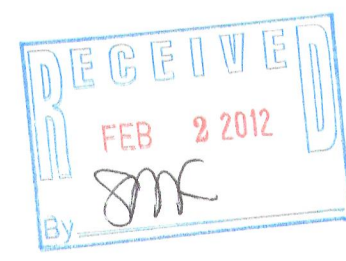

FFA-11 FFA-3 FFA-1 FA4044-1 FC-10A

216-4913