



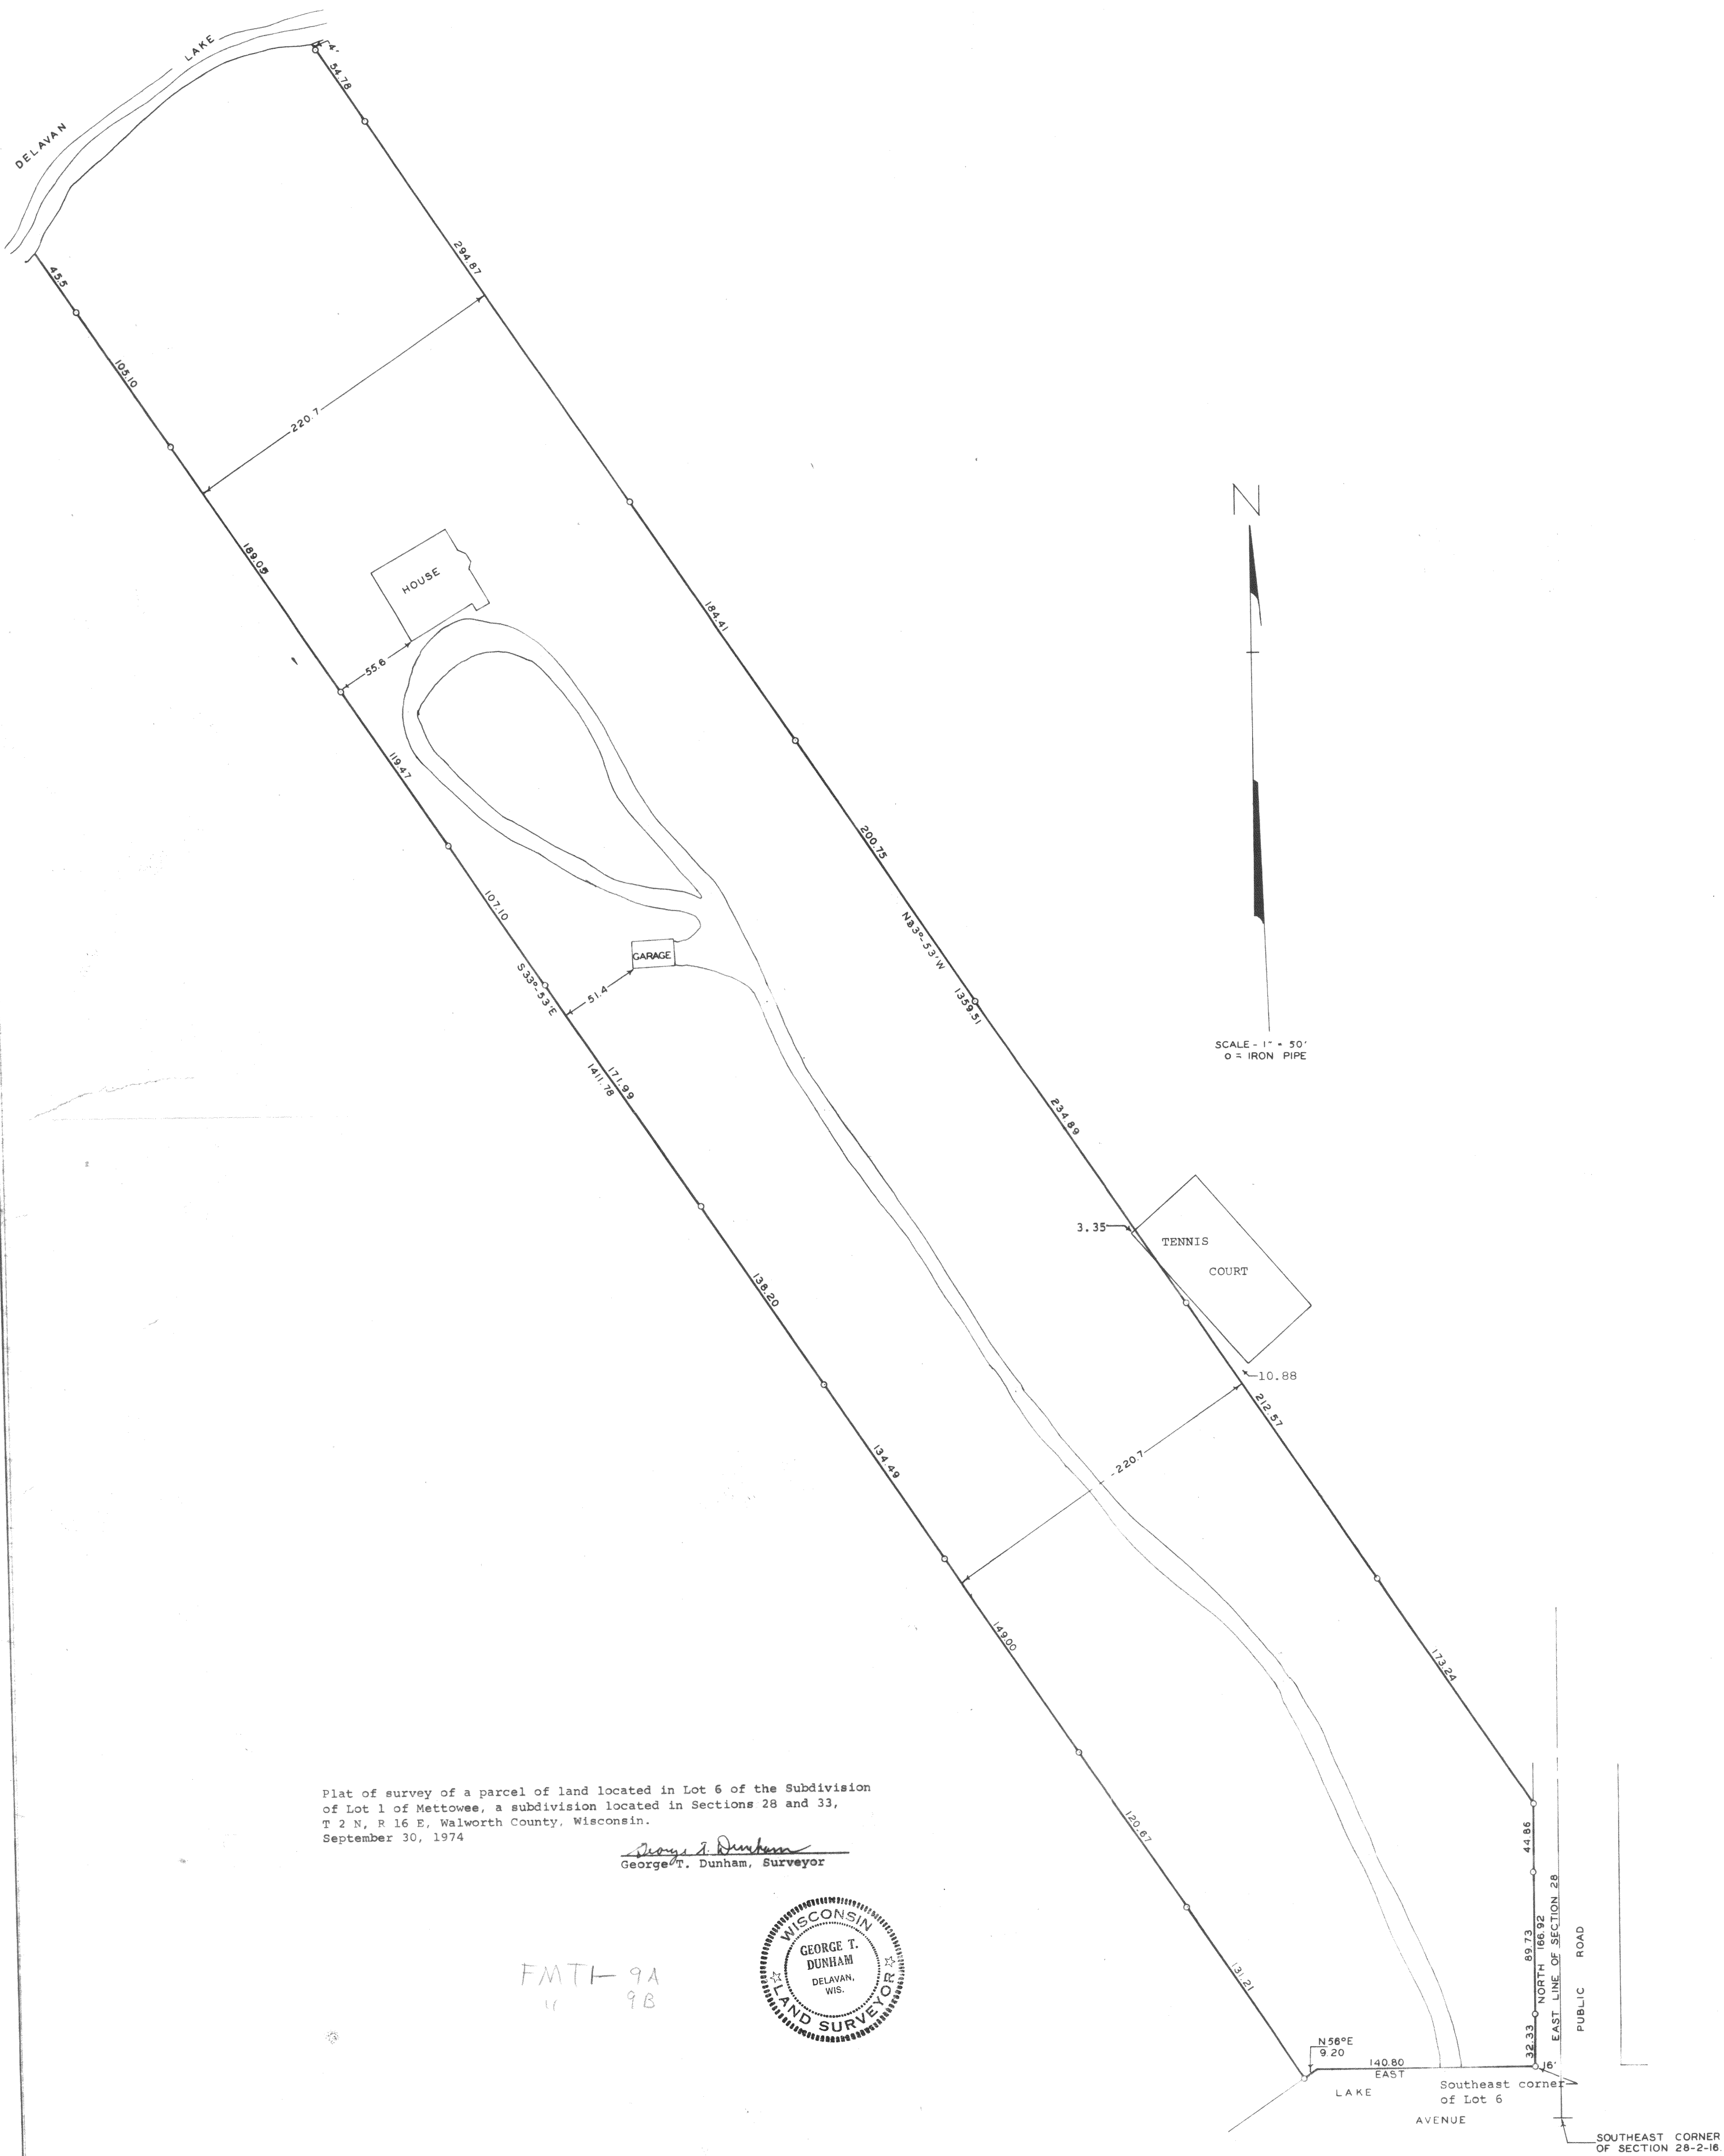

Plat of survey of a parcel of land located in Lot 6 of the Subdivision of Lot 1 of Mettowee, a subdivision located in Sections 28 and 33, T 2 N, R 16 E, Walworth County, Wisconsin. September 30, 1974

George T. Dunham
George T. Dunham, Surveyor

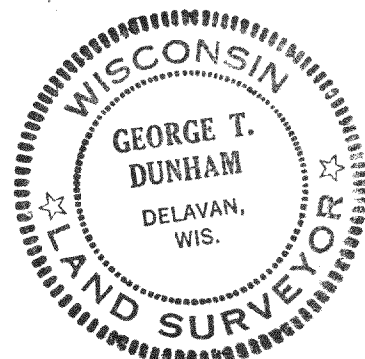

FMT-9A
9B

216-492