


# PLAT OF SURVEY -OF-

LOT 13, BLOCK 2, INLET OAKS SUBDIVISION NO. 3, BEING IN THE SOUTHEAST 1/4 OF SECTION 15 AND THE NORTHEAST 1/4 OF SECTION 22, TOWN 2 NORTH, RANGE 16 EAST, TOWN OF DELAVAN, WALWORTH COUNTY, WISCONSIN.


SURVEY FOR: JEREMY LARSON

SURVEY ADDRESS: 316 FIRST STREET

Chain link fence running east is 0.5' east of west property line and 0.6' south of north property line. Chain link fence running west is 0.1' north of north property line.

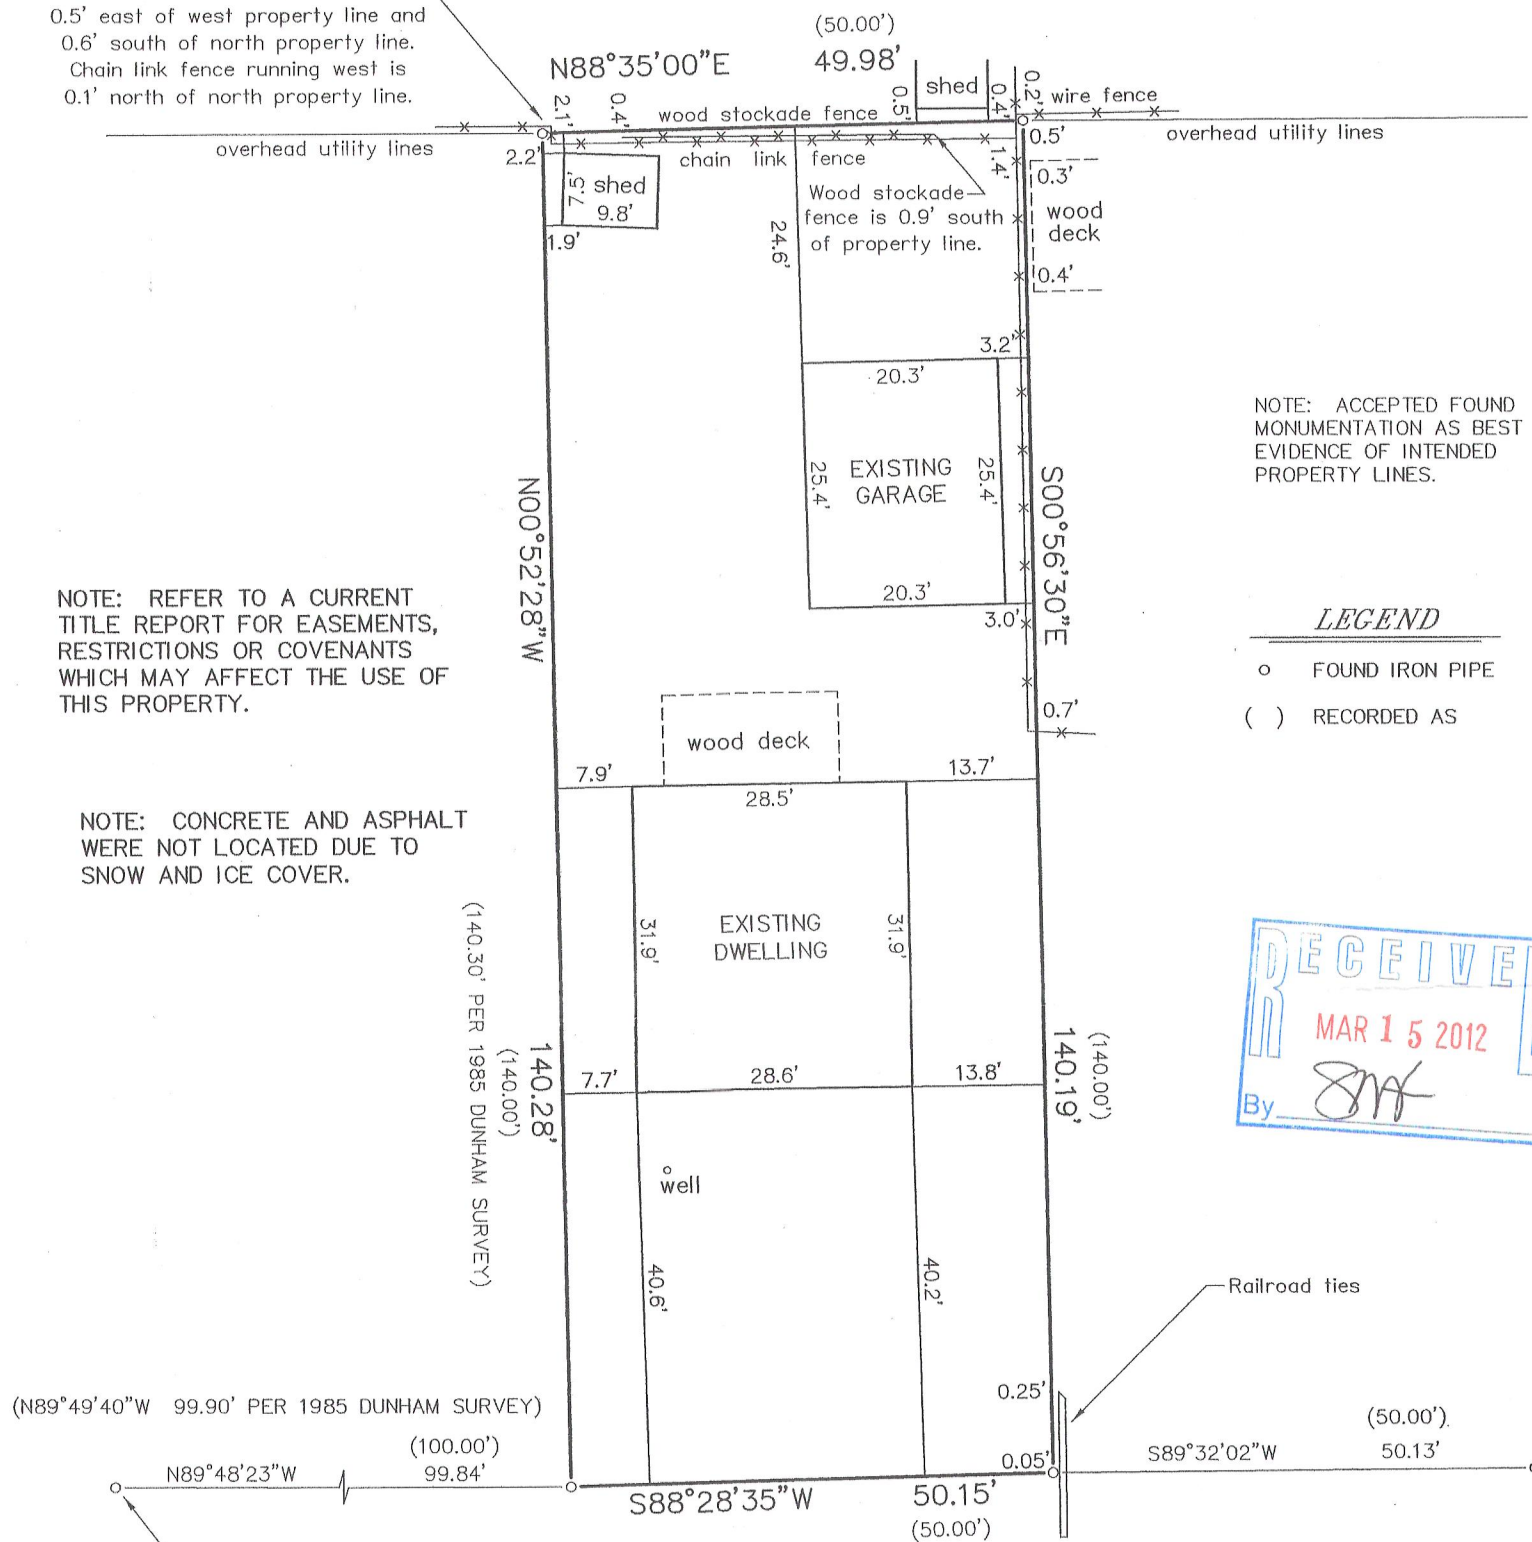

**FIRST STREET** (40' WIDE)

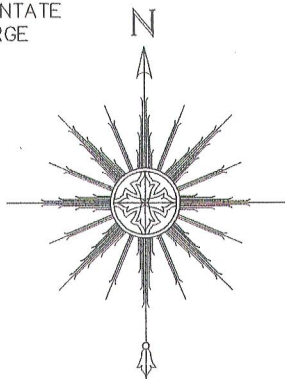

THIS IS NOT AN ORIGINAL PRINT  
UNLESS THIS SEAL IS RED.

*Thomas L. Satter*  
THOMAS L. SATTER

S-2850

FIN3-35

216-4921