



# FARRIS, HANSEN & ASSOCIATES, INC.

ENGINEERING — ARCHITECTURE — SURVEYING  
 7 RIDGWAY COURT — P.O. BOX 437 — ELKHORN, WISCONSIN 53121  
 PHONE: (262) 723-2098 FAX: (262) 723-5886


## PLAT OF SURVEY

LOT 9 OF TOWN OF DELAVAN ASSESSOR'S PLAT NO. 1  
 LOCATED IN PART OF GOV.T LOT 2 OF SECTION 27  
 TOWN 2 NORTH, RANGE 16 EAST  
 WALWORTH COUNTY, WISCONSIN

— WORK ORDERED BY —  
 TIM OPFER  
 28845 HARVEST GLEN CIRCLE  
 CARY, IL. 60013

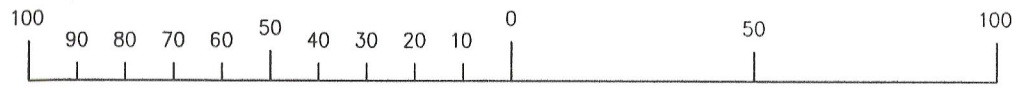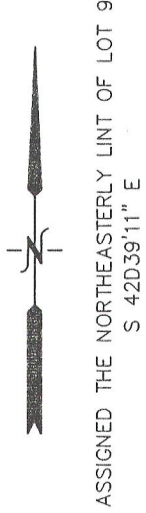

MAP SCALE IN FEET ORIGINAL 1" = 40'

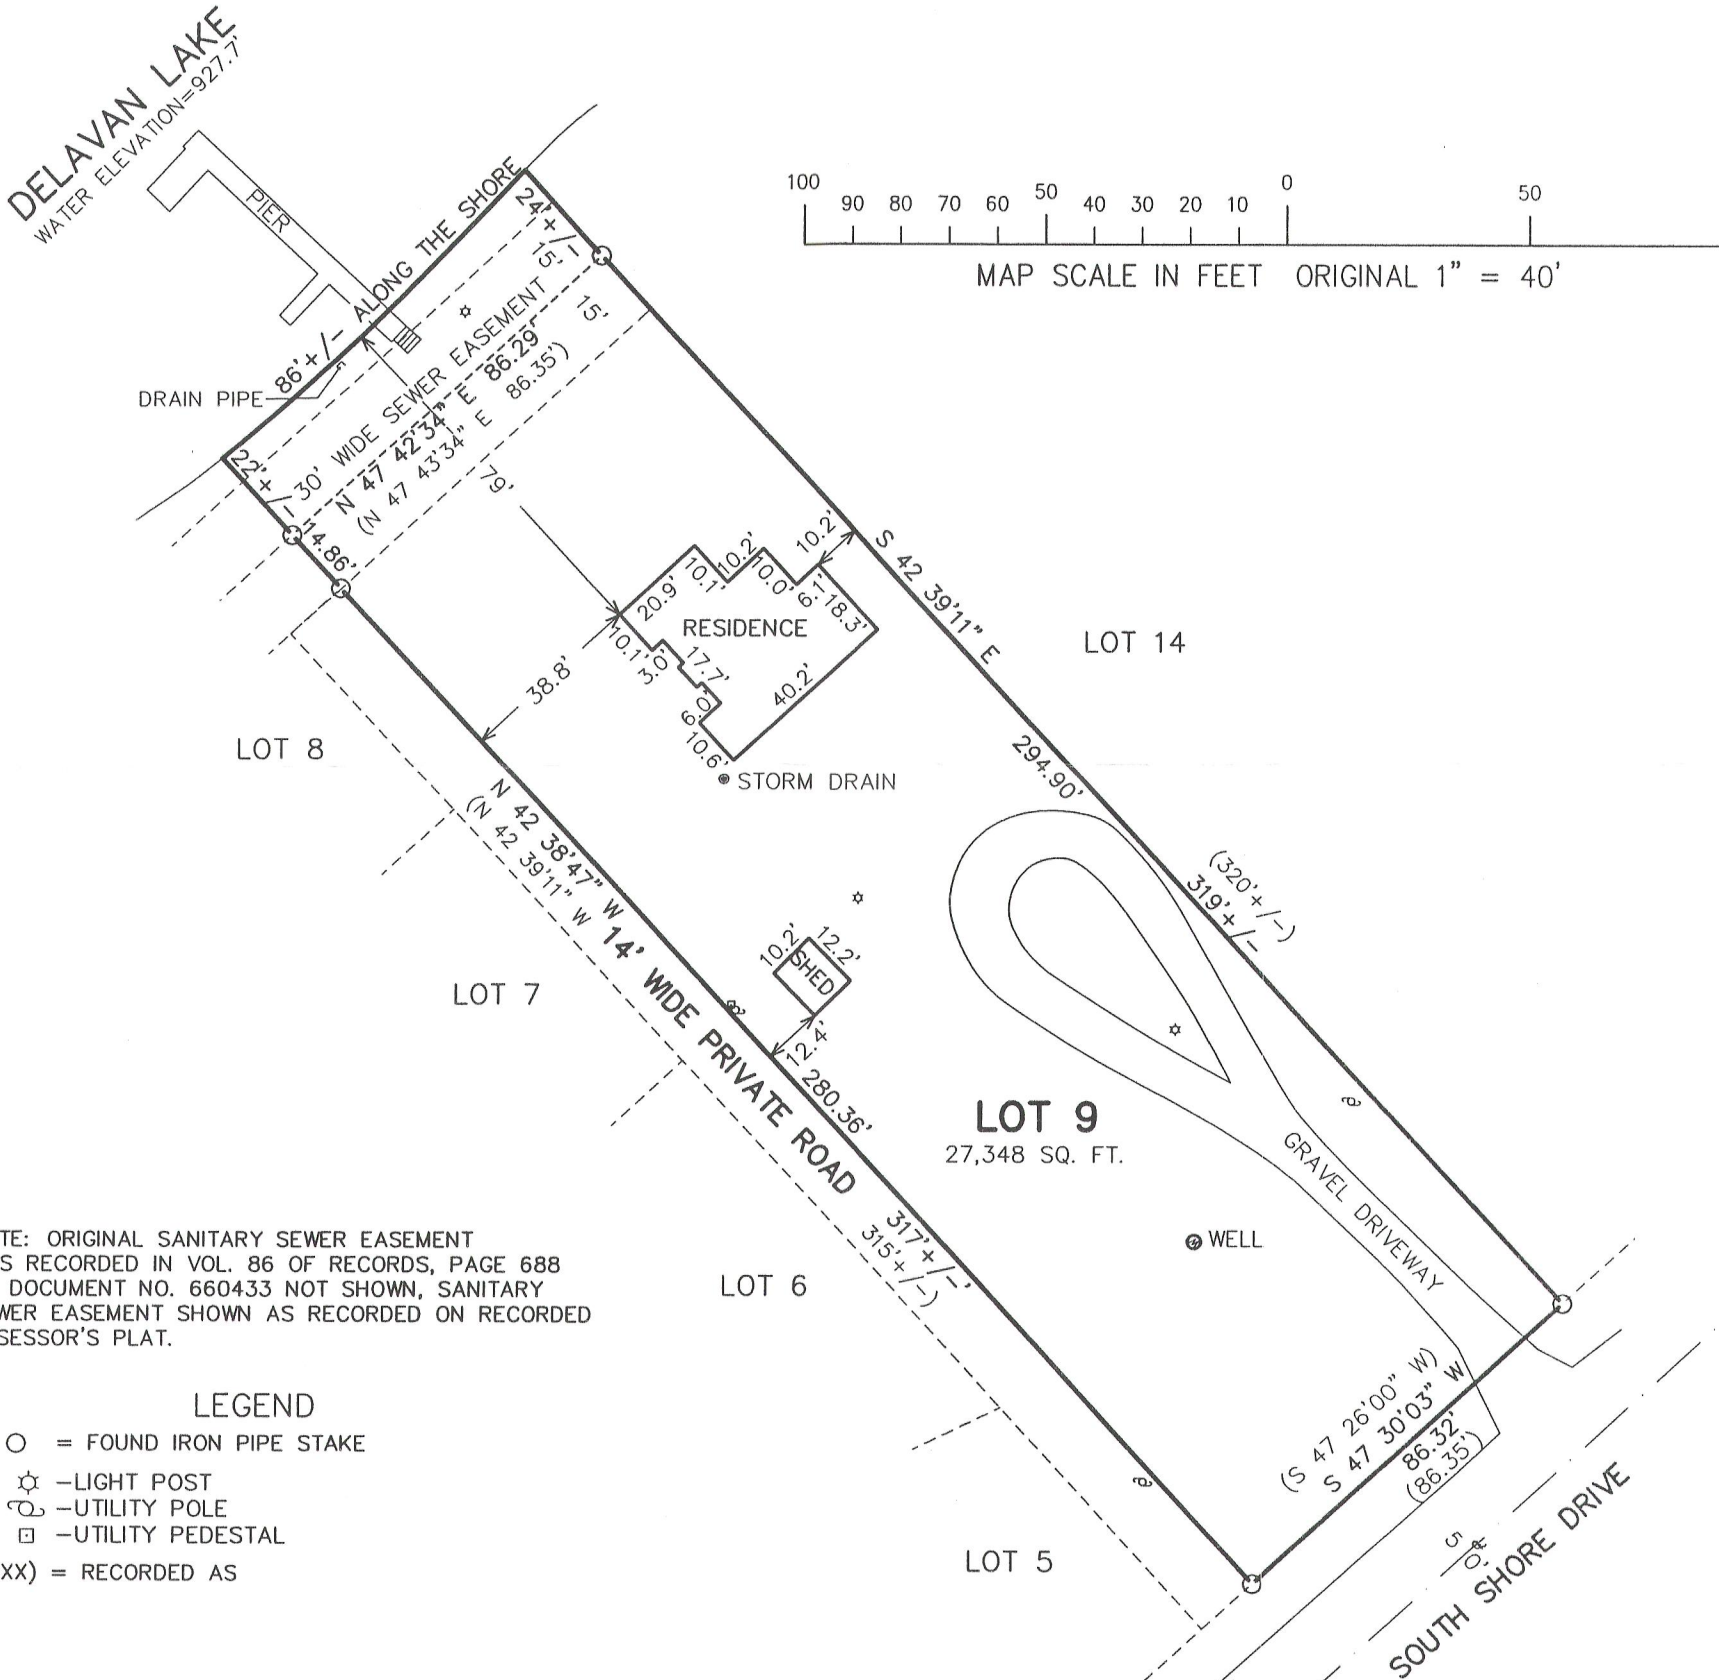

NOTE: ORIGINAL SANITARY SEWER EASEMENT WAS RECORDED IN VOL. 86 OF RECORDS, PAGE 688 AS DOCUMENT NO. 660433 NOT SHOWN, SANITARY SEWER EASEMENT SHOWN AS RECORDED ON RECORDED ASSESSOR'S PLAT.

### LEGEND


- = FOUND IRON PIPE STAKE
- ☆ = LIGHT POST
- ⊙ = UTILITY POLE
- = UTILITY PEDESTAL
- (XXX) = RECORDED AS

NOTE: COPIES OF THIS MAP TO WHICH THE FOLLOWING CERTIFICATE WILL APPLY SHOW THE SURVEYOR'S ORIGINAL SEAL AND SIGNATURE IN RED INK. COPIES BY ANY OTHER MEANS MAY HAVE ALTERATIONS WHICH DO NOT REPRESENT THE SURVEYOR'S WORK PRODUCT.

I HEREBY CERTIFY THAT THE ABOVE DESCRIBED PROPERTY HAS BEEN SURVEYED UNDER MY DIRECTION AND THAT THE ABOVE MAP IS A TRUE REPRESENTATION THEREOF AND SHOWS THE SIZE AND LOCATION OF THE PROPERTY, ITS EXTERIOR BOUNDARIES, THE LOCATION OF ALL VISIBLE STRUCTURES, AND DIMENSIONS OF ALL PRINCIPLE BUILDINGS THEREON, BOUNDARY FENCES, APPARENT EASEMENTS, ROADWAYS, AND VISIBLE ENCROACHMENTS, IF ANY. THIS SURVEY IS MADE FOR THE USE OF THE PRESENT OWNERS OF THE PROPERTY, AND ALSO THOSE WHO PURCHASE, MORTGAGE, OR GUARANTEE THE TITLE THERETO WITHIN ONE YEAR FROM THE DATE HEREOF.

DATED: MAY 15, 2012

*Peter S. Gordon*  
 PETER S. GORDON

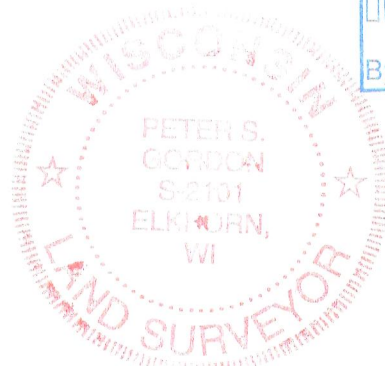

PROJECT: 8577  
 DATE: 05-15-2015  
 SHEET 1 OF 1