


PART OF THE NE 1/4 OF FR'L SEC. 22
TOWN 2 NORTH, RANGE 16 EAST
WALWORTH COUNTY, WISCONSIN

A parcel of land located in the NE 1/4 of fractional Section 22, T2N, R16E, Town of Delavan, Walworth County, Wisconsin, described as follows, to-wit: Commencing at the East 1/4 corner of said Section; thence West along the 1/4 Section line, 14.1 feet to the Southeast corner of the land owned by Stephanie J. Humphreys; thence N. 25° 45' W., 194.42 feet to the Southeast corner of the shore of Delavan Lake; thence thence continue along the same course 194.42 feet more to the Southeast corner of the shore of Delavan Lake; thence Southwesterly along the shore and to the centerline of State Trunk Highway No. 50, 257 feet more or less; thence Southeast along the centerline of State Trunk Highway No. 50, 173 feet; thence N. 60° 54' E., 211.67 feet to the place of beginning.

Parcel No.:
F D 2200003

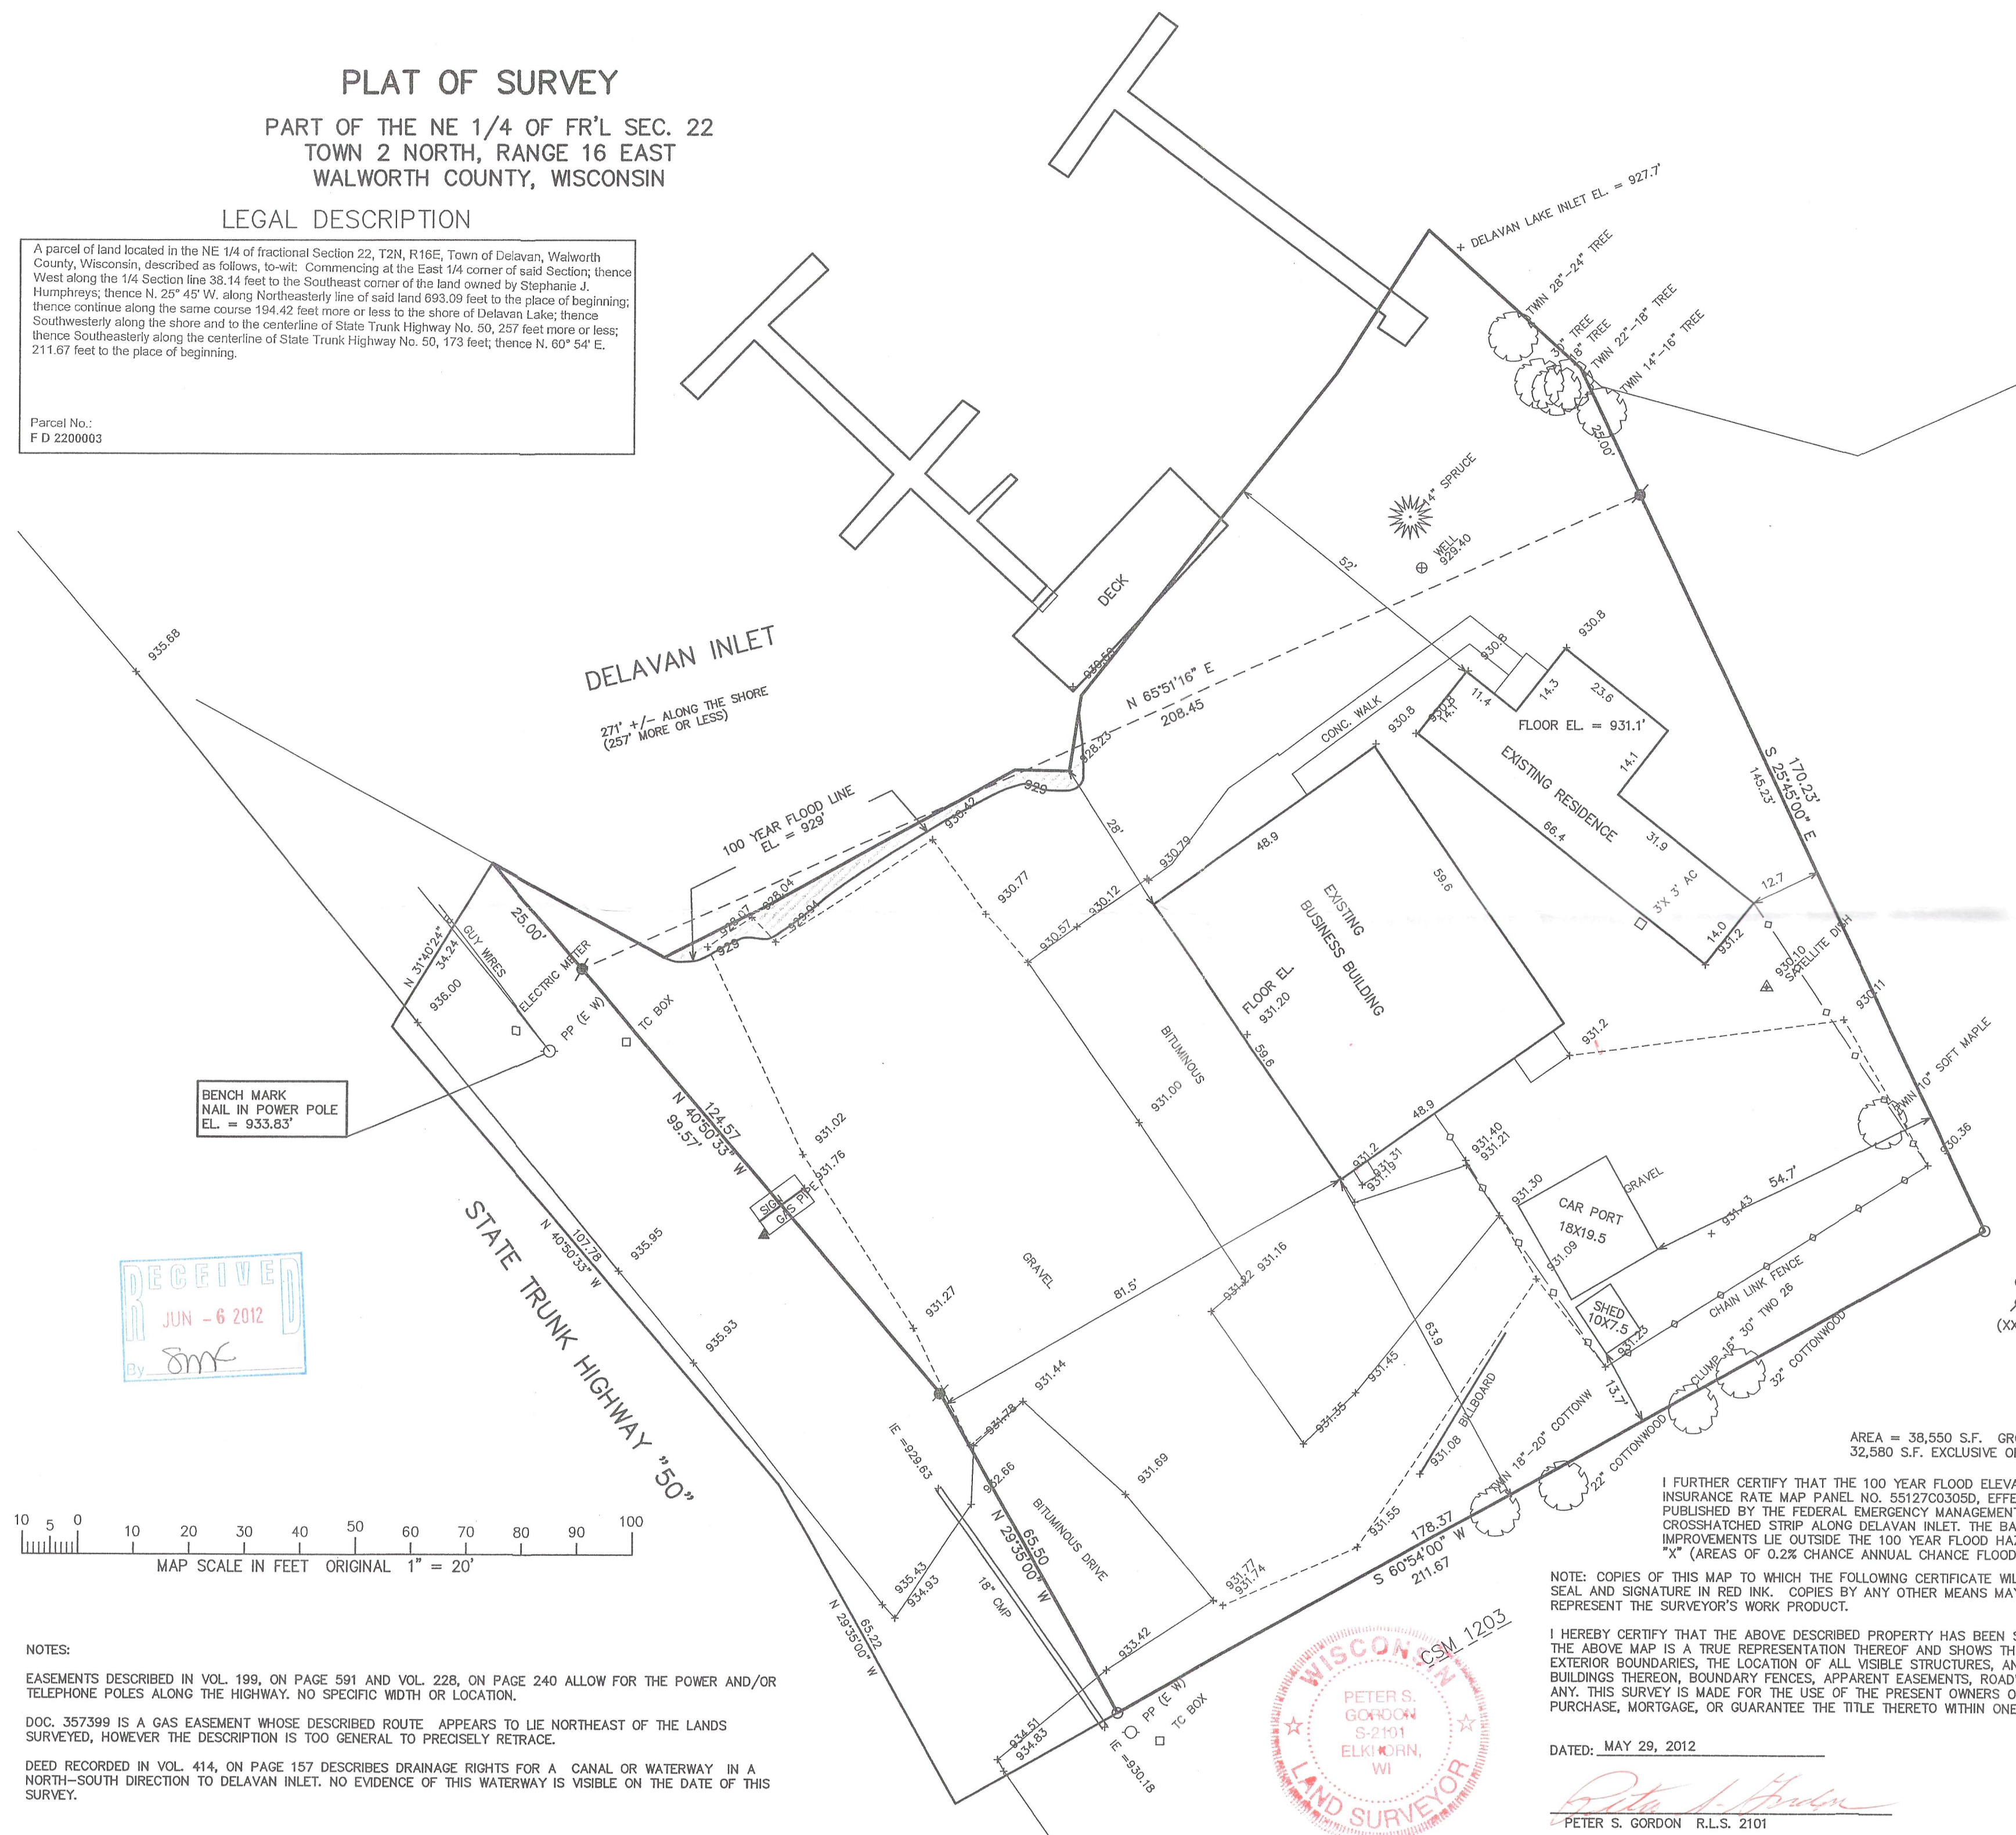

AREA = 38,550 S.F. GROSS TO CL HWY
32,580 S.F. EXCLUSIVE OF HIGHWAY ROW

I FURTHER CERTIFY THAT THE 100 YEAR FLOOD ELEVATION OF 929.0 AS SHOWN ON FLOOD INSURANCE RATE MAP PANEL NO. 55127C0305D, EFFECTIVE DATE OF OCTOBER 2, 2009 AS PUBLISHED BY THE FEDERAL EMERGENCY MANAGEMENT AGENCY IS SHOWN ON THIS SURVEY AS A CROSSHATCHED STRIP ALONG DELAVAN INLET. THE BALANCE OF THE LANDS SURVEYED AND ALL IMPROVEMENTS LIE OUTSIDE THE 100 YEAR FLOOD HAZARD AREA AND IS IN FLOOD HAZARD AREA "X" (AREAS OF 0.2% CHANCE ANNUAL CHANCE FLOOD).

NOTE: COPIES OF THIS MAP TO WHICH THE FOLLOWING CERTIFICATE WILL APPLY SHOW SURVEYOR'S ORIGINAL SEAL AND SIGNATURE IN RED INK. COPIES BY ANY OTHER MEANS MAY HAVE ALTERATIONS WHICH DO NOT REPRESENT THE SURVEYOR'S WORK PRODUCT.

I HEREBY CERTIFY THAT THE ABOVE DESCRIBED PROPERTY HAS BEEN SURVEYED UNDER MY DIRECTION AND THAT THE ABOVE MAP IS A TRUE REPRESENTATION THEREOF AND SHOWS THE SIZE AND LOCATION OF THE PROPERTY, ITS EXTERIOR BOUNDARIES, THE LOCATION OF ALL VISIBLE STRUCTURES, AND DIMENSIONS OF ALL PRINCIPLE BUILDINGS THEREON, BOUNDARY FENCES, APPARENT EASEMENTS, ROADWAYS, AND VISIBLE ENCROACHMENTS, IF ANY. THIS SURVEY IS MADE FOR THE USE OF THE PRESENT OWNERS OF THE PROPERTY, AND ALSO THOSE WHO PURCHASE, MORTGAGE, OR GUARANTEE THE TITLE THERETO WITHIN ONE YEAR FROM THE DATE HEREOF.

DATED: MAY 29, 2012

PETER S. GORDON R.L.S. 2101

WORK ORDERED BY:
CLAIR LAW OFFICES
PO BOX 445
DELAVAN, WI. 53115

FARRIS, HANSEN & ASSOCIATES, INC.
ENGINEERING — ARCHITECTURE — SURVEYING
7 RIDGWAY COURT P.O. BOX 437
ELKHORN, WISCONSIN 53121
OFFICE: (262) 723-2098 FAX: (262) 723-5686

REVISIONS

| |
|---------------------|
| PROJECT NO. 5531 |
| DATE: 06-22-00 |
| SHEET NO. 1 OF 1 |

FD 22-3

216-4948