

Bearings reference to the plat of Woodlawn Bay Community.

Lot 6

Property Exhibit



of
A New Stone Patio
on

Lot 7 in Block 1 of Woodlawn Bay Community,

a subdivision located in Government Lot 1 in the Northeast 1/4 of Section 28,
Town 2 North, Range 16 East, Town of Delavan, Walworth County, Wisconsin.


Surveyed for: **William Wiggs**
1029 North Carlyle Lane
Arlington Heights, Illinois. 60004

Survey Date: April 13, 2012.
Revisions: No. 1 - As-built Patio

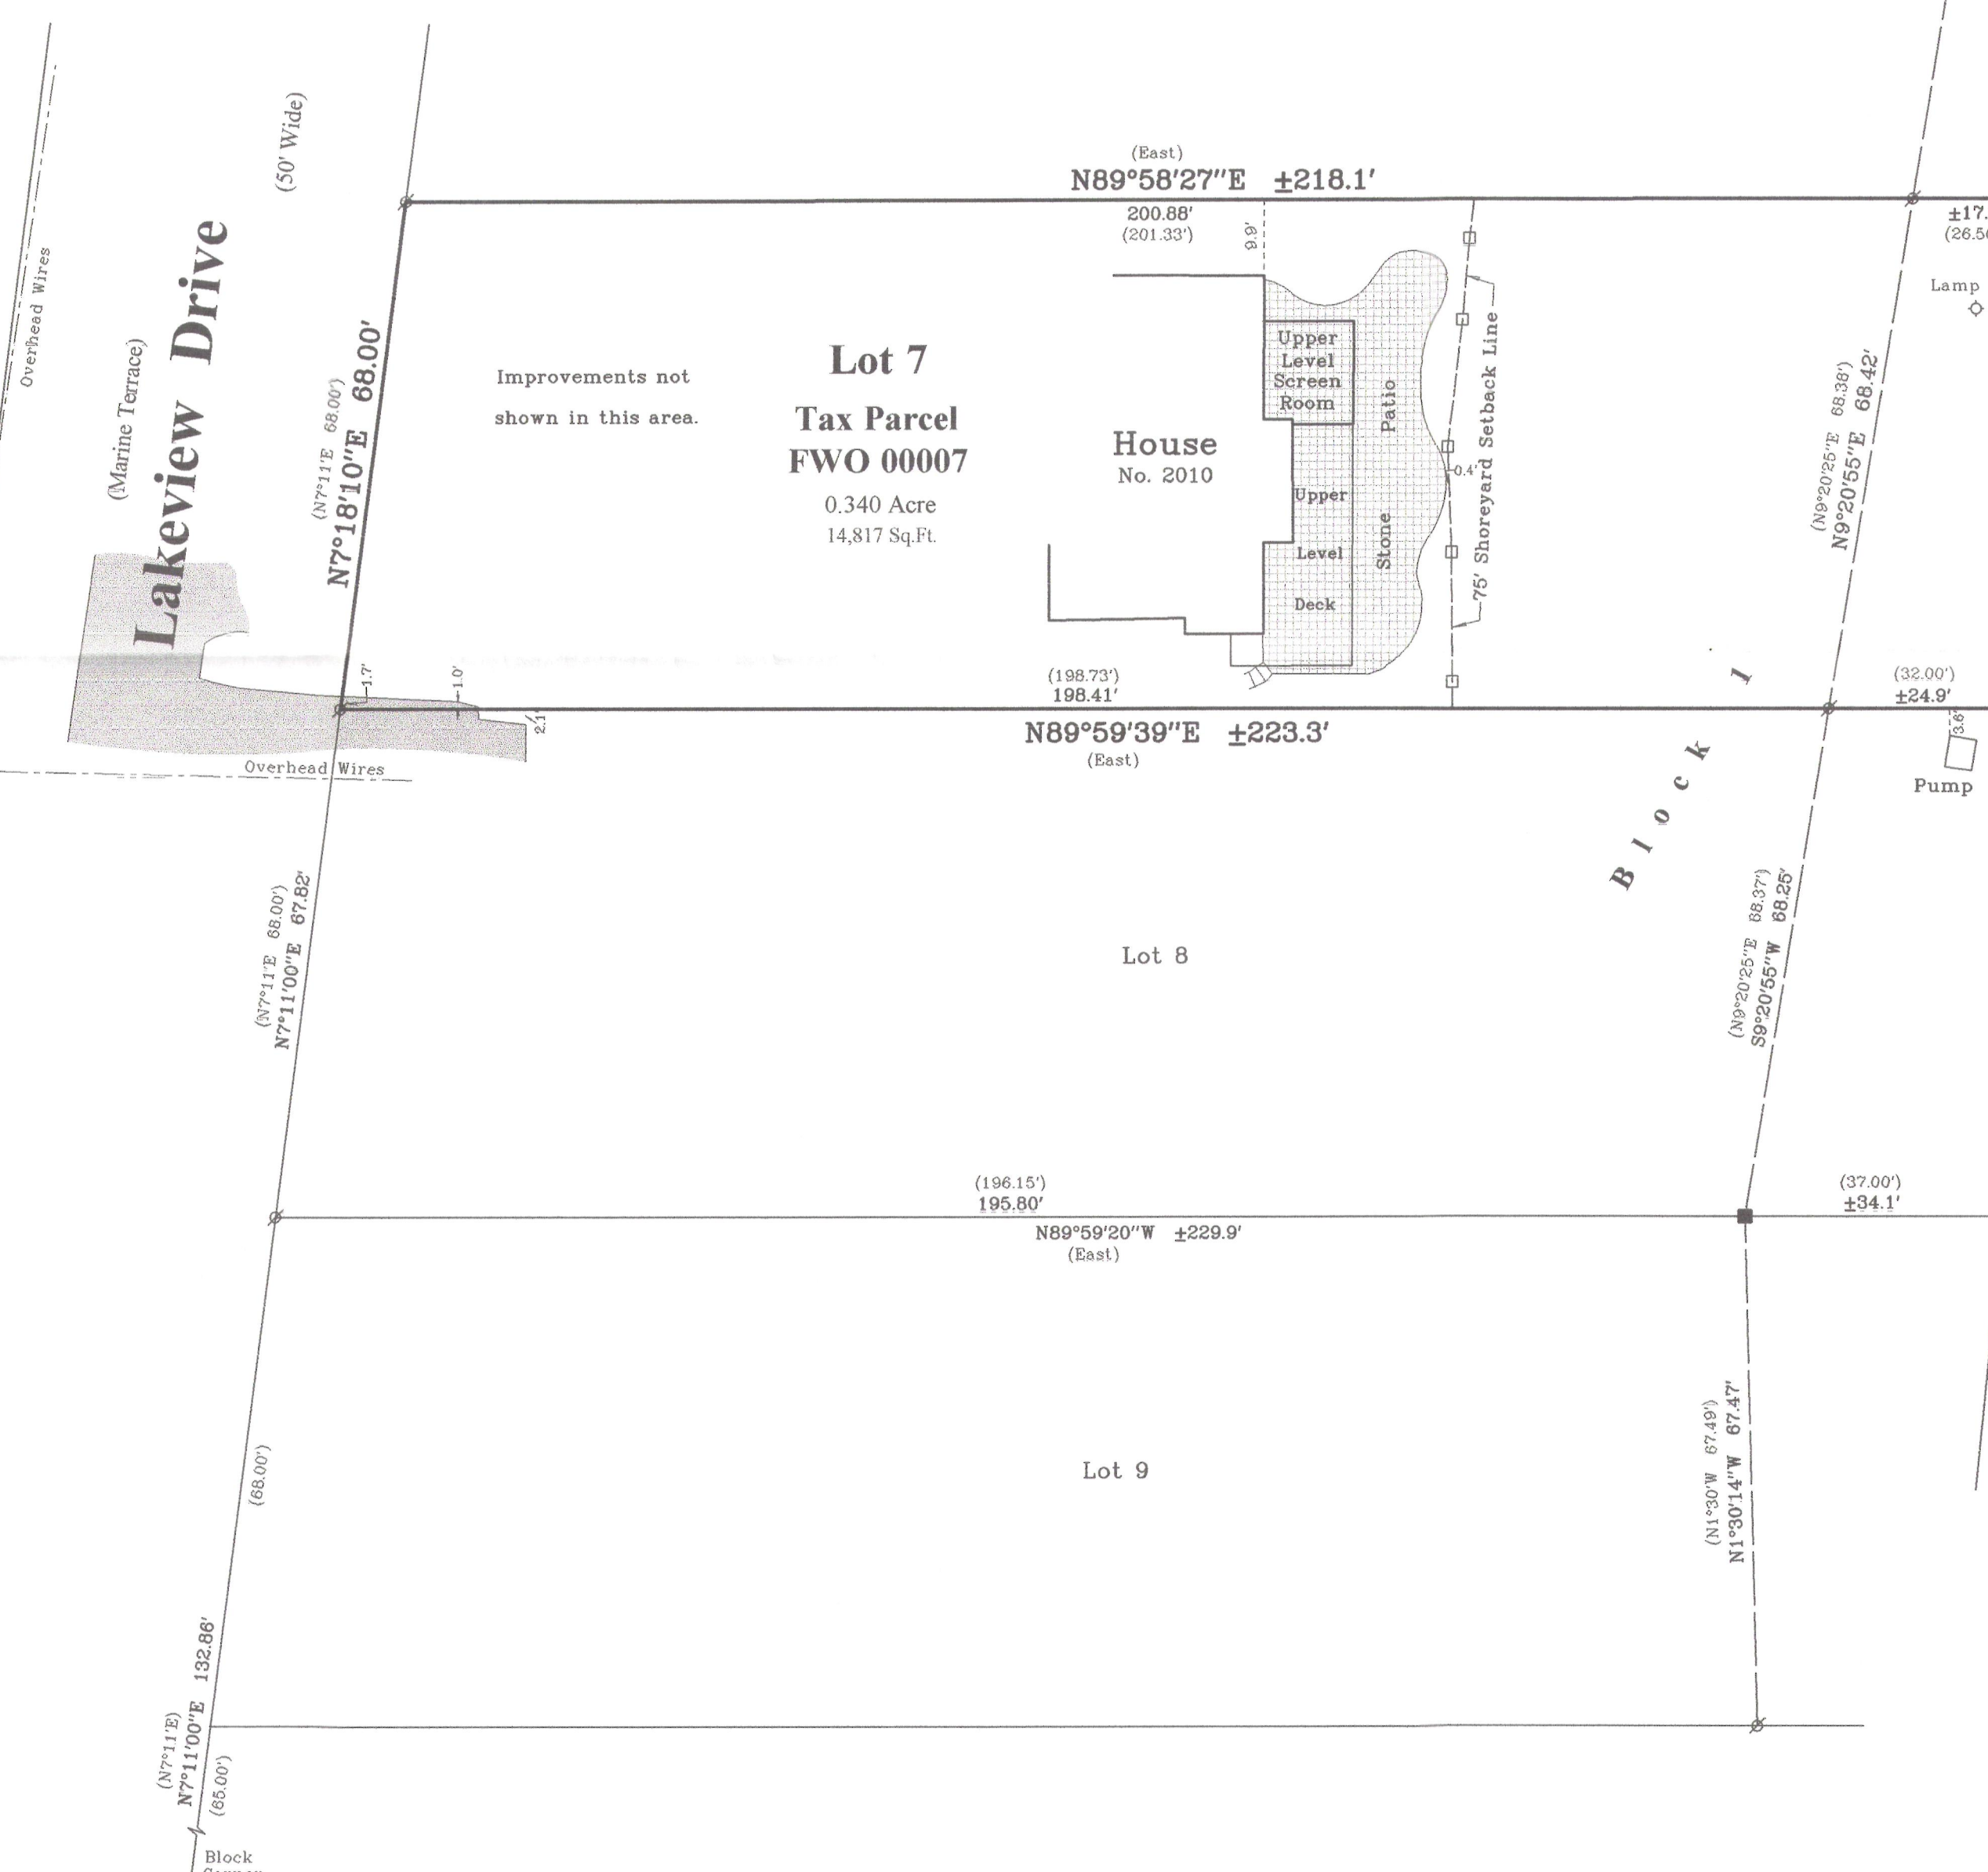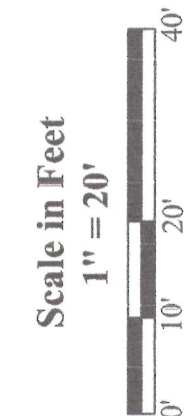

Delavan

Lake

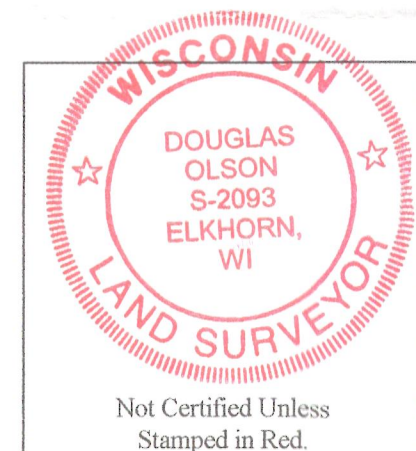

Notes:

- 1) This survey plat is not certified unless signed and sealed in red ink.
- 2) This survey is subject to Wisconsin lien laws. This Plat of Survey is the notice of intent to file lien. Lien waiver required.



Copyright 2012 by Jensen & Olson Land Surveying, LLC.

All rights reserved. No part of this survey plat may be reproduced or transmitted in any form by any means - graphic, electronic, or mechanical, including photocopying, tracing, or information storage and retrieval systems - without permission in writing from Douglas G. Olson, Jensen & Olson Land Surveying, LLC.

I, Douglas G. Olson, Wisconsin Registered Land Surveyor, do hereby certify that this survey was performed by me, or under my direction in full compliance with the owner's/agent's instructions and Chapter A-E 7 of the Wisconsin Administrative Code "Minimum Standards for Property Surveys"; and that this map is an accurate representation thereof to the best of my knowledge and belief.

Douglas G. Olson
Wisconsin Registered Land Surveyor - 2093

Jensen & Olson Land Surveying, LLC
45 South Wisconsin Street * P.O. Box 322 * Elkhorn, Wisconsin. 53121
Telephone: (262) 723-3434 * Facsimile: (262) 723-8044
Email: jensen.olson@elknet.net

Legend
 Found Concrete Monument
 Found Iron Pipe
 Set Wood Stake
 Recorded Information
 Utility Pole
 Asphalt Surface
 New Stone Patio at grade

Sheet 1 of 1 Sheets
Drawing Name: 04r16c-2012032-2012032P1a.dwg
Job Reference Number
2012.032

2012.032

FWD-7

216-4971