

PLAT OF SURVEY

- OF -

PATHFINDER SURVEYING INC.

(formerly)

J.K. SURVEYING INC.

P.O BOX 322

LAKE GENEVA, WI. 53147

WWW.PATHFINDERSURVEYING.NET

262-248-8303

(THIS IS A LOT LINE ADJUSTMENT BETWEEN ADJOINING LAND OWNERS)

FLAD 00277



LOTS 367, 368, AND 369, LAKE DELAVAN HIGHLANDS, A SUBDIVISION
LOCATED IN TOWN 2 NORTH, RANGE 16 EAST, TOWN OF DELAVAN,
WALWORTH COUNTY WISCONSIN.

FLAD 00280


LOTS 370 LAKE DELAVAN HIGHLANDS, A SUBDIVISION LOCATED IN
TOWN 2 NORTH, RANGE 16 EAST, TOWN OF DELAVAN, WALWORTH
COUNTY WISCONSIN.

CURRENT ZONING R2A

LOT 369 IS TO BE TAKEN FROM FLAD 00277 AND ADDED TO FLAD 00280.

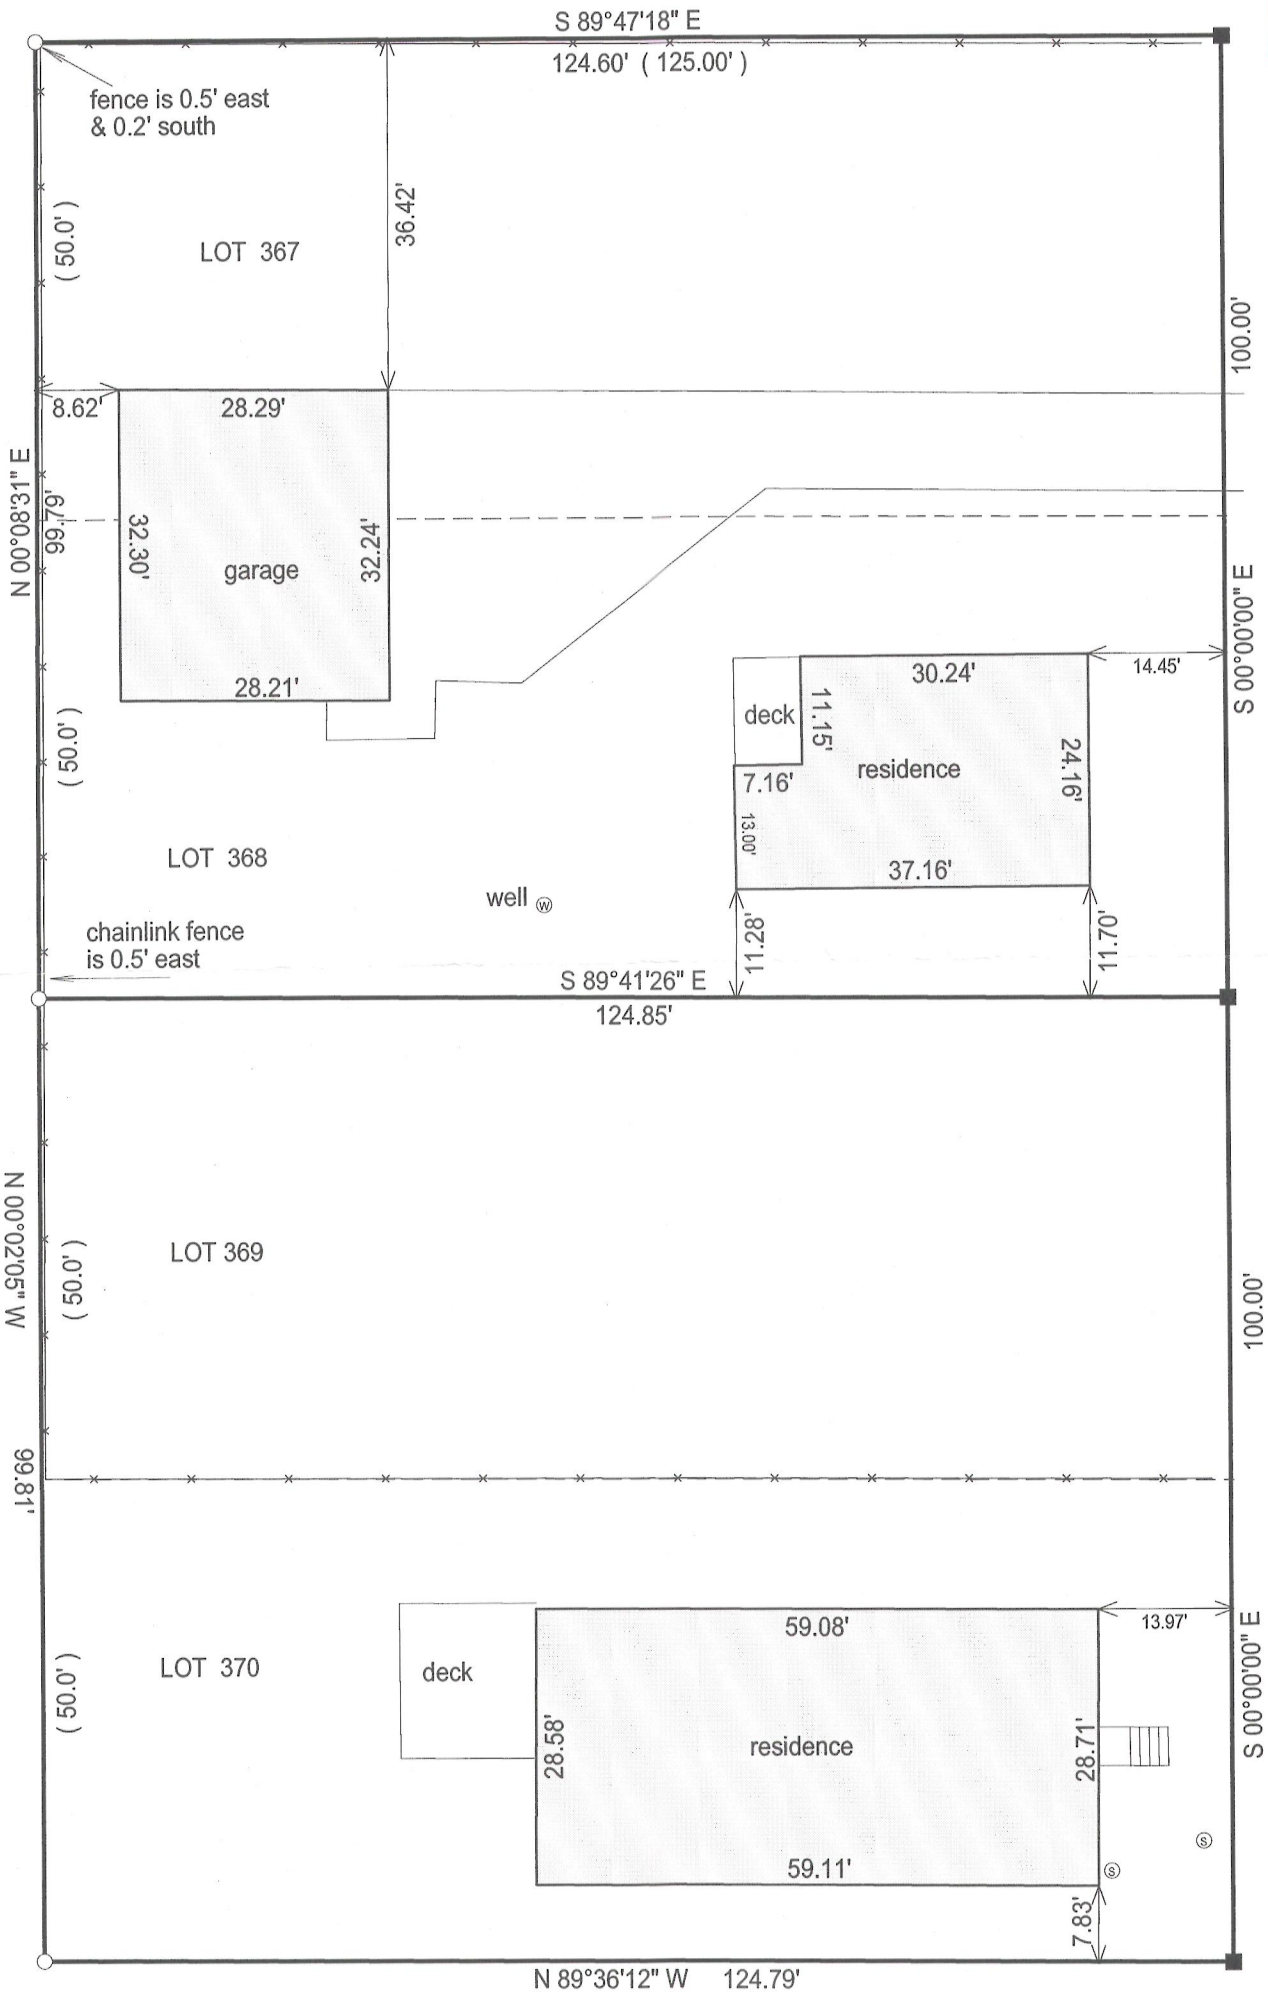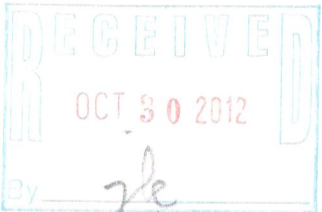

LAKE AVENUE

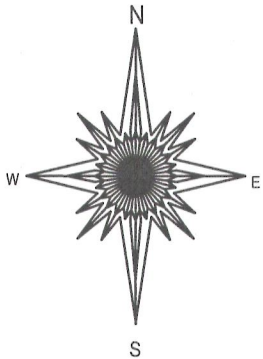


- () = recorded as
- = found iron bar
- = found iron pipe
- = set iron pipe
- = set iron bar

SCALE 1" = 20'

JOB # 12-150

TAX ID #

SEE ABOVE

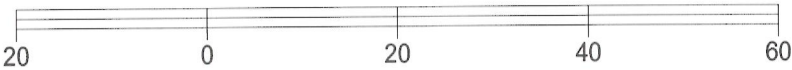


BASIS OF BEARING OF THIS PLAT: THE WEST LINE OF LAKE AVENUE
WAS ASSUMED TO BEAR NORTH / SOUTH.

"I Jeffrey L. Kimps, Wisconsin Registered Land Surveyor do hereby certify that
that this survey was performed by me and is in full compliance with chapter
AE-7 of the Wisconsin Administrative Code " Minimum Standards for Property
Surveys" and this map is an accurate representation thereof to the best of
my knowledge and belief.

This survey is made for the present owners of the property, and those who
purchase, mortgage, or guarantee the title thereto, within one year from
the date hereof.

DATED THIS 8TH DAY OF OCTOBER, 2012.

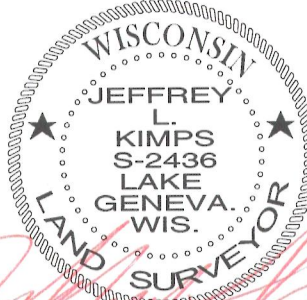

JEFFREY L KIMPS S - 2436
Wisconsin Registered Land Surveyor
(original if signed in red)

216-4993