

LAND-MARK SURVEYING

Mark L. Miritz

Wisconsin Registered Land Surveyor S-2582

N9330 Knuteson Drive
Whitewater, WI 53190
Phone: (262) 495-3284
FAX: (262) 495-8421
LAND-MARKSURVEYING.COM



PLAT OF SURVEY

LOTS 13, BLOCK 18, DELAVAN LAKE-VIEW CREST
SUBDIVISION, LOCATED IN SECTION 31, TOWN 2
NORTH, RANGE 16 EAST, DELAVAN TOWNSHIP,
WALWORTH COUNTY, WISCONSIN.

OWNERS: KENNETH S. DIX
KATHLEEN T. DIX
415 S. IOKA AVE.
MT. PROSPECT, IL 60056

SITE ADDRESS: 4323 HIGHLAND DR., DELAVAN

HIGHLAND DRIVE
(50' WIDE)

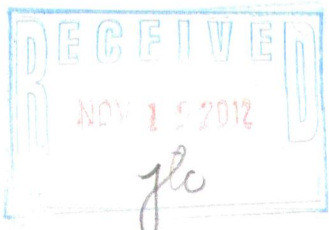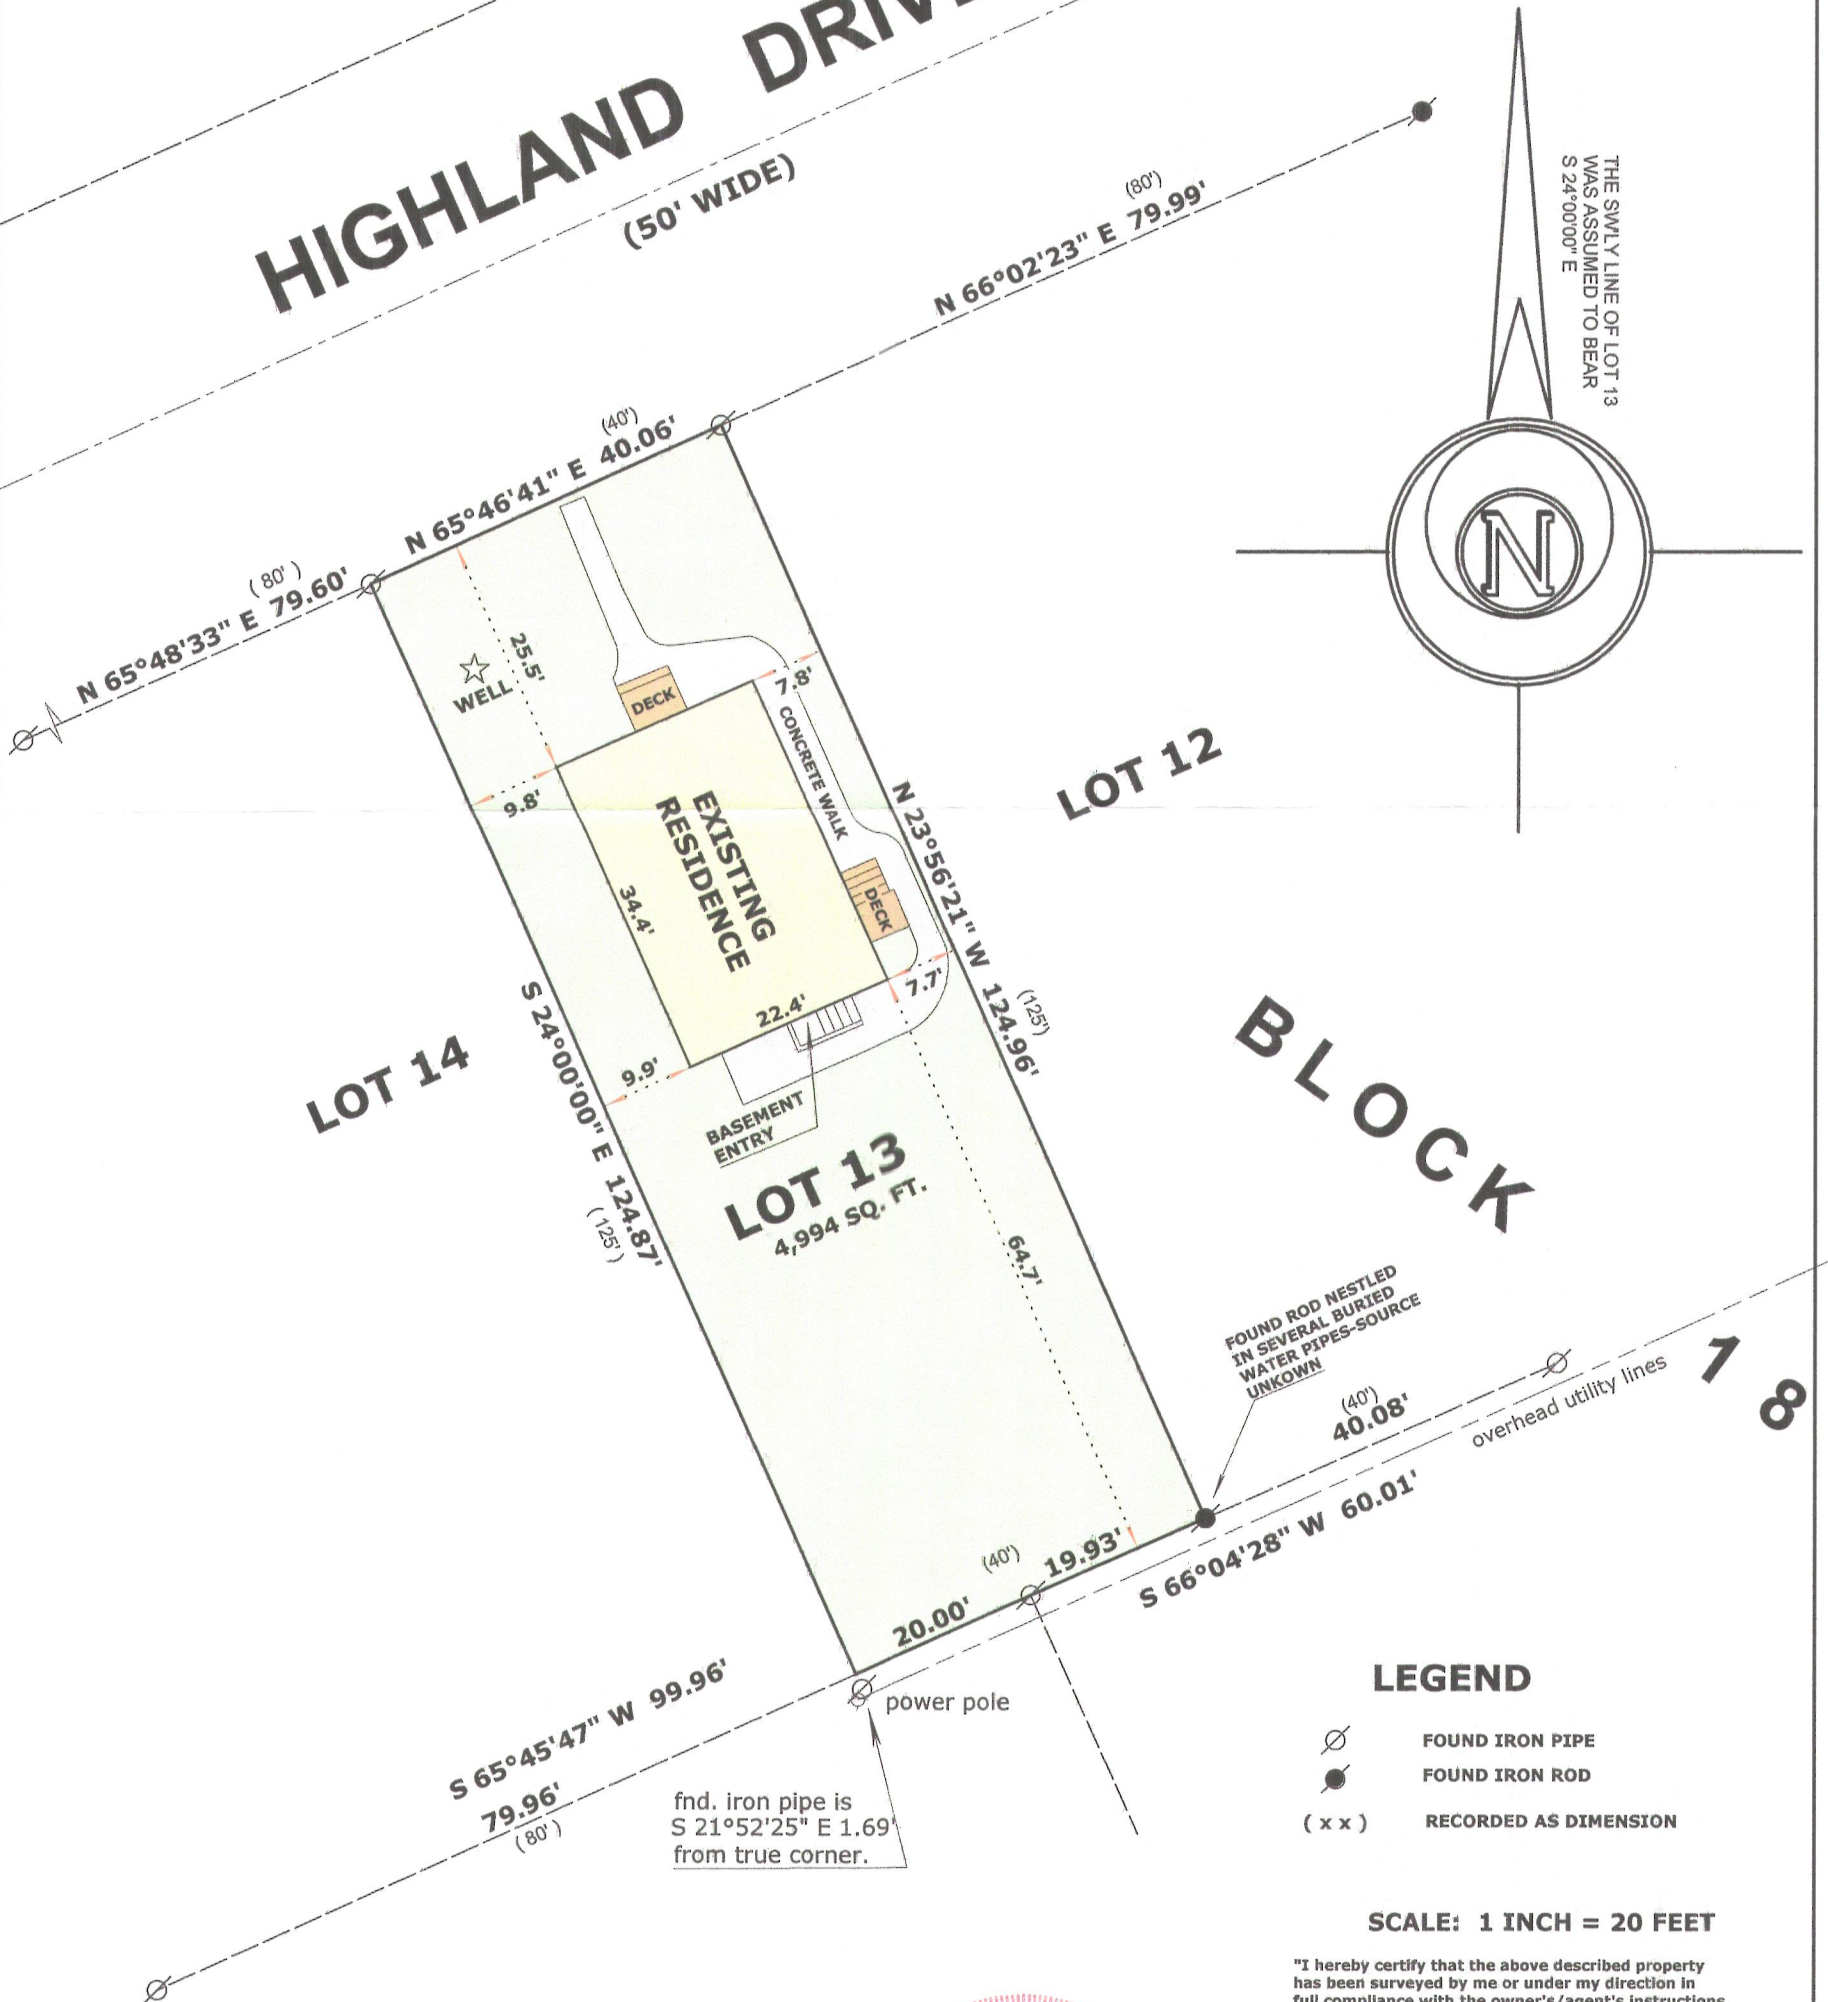

Mark L. Miritz
MARK L. MIRITZ
WISCONSIN REGISTERED
LAND SURVEYOR S-2582

DATE: OCT. 2, 2012 JOB NO. 12.1002

FDLV 00156

216-4996