PREPARED FOR MITCHELL LEPKOWSKI 4112 BEACH AVE. DELAVAN WI. 53115


## PLAT OF SURVEY

DF-

LOT 353, LAKE DELAVAN HIGHLANDS, BEING A SUBDIVISION OF THE SOUTH 1/2 OF THE SOUTHEAST 1/4 OF SECTION 31, TOWN 2 NORTH, RANGE 16 EAST, TOWN OF DELAVAN, WALWORTH COUNTY, WISCONSIN.

KROTT SUR VEYING INC.

N3705 WILLOW BEND LANE
LAKE GENEVA WI. 53147
PHONE # (262)248-3697
FAX # (262)249-0639

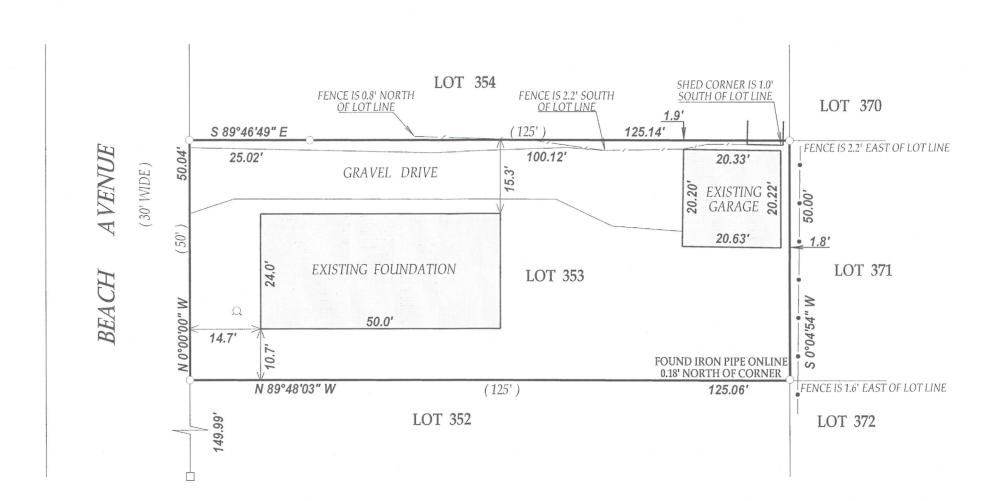



LEGEND


- FOUND IRON PIPE
- $\Box$  FOUND IRON BAR
- Q WELL
- (XX) RECORDED AS


TAX ID # FLAD00264

JOB # 11-155AB

I have surveyed the above-described property and the above map is a true representation thereof and shows the size and location of the property, its exterior boundaries, the location and dimensions of all structures thereon, fences apparent easements and roadways and visible encroachments. if any.

This survey is made for the exclusive use of the present owners of the property, and also those who puchase, mortgage, or insure the title therto within one (1) year from date hereof; and as to them I warrant the accuracy of said survey map.

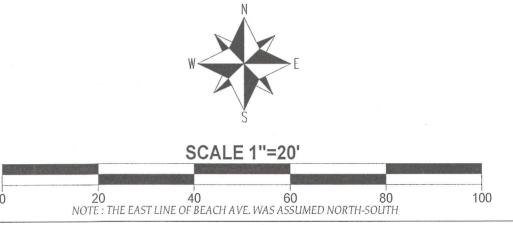

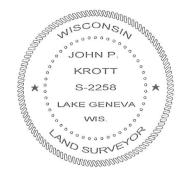

DATED THIS 25th DAY OF OCTOBER 2011. REVISED 08/03/2012 REVISED 11/15/2012

JOHN KROTT S - 2258 Wisconsin Registered Land Surveyor ( original if signed in red )

216-4999