


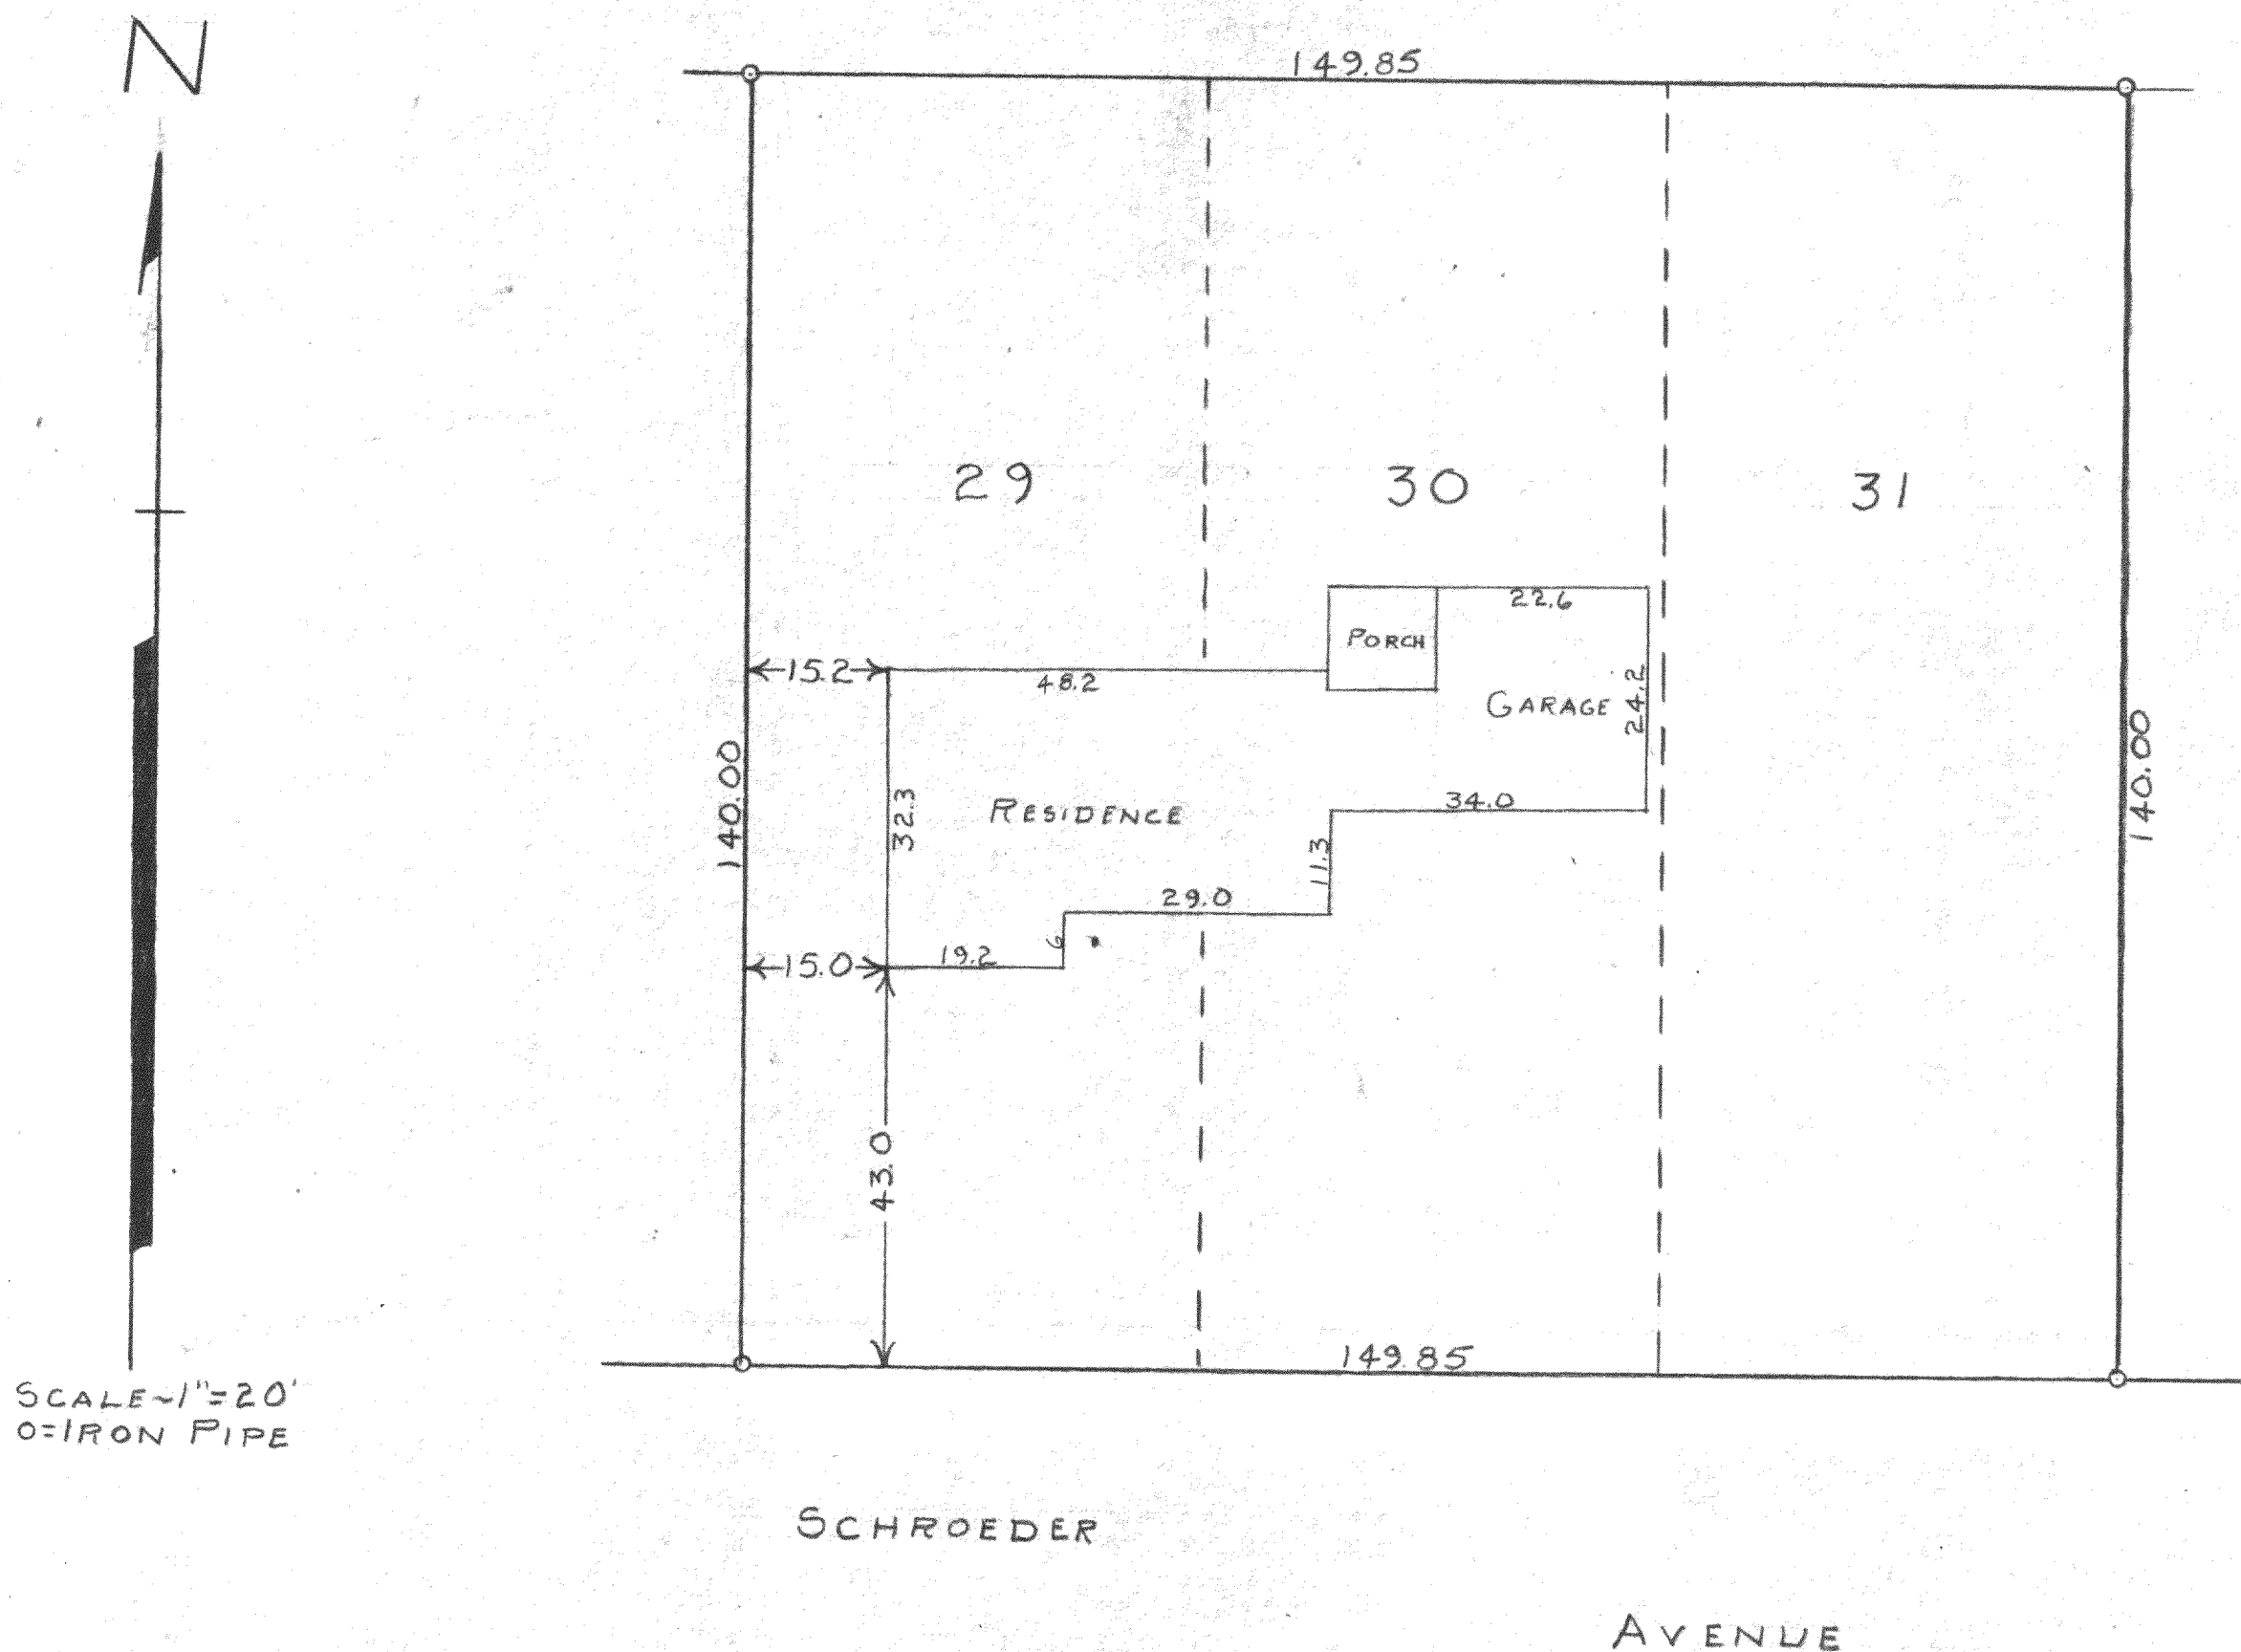

STATE OF WISCONSIN) SS
COUNTY OF WALWORTH)
I, GEORGE T. DUNHAM, DO HEREBY CERTIFY THAT I HAVE SURVEYED THE
PROPERTY DESCRIBED AS FOLLOWS:
LOTS 29, 30, AND 31, BLOCK 9 OF INLET OAKS SUBDIVISION No. 4
LOCATED IN THE TOWN OF DELAYAN, WALWORTH COUNTY, WISCONSIN
AND THAT THE PLAT SHOWN ABOVE IS A CORRECT REPRESENTATION OF THE
PROPERTY LINES AND OF THE IMPROVEMENTS LOCATED THEREON
OCT. 30, 1956

George T. Dunham
GEORGE T. DUNHAM, SURVEYOR
DELAYAN, WISCONSIN 216-50