ORDERED By
ALLISON & DAN OLESTON
KEEFE REAL ESTATE
LAKE GENEVA, WI

PLAT OF SURVEY

- OF -

LOT 5 LAKEWOOD ESTATES, A SUBDIVISION LOCATED IN THE SW 1/4 OF SECTION 21, TOWN 2 NORTH, RANGE 16 EAST, TOWN OF DELAVAN, WALWORTH COUNTY, WISCONSIN

PATHFINDER SURVEYING INC.


(formerly)

J.K. SURVEYING INC.

P.O BOX 322

LAKE GENEVA, WI. 53147

WWW.PATHFINDERSURVEYING.NET
262-248-8303

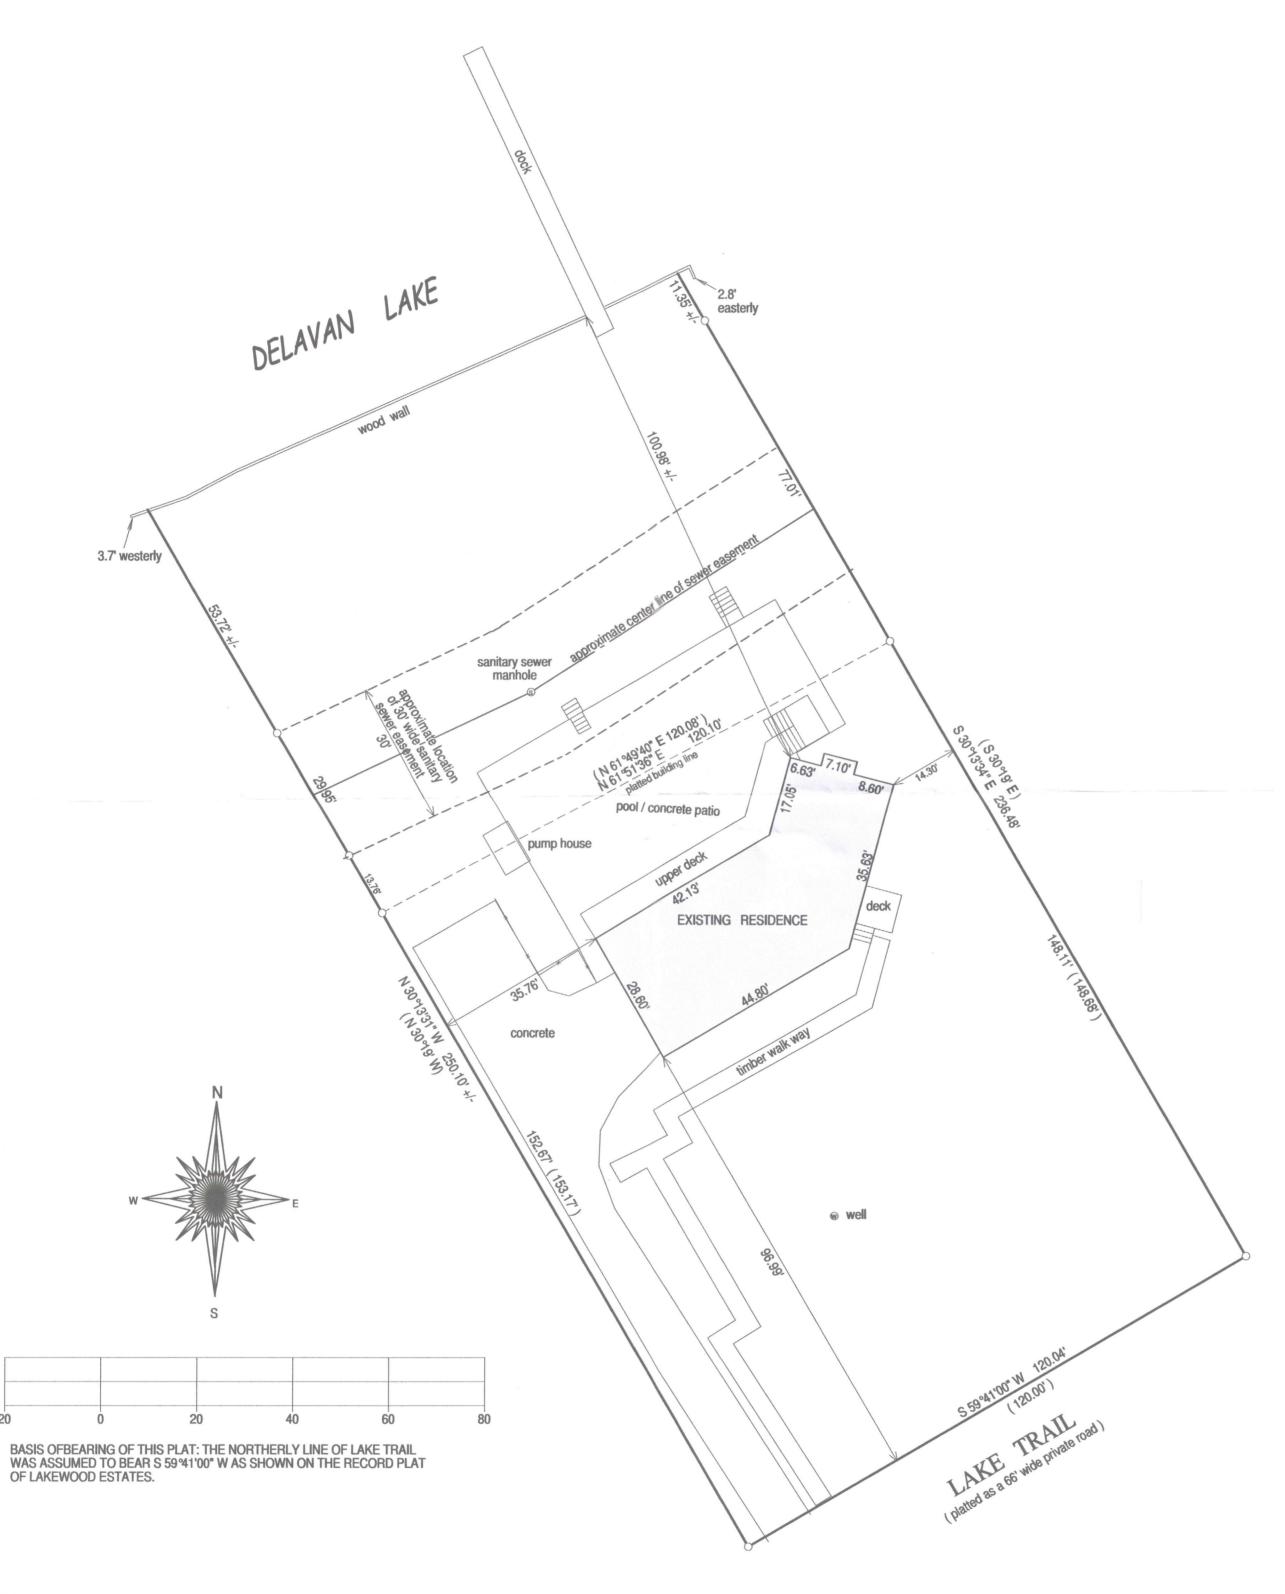

()= recorded as

□ = found iron bar

= found iron pipe

= set iron pipe= set iron bar

SCALE 1" = 20'

JOB # 12-162


TAX ID # FLE 00005

I hereby certify that I have surveyed the above- described property and the above map is a is a true representation thereof and shows the size and location of the property, its exterior boundaries, the location and dimensions of all structures thereon, fences, apparant easements and roadways and visible encroachments if any.

This survey is made for the present owners of the property, and those who purchase, mortgage, or guarantee the title thereto, within one year from the date hereof.

DATED THIS 31ST DAY OF OCTOBER, 2012.



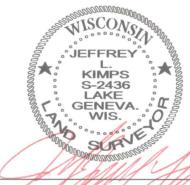

JEFEREY L KIMPS S-2436 Wisconsin Registered Land Surveyor (original if signed in red)