


Plat of Survey

of

Lot 3 in Block 1 of Woodlawn Bay Community,


a subdivision located in Government Lot 4 in the Southeast 1/4 of Section 21,
Town 2 North, Range 16 East, Town of Delavan, Walworth County, Wisconsin.

Surveyed for: **John O'Shea**
223 Gillick
Park Ridge, Illinois. 60068

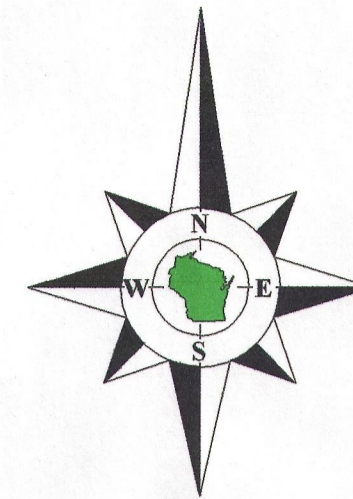

Bearings reference to the plat
of Woodlawn Bay Community.

Benchmark
Elevations referenced to
an assumed elevation of
100.00 on a mag nail.

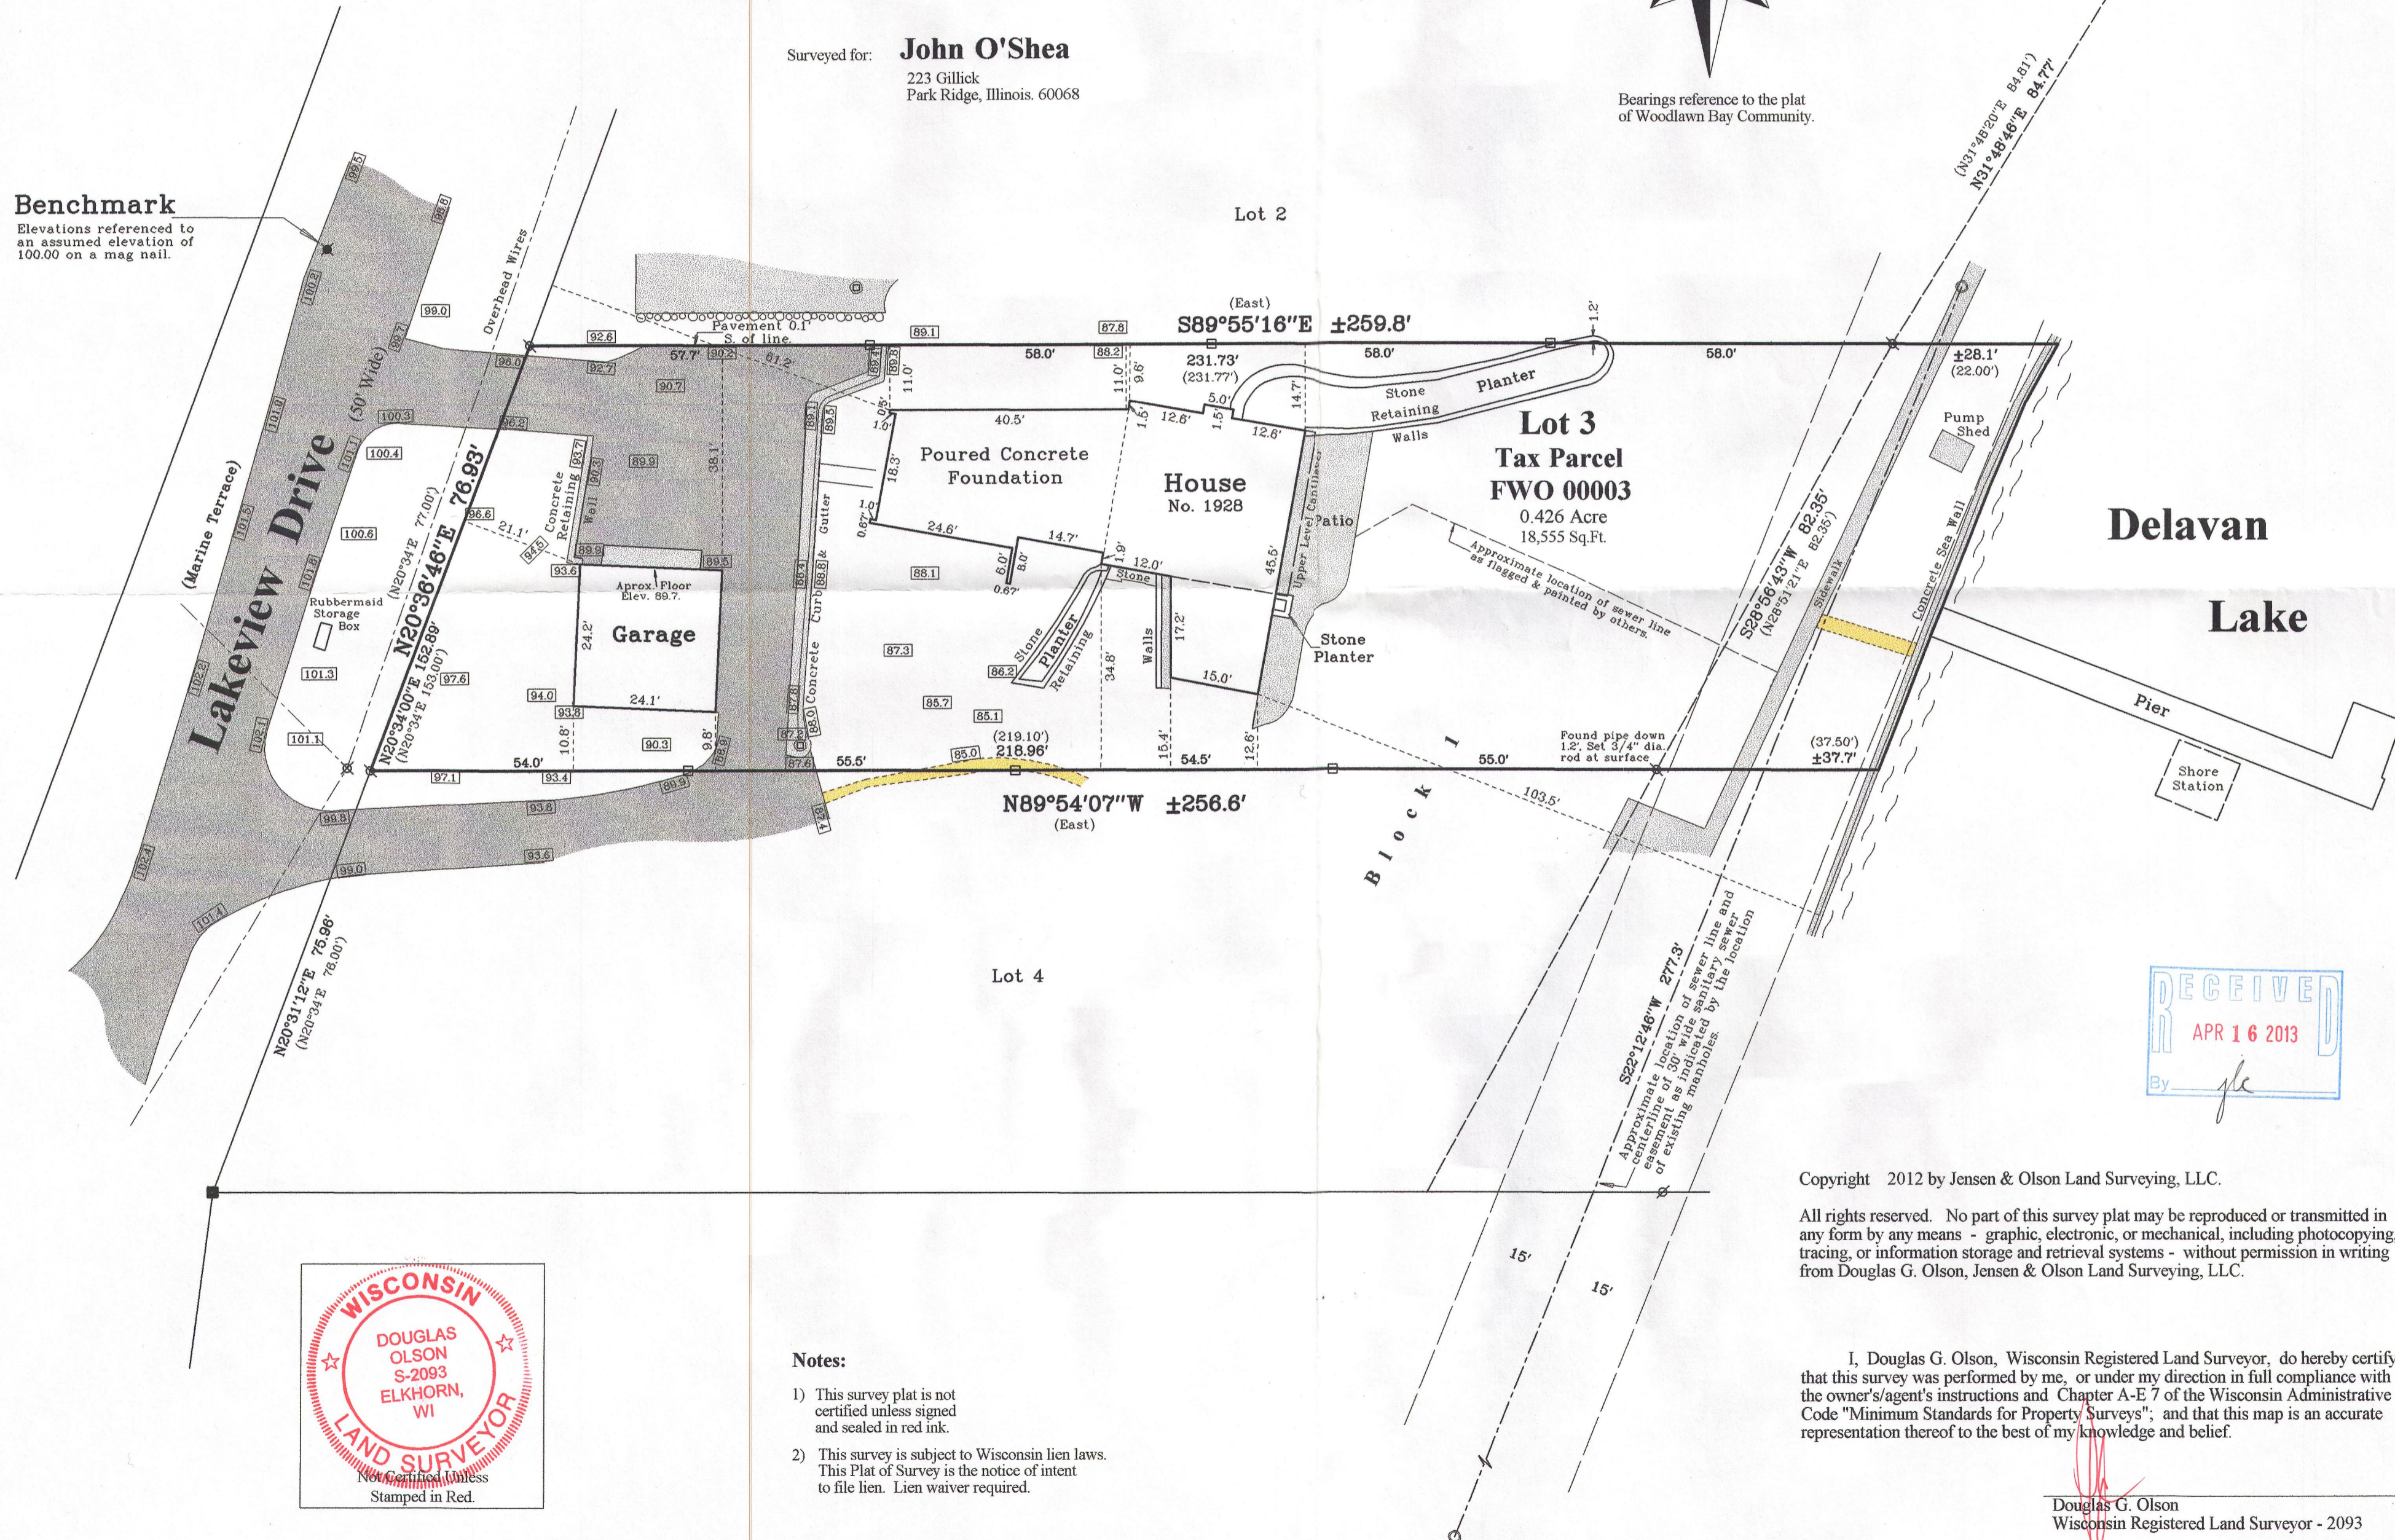

Copyright 2012 by Jensen & Olson Land Surveying, LLC.


All rights reserved. No part of this survey plat may be reproduced or transmitted in any form by any means - graphic, electronic, or mechanical, including photocopying, tracing, or information storage and retrieval systems - without permission in writing from Douglas G. Olson, Jensen & Olson Land Surveying, LLC.

I, Douglas G. Olson, Wisconsin Registered Land Surveyor, do hereby certify that this survey was performed by me, or under my direction in full compliance with the owner's/agent's instructions and Chapter A-E 7 of the Wisconsin Administrative Code "Minimum Standards for Property Surveys"; and that this map is an accurate representation thereof to the best of my knowledge and belief.


Douglas G. Olson
Wisconsin Registered Land Surveyor - 2093

Notes:

- 1) This survey plat is not certified unless signed and sealed in red ink.
- 2) This survey is subject to Wisconsin lien laws. This Plat of Survey is the notice of intent to file lien. Lien waiver required.

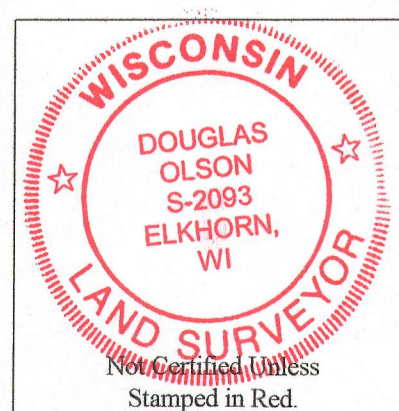

Survey Date: June 27, 2012.
Revisions: No. 1 - Stone retaining
No. 2 - Fills & addition
No. 3 - Conc. Foundation

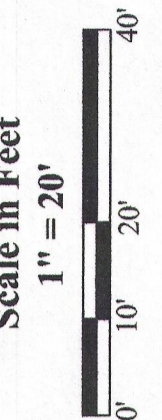

Jensen & Olson Land Surveying, LLC
45 South Wisconsin Street * P.O. Box 322 * Elkhorn, Wisconsin. 53121
Telephone: (262) 723-3434 * Facsimile: (262) 723-8044
Email: jensen.olson@elknet.net

Legend
Found Concrete Monument
Found Iron Pipe
Set Wood Lath
Recorded Information
Utility Pole
Catch Basin
Asphalt Surface
Stone
Concrete Surface

Sheet 1 of 1 Sheets
Drawing Name: C:\wfs\2012\2012072Plat.sxd
Job Reference Number
2012.072

2012.072

FWO-2

FWO 00003

216-5010