

PREPARED FOR BOB COLWELL 2416 COMSTOCK CT. NAPERVILLE IL. 60564

PLAT OF SURVEY OF

LOT 2 AND THE WEST 1/2 OF LOT 3 IN BLOCK "D" OF THE RECORDED PLAT OF DELAVAN LAKE ASSEMBLY GROUNDS TOWN OF DELAVAN, WALWORTH COUNTY, WISCONSIN.

KROTT SURVEYING INC. (262) 248-3697 N 3705 WILLOW BEND LANE LAKE GENEVA WI. 53147

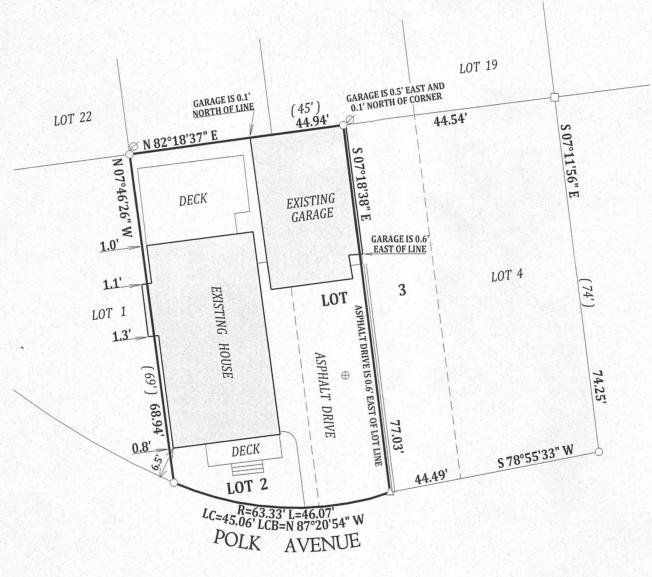

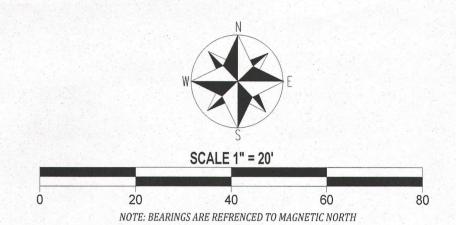

LEGEND

- O FOUND IRON PIPE
- ☐ FOUND IRON BAR
- △ SET MAGNAIL
- ⊕ SANITARY SEWER MANHOLE
- Ø UTILITY POLE

(XX) RECORDED AS

TAX ID # FDLA00046

JOB # 13-134

I have surveyed the above-described property and the above map is a true representation thereof and shows the size and location of the property, its exterior boundaries, the location and dimensions of all structures thereon, fences apparent easements and roadways and visible encroachments. if any.

This survey is made for the exclusive use of the present owners of the property, and also those who puchase, mortgage, or insure the title therto within one (1) year from date hereof; and as to them I warrant the accuracy of said survey map.





DATED THIS 3rd DAY OF SEPTEMBER 2013

JOHN P. KROTT S-2258 WISCONSIN REGISTERED LAND SURVEYOR (NOTE: THIS IS NOT A CERTIFIED COPY UNLESS SIGNED IN RED INK)