

PREPARED FOR
MIKE GALLAGHER
10210 S. FAIRFIELD
CHICAGO IL. 60655


PLAT OF SURVEY OF

LOT 13 IN BLOCK "N" OF DELAVAN LAKE ASSEMBLY, A SUBDIVISION
IN THE TOWNSHIP OF DELAVAN, WALWORTH COUNTY, WISCONSIN.

KROTT SURVEYING INC.
(262) 248-3697
N 3705 WILLOW BEND LANE
LAKE GENEVA WI. 53147

LEGEND

- FOUND IRON PIPE
- △ FOUND P.K. NAIL
- SET IRON BAR
- ⊗ UTILITY POLE
- OVER HEAD WIRES
- ⊙ GAS METER
- ⊙ ELECTRIC METER
- (XX) RECORDED AS

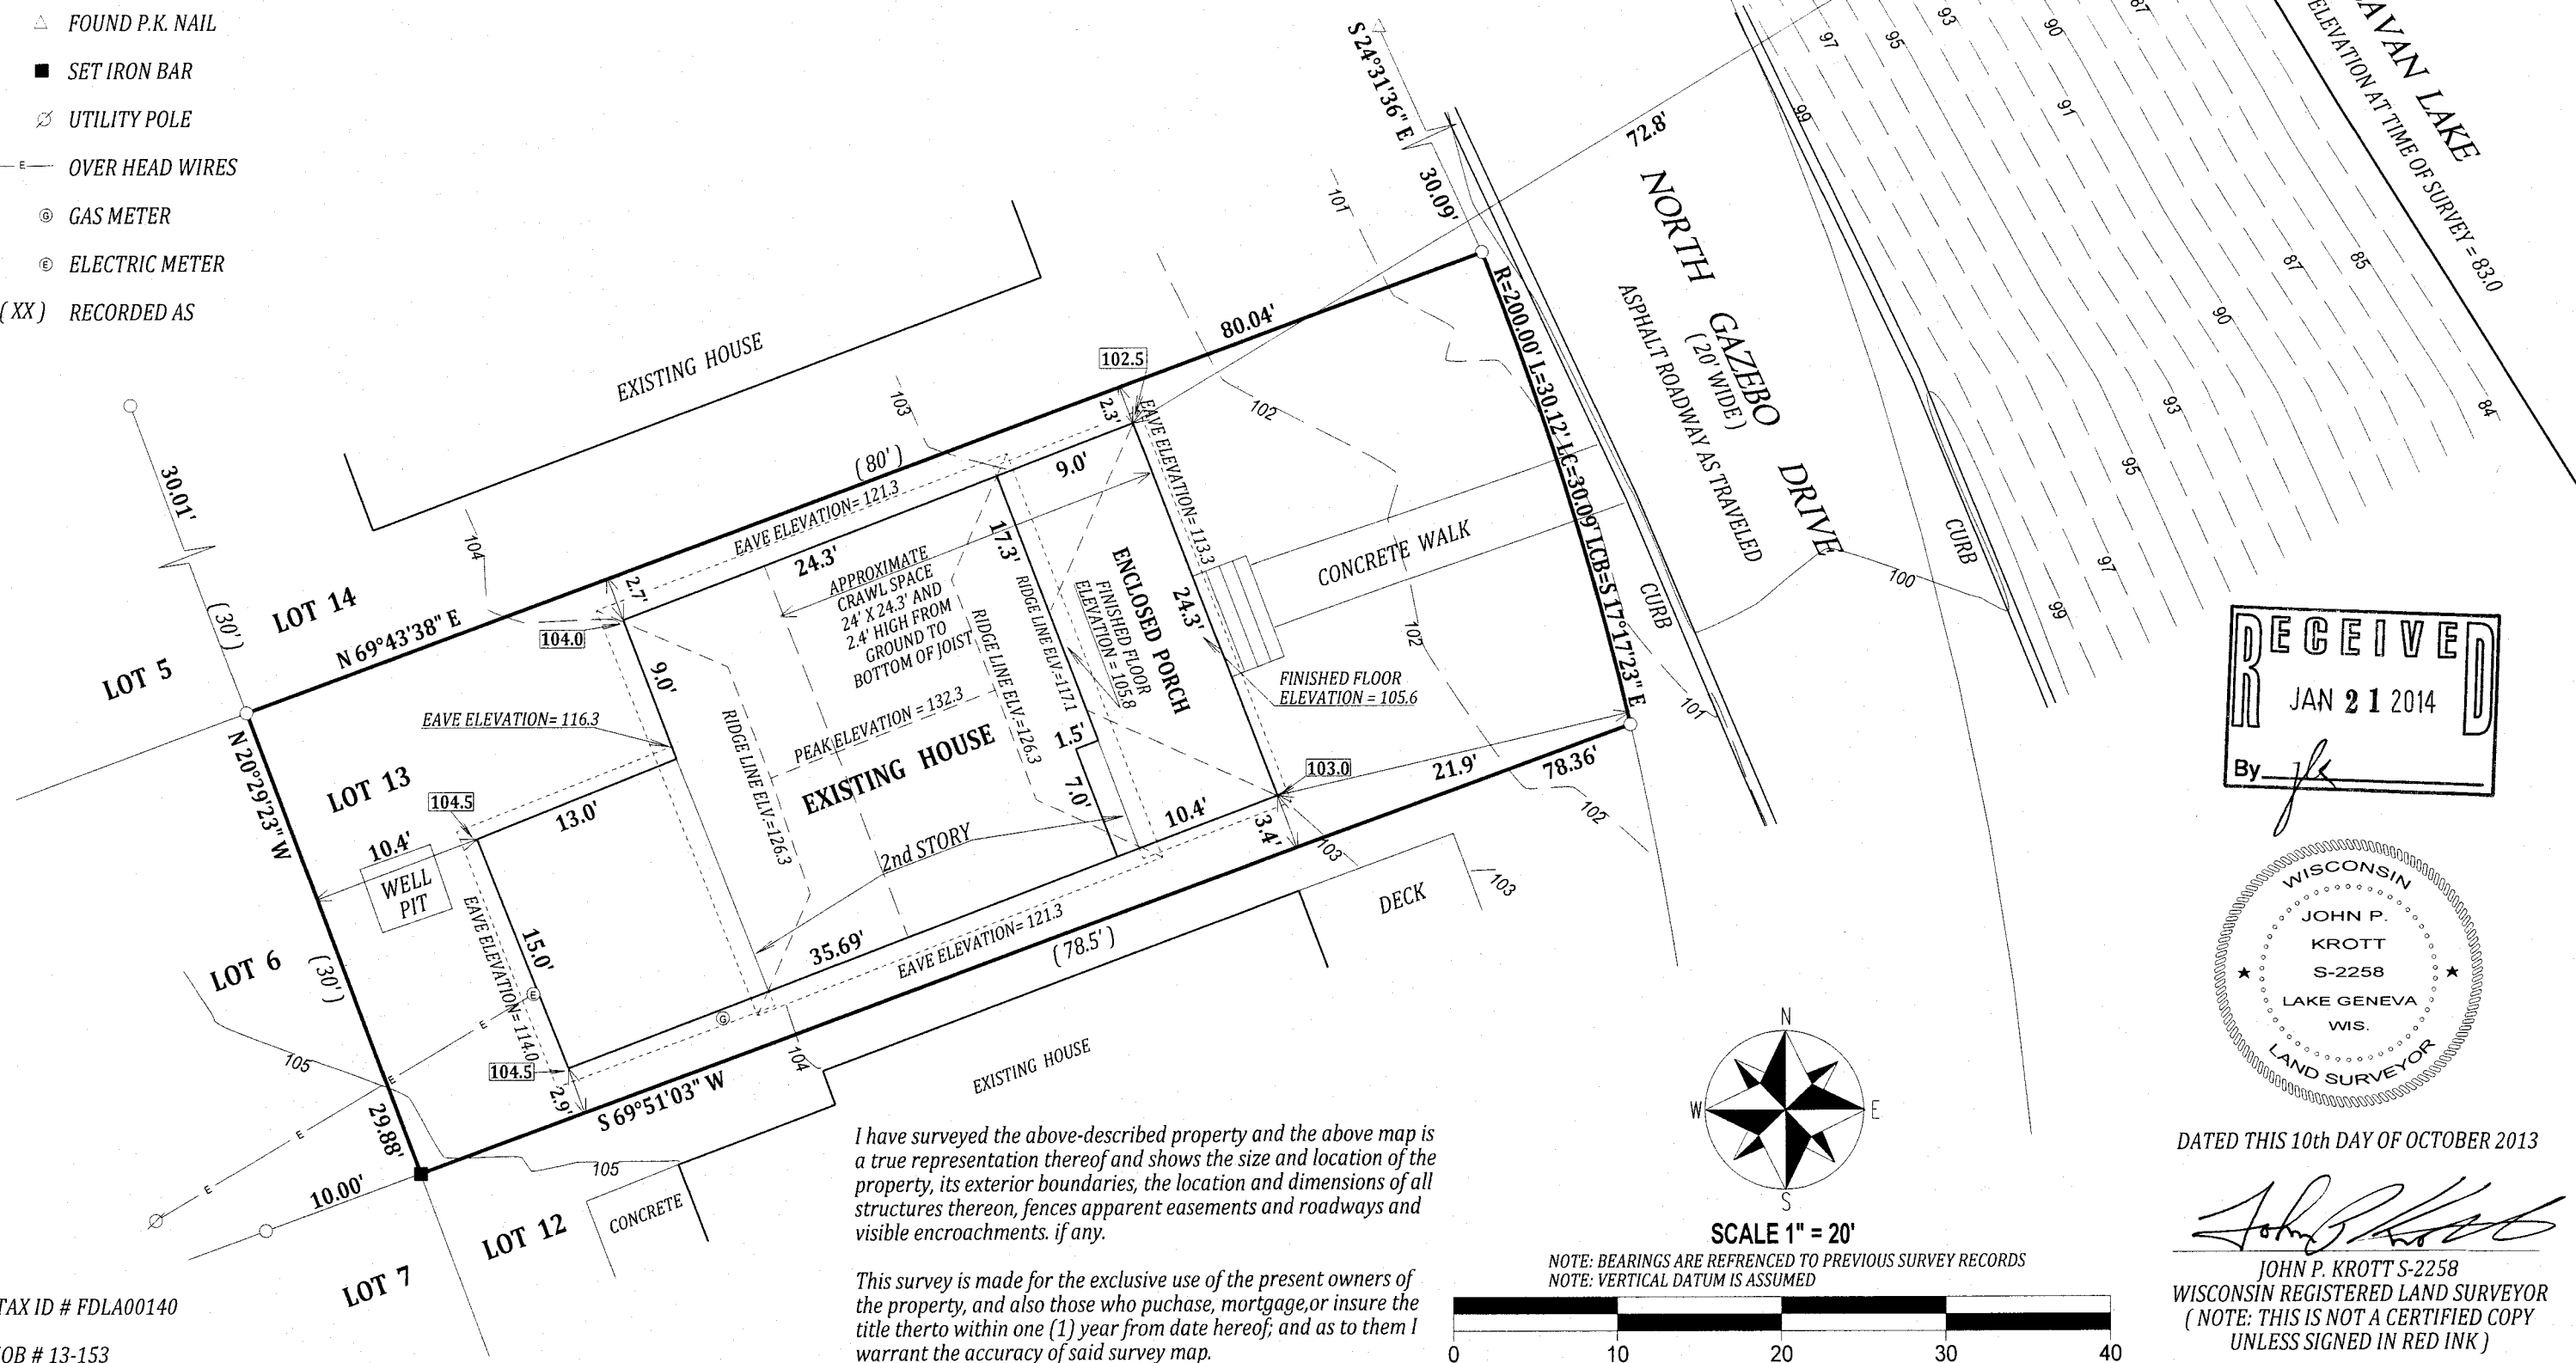

TAX ID # FDLA00140
JOB # 13-153

NOTE: BEARINGS ARE REFERENCED TO PREVIOUS SURVEY RECORDS
NOTE: VERTICAL DATUM IS ASSUMED

0 10 20 30 40

FdLA - 140

216-5083