


APR 01 2014

4/1/2014 4: X:\Projects\8033\8033_14\0000\Survey Topo

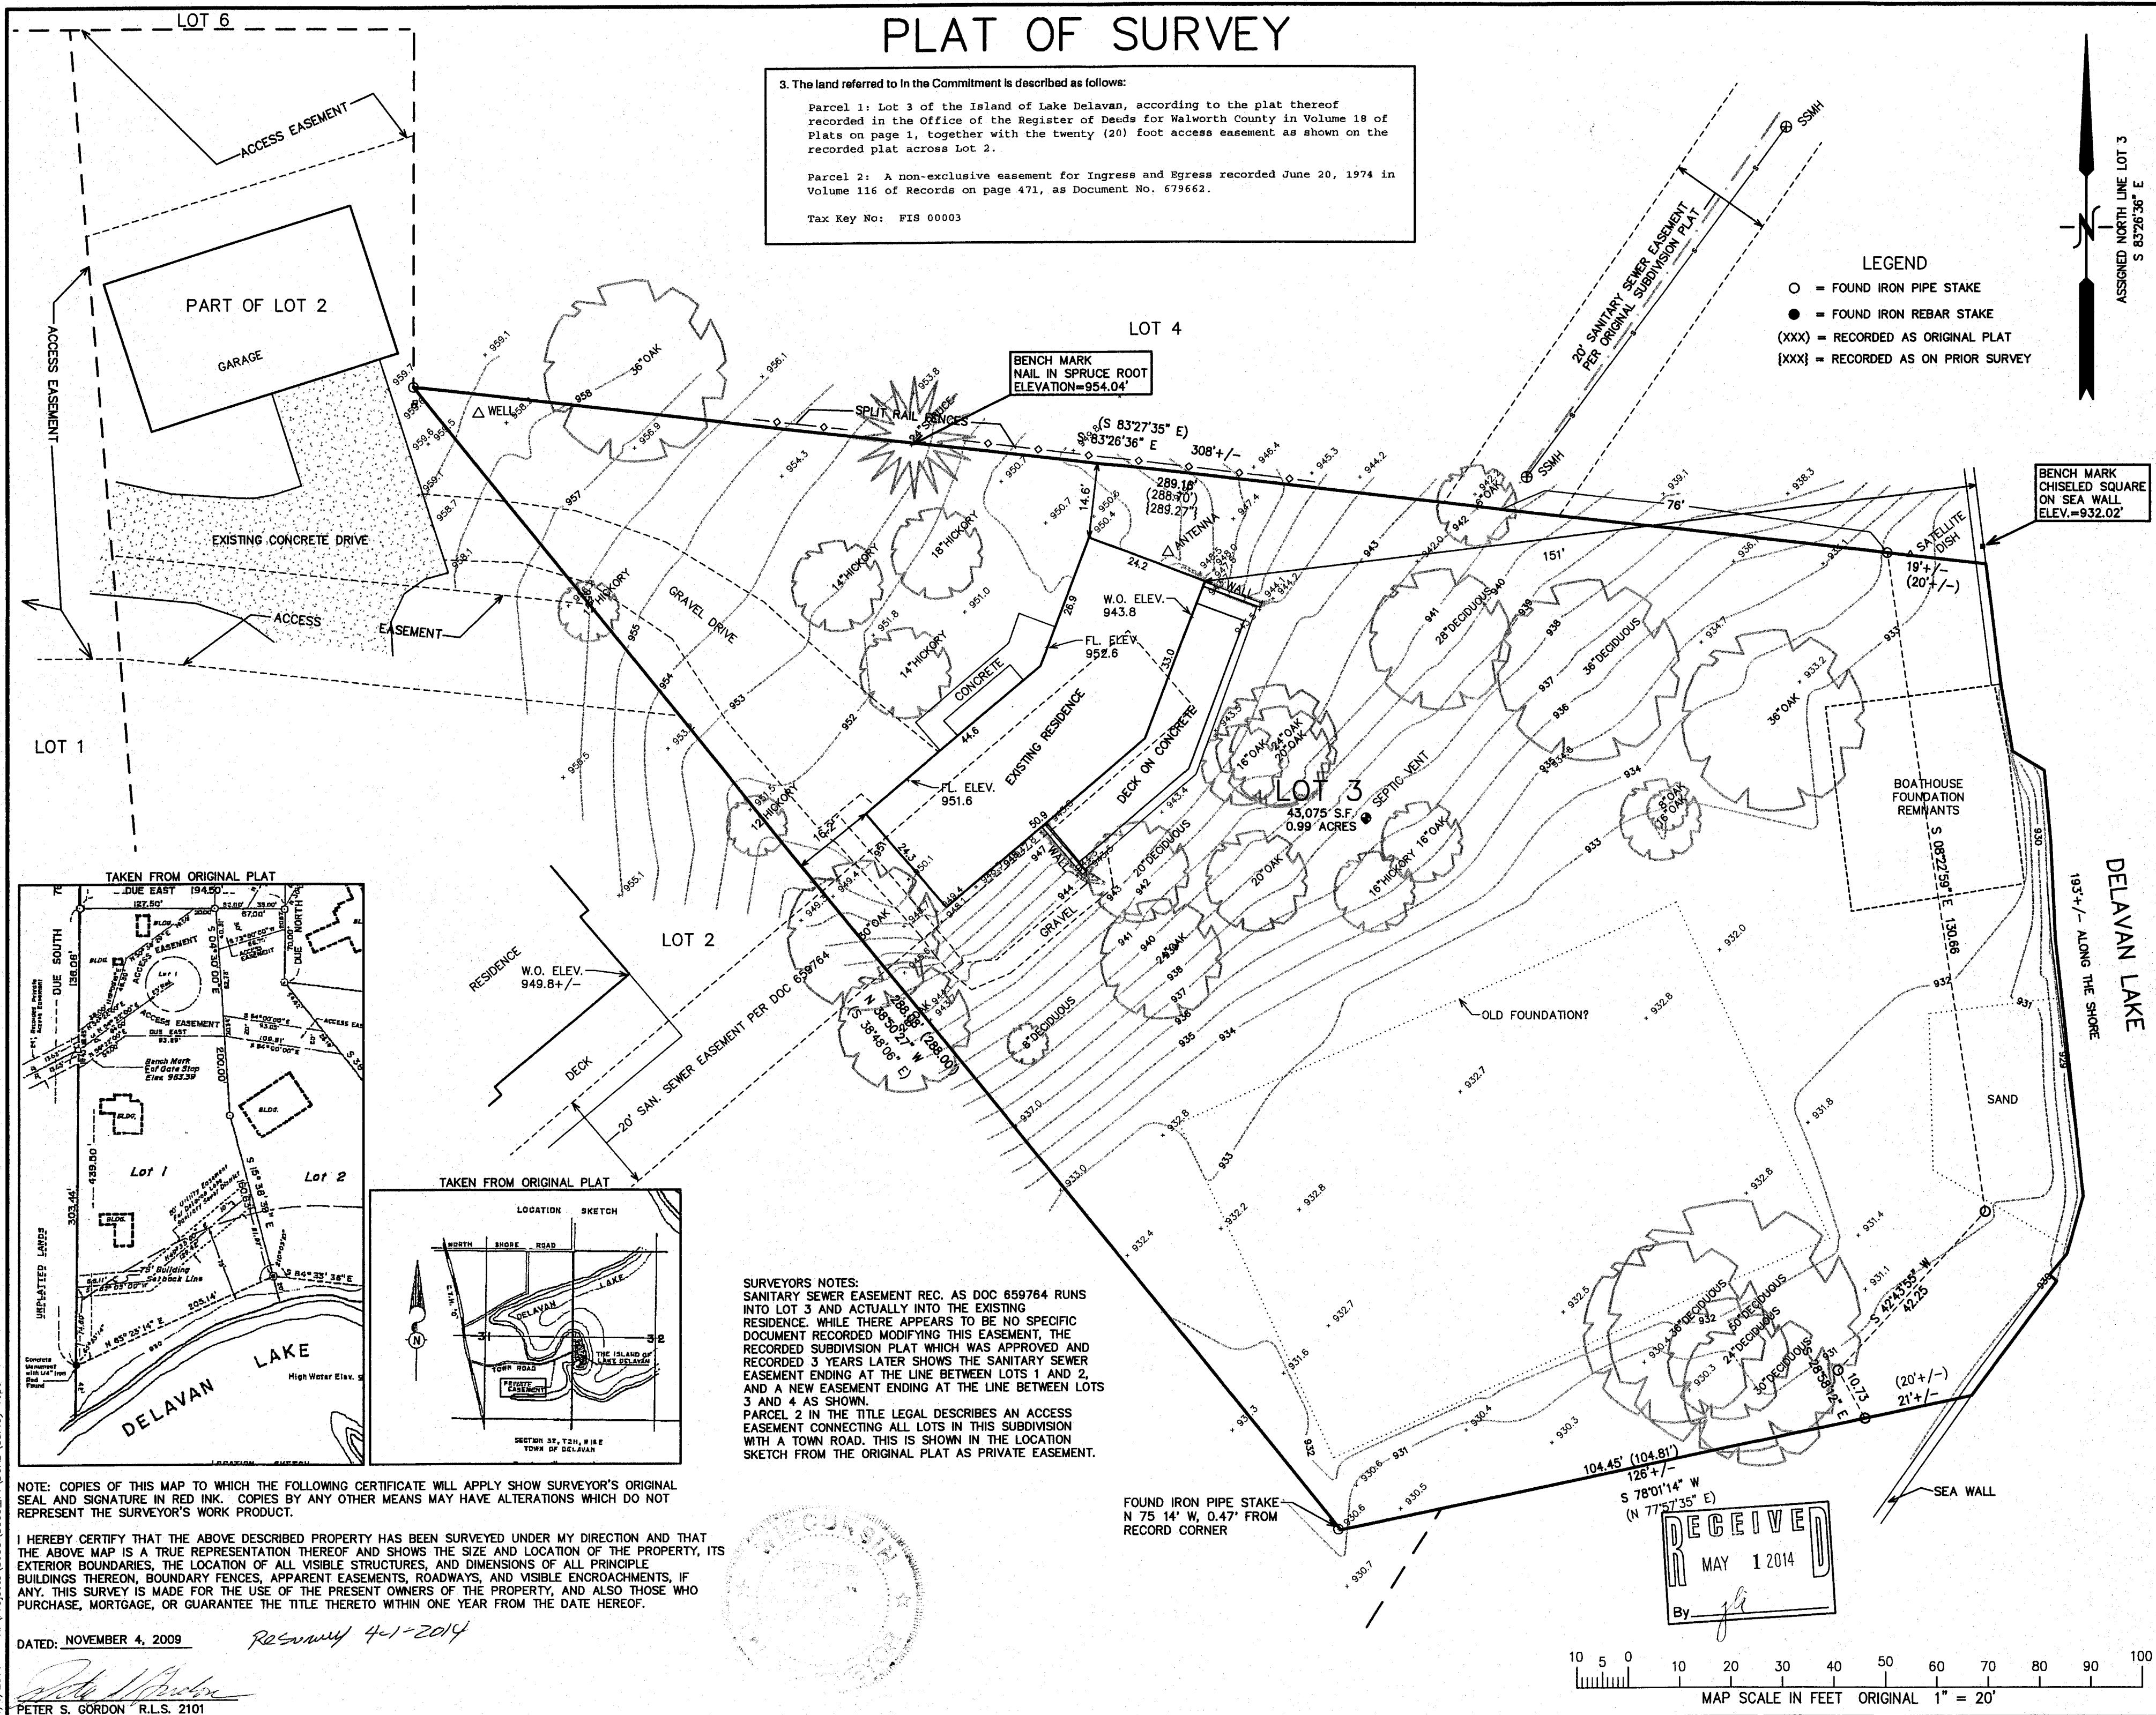

— WORK ORDERED BY —
LAURA TARNOW
3303 BAY ROAD
DELAVAN, WI 53115

FARRIS, HANSEN & ASSOCIATES, INC.
ENGINEERING — ARCHITECTURE — SURVEYING
7 RIDGEWAY COURT P.O. BOX 437
ELKHORN, WISCONSIN 53121
OFFICE: (262) 723-2098 FAX: (262) 723-5886

REVISIONS
3/31/2014 LK
ADD TOPO, ETC

PROJECT NO.
8033.14

DATE:
11-03-2009

SHEET NO.
1 OF 1

FIS -3

216-5093