

FARRIS, HANSEN & ASSOCIATES, INC.

ENGINEERING - ARCHITECTURE - SURVEYING
 7 RIDGWAY COURT - P.O. BOX 437 - ELKHORN, WISCONSIN 53121
 PHONE: (262) 723-2098 FAX: (262) 723-5886

PLAT OF SURVEY


LOTS 162 AND 163 OF LAKE DELAVAN HIGHLANDS SUBDIVISION
 LOCATED IN SECTION 31, TOWN 2 NORTH RANGE 16 EAST,
 WALWORTH COUNTY, WISCONSIN

- WORK ORDERED BY -
 ANTHONY SCHROEDER
 719 E. LEMOYN AVENUE
 LOMBARD, IL 60148

LEGEND

- = FOUND IRON PIPE STAKE
- {XXX} = RECORDED AS
- AREA = 12,502 S.F. (0.29 AC.)



EAST LINE OF SPRUCE STREET ASSIGNED
 N 00°00'00" W

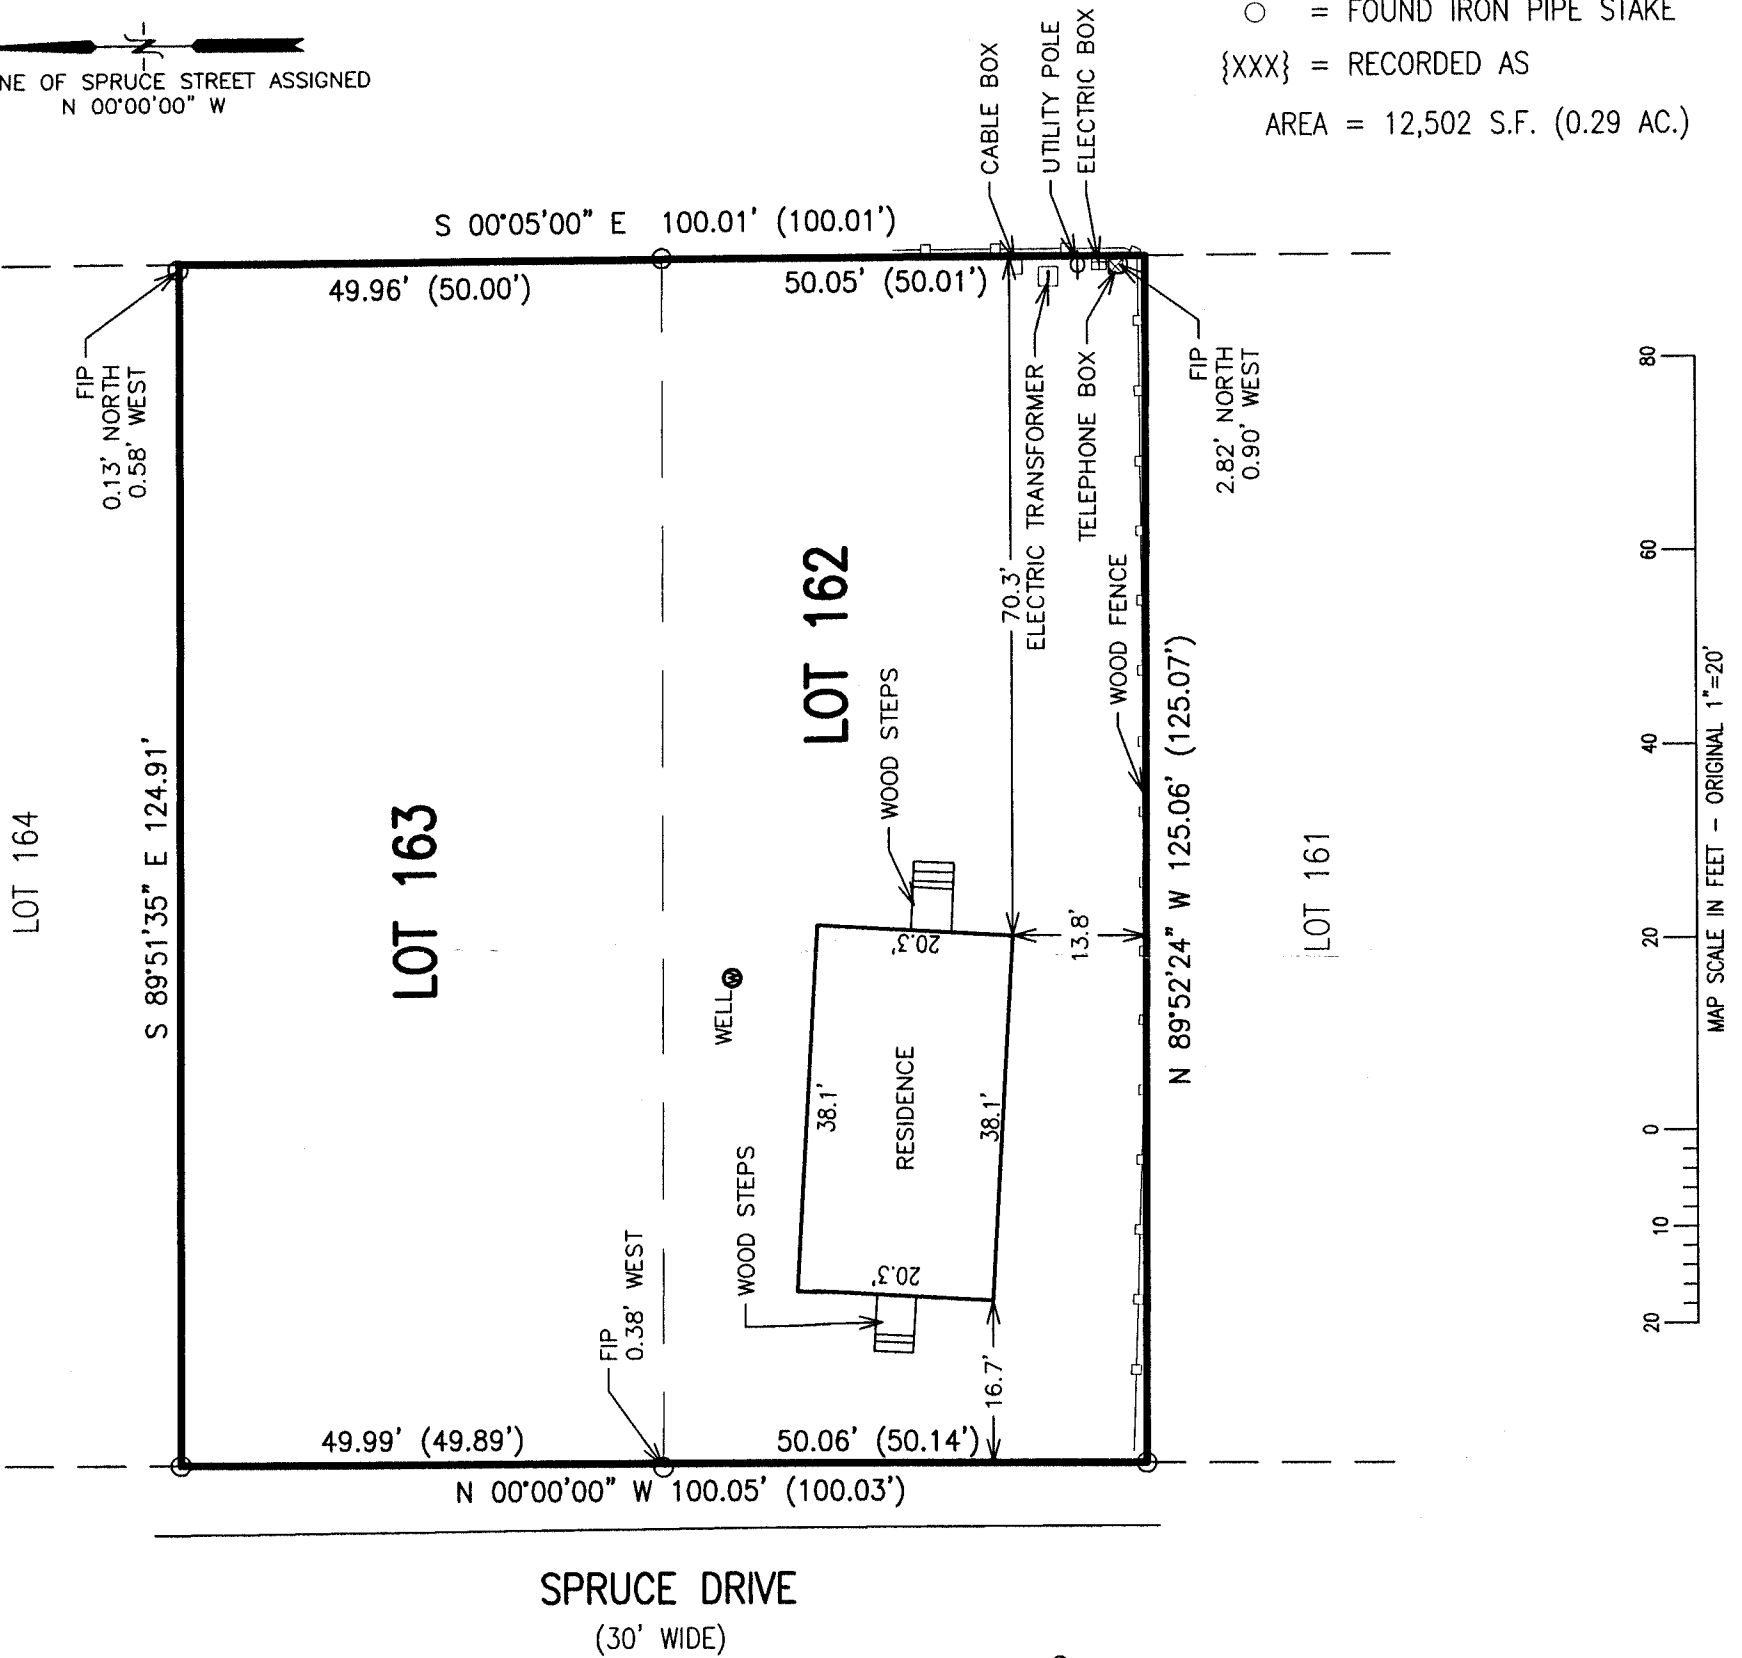

NOTE: COPIES OF THIS MAP TO WHICH THE FOLLOWING CERTIFICATE WILL APPLY SHOW THE SURVEYOR'S ORIGINAL SEAL AND SIGNATURE IN RED INK. COPIES BY ANY OTHER MEANS MAY HAVE ALTERATIONS WHICH DO NOT REPRESENT THE SURVEYOR'S WORK PRODUCT.

I HEREBY CERTIFY THAT THE ABOVE DESCRIBED PROPERTY HAS BEEN SURVEYED UNDER MY DIRECTION AND THAT THE ABOVE MAP IS A TRUE REPRESENTATION THEREOF AND SHOWS THE SIZE AND LOCATION OF THE PROPERTY AND ITS EXTERIOR BOUNDARIES. THIS SURVEY IS MADE FOR THE USE OF THE PRESENT OWNERS OF THE PROPERTY, AND ALSO THOSE WHO PURCHASE, MORTGAGE, OR GUARANTEE THE TITLE THERETO WITHIN ONE YEAR FROM THE DATE HEREOF.

DATED: 04/14/2014

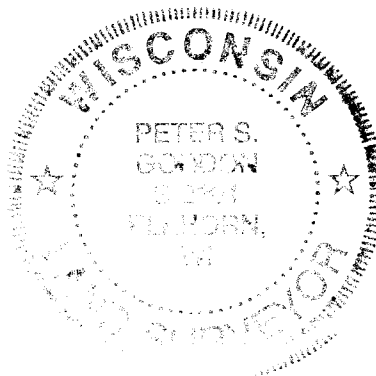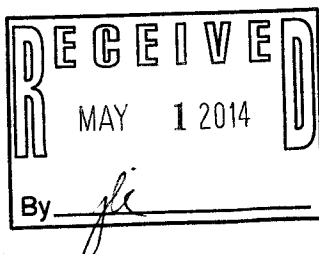

Peter S. Gordon
 PETER S. GORDON R.L.S. 2101

PROJECT: 9004
 DATE: 04/14/2014
 SHEET 1 OF 1

FLAD -129

216-5094