

LAND-MARK SURVEYING
Mark L. Miritz
Wisconsin Registered Land Surveyor S-2582


N9330 Knuteson Drive
Whitewater, WI 53190
Phone: (262) 495-3284
MARKMIRITZ@
LAND-MARKSURVEYING.COM

LOT 73 AND LOT 74, LAKE DELAVAN HIGHLANDS SUBDIVISION,
LOCATED IN THE SOUTHEAST 1/4 OF SECTION 31, TOWN 2 NORTH,
RANGE 16 EAST, DELAVAN TOWNSHIP, WALWORTH COUNTY,
WISCONSIN.

OWNERS: PATRICK R. MIHALSKI
FRANCES D. MIHALSKI
4237 CENTER STREET
LYONS, IL 60534

SITE ADDRESS: 4237 CENTRAL BLVD., DELAVAN, WI 53115

PLAT OF SURVEY

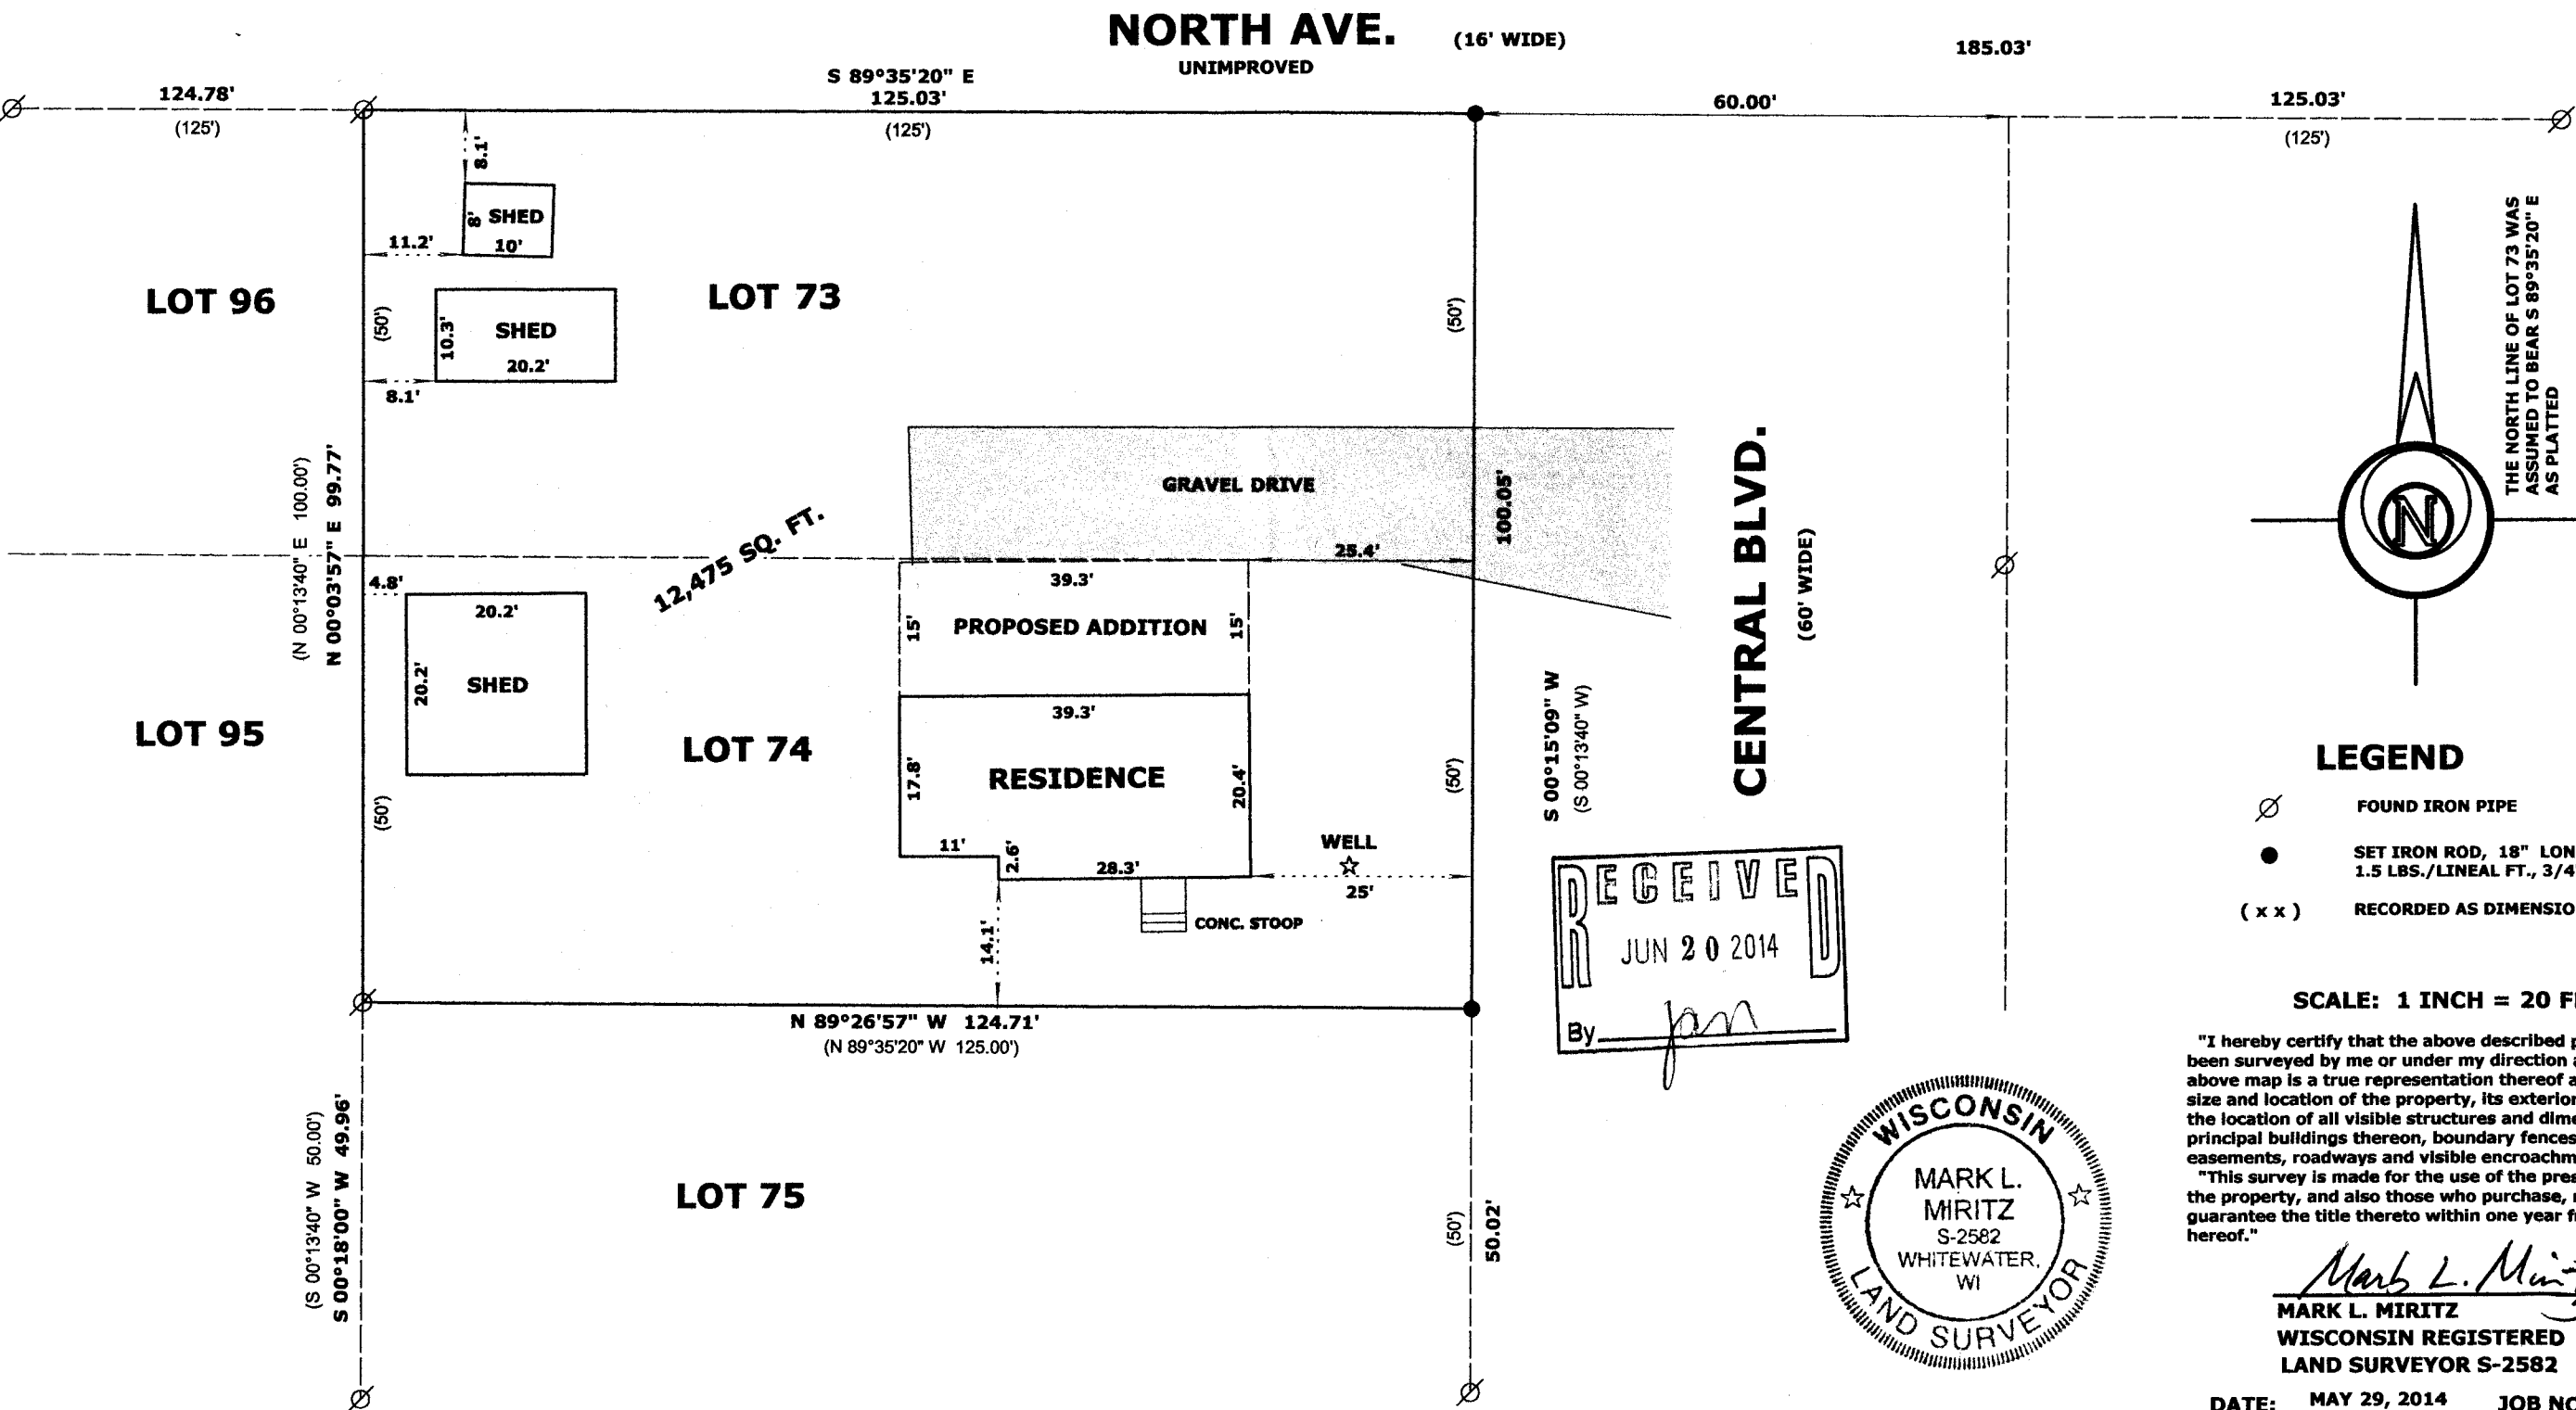

FLAD-62
FLAD-63

216-5095