


FARRIS, HANSEN & ASSOCIATES, INC.

ENGINEERING - ARCHITECTURE - SURVEYING
 7 RIDGWAY COURT - P.O. BOX 437 - ELKHORN, WISCONSIN 53121
 PHONE: (262) 723-2098 FAX: (262) 723-5886



PLAT OF SURVEY

LOT 9 OF TOWN OF DELAVAN ASSESSOR'S PLAT NO. 1
 LOCATED IN PART OF GOV.T LOT 2 OF SECTION 27
 TOWN 2 NORTH, RANGE 16 EAST
 WALWORTH COUNTY, WISCONSIN

- WORK ORDERED BY -
 TIM OPFER
 28845 HARVEST GLEN CIRCLE
 CARY, IL. 60013

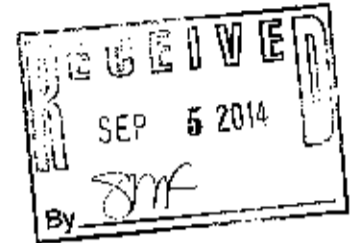

ASSIGNED THE NORTHEASTERLY LINT OF LOT 9
 S 42°39'11" E

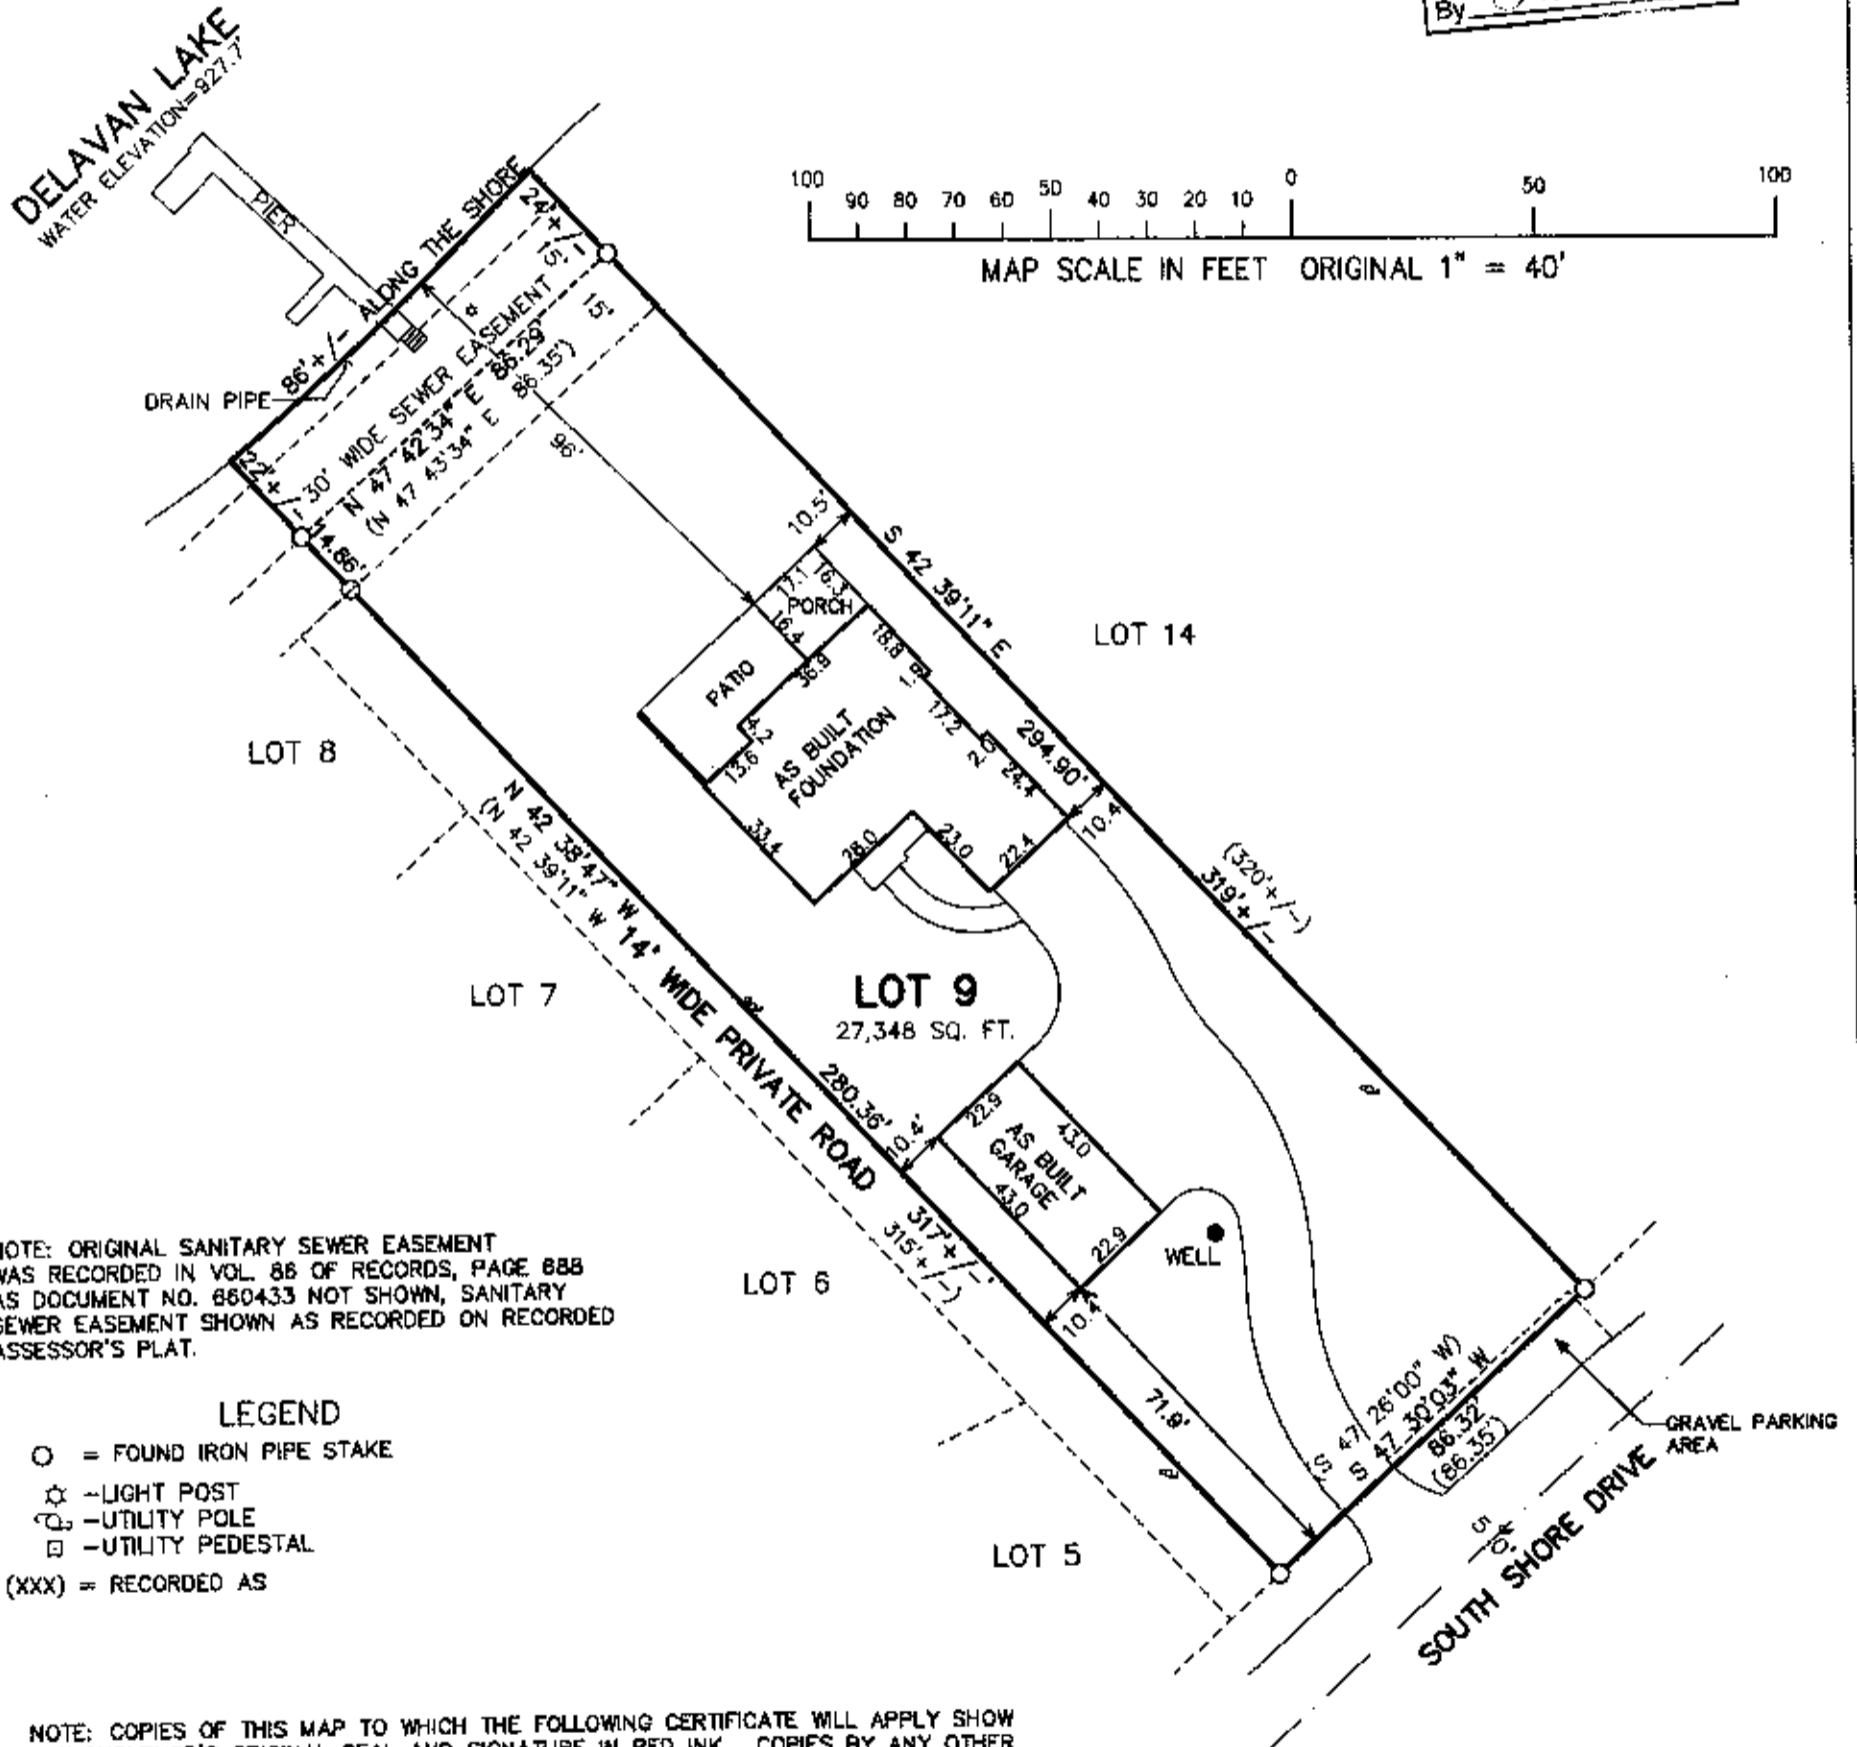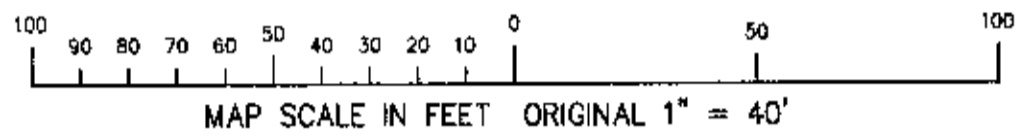

NOTE: ORIGINAL SANITARY SEWER EASEMENT
 WAS RECORDED IN VOL. 86 OF RECORDS, PAGE 888
 AS DOCUMENT NO. 860433 NOT SHOWN, SANITARY
 SEWER EASEMENT SHOWN AS RECORDED ON RECORDED
 ASSESSOR'S PLAT.

LEGEND

- = FOUND IRON PIPE STAKE
- ☆ = LIGHT POST
- ⊙ = UTILITY POLE
- ⊞ = UTILITY PEDESTAL
- (XXX) = RECORDED AS

NOTE: COPIES OF THIS MAP TO WHICH THE FOLLOWING CERTIFICATE WILL APPLY SHOW
 THE SURVEYOR'S ORIGINAL SEAL AND SIGNATURE IN RED INK. COPIES BY ANY OTHER
 MEANS MAY HAVE ALTERATIONS WHICH DO NOT REPRESENT THE SURVEYOR'S WORK
 PRODUCT.

I HEREBY CERTIFY THAT THE ABOVE DESCRIBED PROPERTY HAS BEEN SURVEYED UNDER
 MY DIRECTION AND THAT THE ABOVE MAP IS A TRUE REPRESENTATION THEREOF AND
 SHOWS THE SIZE AND LOCATION OF THE PROPERTY, ITS EXTERIOR BOUNDARIES, THE
 LOCATION OF ALL VISIBLE STRUCTURES, AND DIMENSIONS OF ALL PRINCIPLE
 BUILDINGS THEREON, BOUNDARY FENCES, APPARENT EASEMENTS, ROADWAYS, AND
 VISIBLE ENCROACHMENTS, IF ANY. THIS SURVEY IS MADE FOR THE USE OF THE
 PRESENT OWNERS OF THE PROPERTY, AND ALSO THOSE WHO PURCHASE, MORTGAGE, OR
 GUARANTEE THE TITLE THERETO WITHIN ONE YEAR FROM THE DATE HEREOF.

DATED: MAY 15, 2012

Peter S. Gordon
 PETER S. GORDON

REVISED 07-17-2012
 TO SHOW SIZE & LOCATION OF
 AS BUILT RESIDENCE & GARAGE

REVISED 8/5/2014-KB
 UPDATE SURVEY



PROJECT: 8577
 DATE: 05-15-2015
 SHEET 1 OF 1

8/5/2014 X:\Projects\8577\dcad\title

FAP-9

8/10-5/25