

# FARRIS, HANSEN & ASSOCIATES, INC.

ENGINEERING — ARCHITECTURE — SURVEYING  
7 RIDGWAY COURT — P.O. BOX 437 — ELKHORN, WISCONSIN 53121  
PHONE: (262) 723-2098 FAX: (262) 723-5886


## PLAT OF SURVEY

LOT 33 OF BLOCK 1 OF SOUTH SHORE MANOR SUBDIVISION  
LOCATED IN PART OF THE NW 1/4 OF THE SE 1/4 OF  
SECTION 32, TOWN 2 NORTH, RANGE 16 EAST,  
WALWORTH COUNTY, WISCONSIN

— WORK ORDERED BY —  
KAREN FERRARD  
2410 LAKE SHORE DRIVE  
DELAVER, WI 53115


### LEGEND

O = FOUND IRON PIPE STAKE  
{XXX} = RECORDED AS

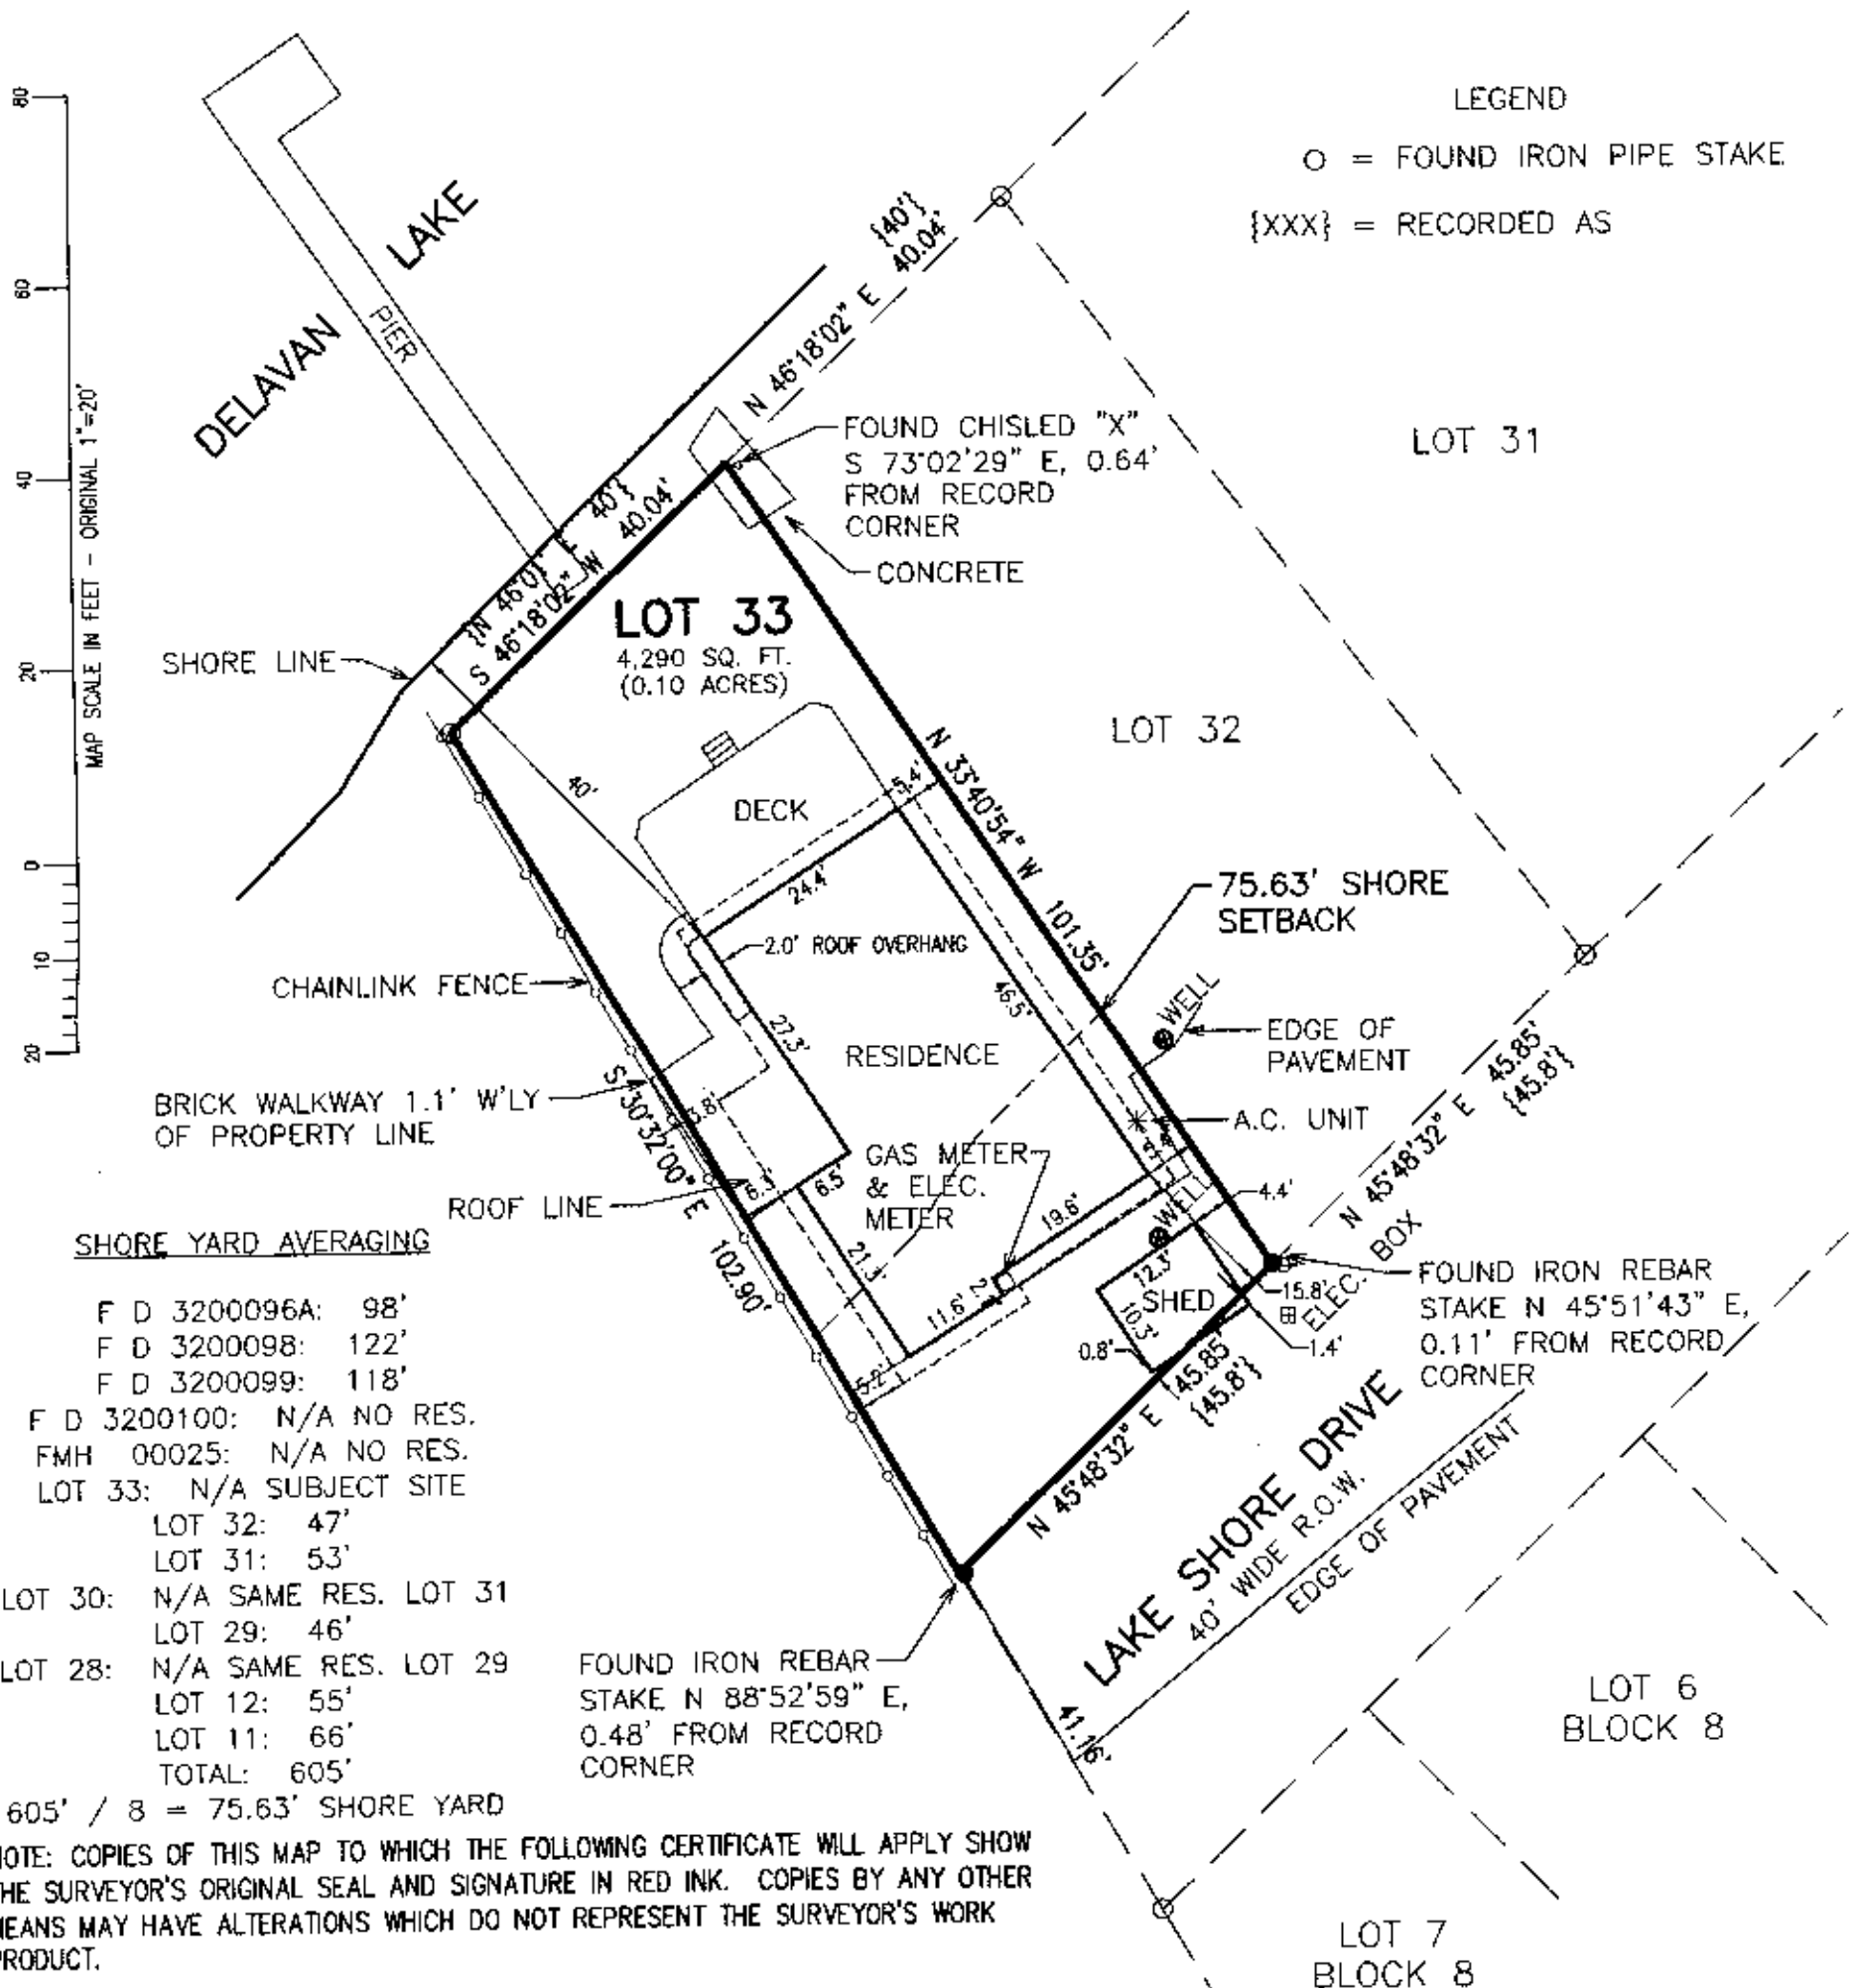

DATED: 6/25/2014

PETER S. GORDON R.L.S. 2101

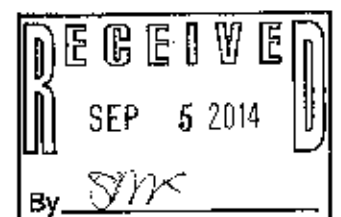

PROJECT: 9062  
DATE: 06/25/2014  
SHEET 1 OF 1

FSS-27

216-5127