



FARRIS, HANSEN & ASSOCIATES, INC.

ENGINEERING — ARCHITECTURE — SURVEYING
7 RIDGWAY COURT — P.O. BOX 437 — ELKHORN, WISCONSIN 53121
PHONE: (262) 723-2098 FAX: (262) 723-5886

PLAT OF SURVEY

LOTS 20 & 21 OF BLOCK 1
SOUTH SHORE MANOR
LOCATED IN THE SE 1/4 SECTION 32
TOWN 2 NORTH, RANGE 16 EAST
WALWORTH COUNTY, WISCONSIN


— WORK ORDERED BY —
THOMAS KNUTSON
453 SPRING CRESS COURT
WEST CHICAGO, IL. 60185

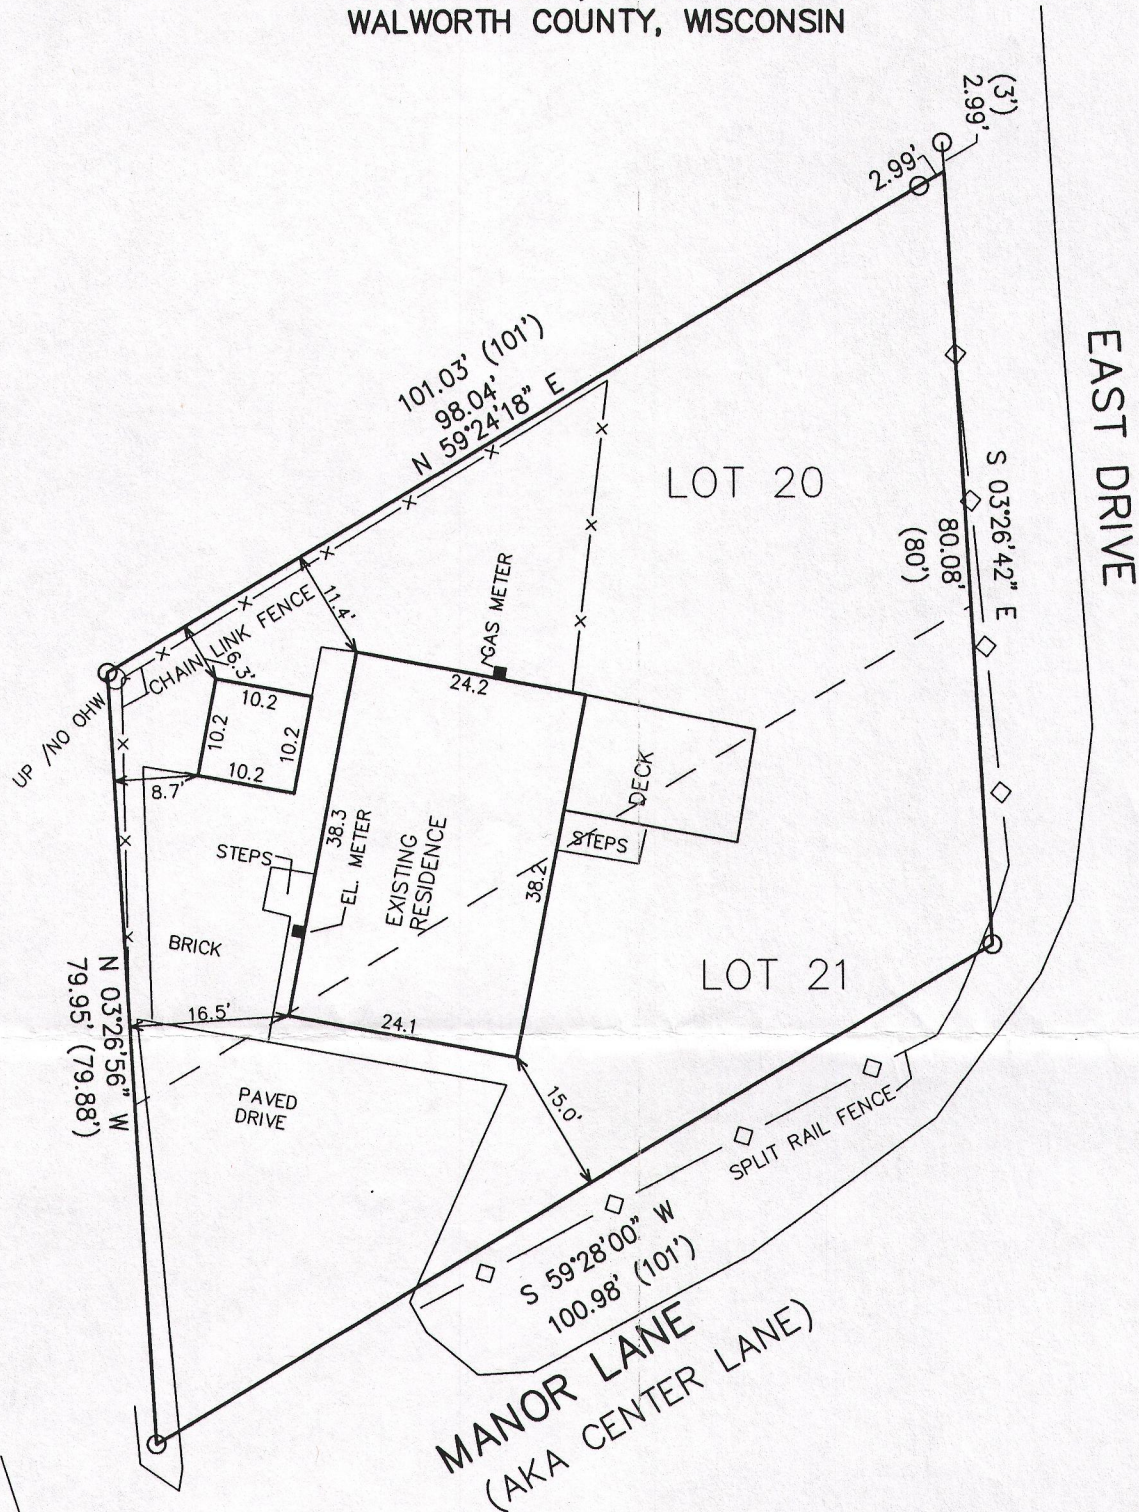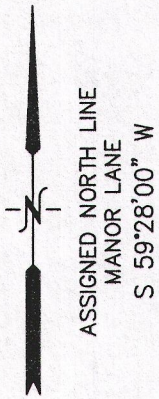

EAST DRIVE

LEGEND

○ = FOUND IRON PIPE STAKE
(xxx) = RECORDED AS


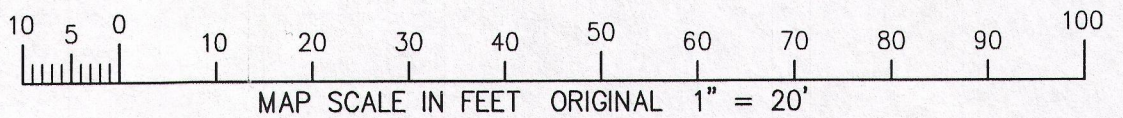


NOTE: COPIES OF THIS MAP TO WHICH THE FOLLOWING CERTIFICATE WILL APPLY SHOW THE SURVEYOR'S ORIGINAL SEAL AND SIGNATURE IN RED INK. COPIES BY ANY OTHER MEANS MAY HAVE ALTERATIONS WHICH DO NOT REPRESENT THE SURVEYOR'S WORK PRODUCT.

I HEREBY CERTIFY THAT THE ABOVE DESCRIBED PROPERTY HAS BEEN SURVEYED UNDER MY DIRECTION AND THAT THE ABOVE MAP IS A TRUE REPRESENTATION THEREOF AND SHOWS THE SIZE AND LOCATION OF THE PROPERTY AND ITS EXTERIOR BOUNDARIES. THIS SURVEY IS MADE FOR THE USE OF THE PRESENT OWNERS OF THE PROPERTY, AND ALSO THOSE WHO PURCHASE, MORTGAGE, OR GUARANTEE THE TITLE THERETO WITHIN ONE YEAR FROM THE DATE HEREOF.

DATED: NOVEMBER 17, 2014

Peter S. Gordon
PETER S. GORDON R.L.S. 2101

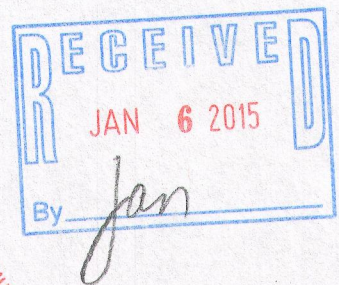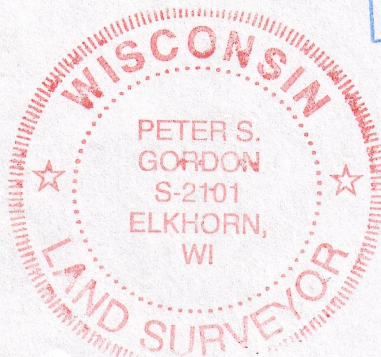

PROJECT: 9187
DATE: 11-17-2014
SHEET 1 OF 1