

LAND-MARK SURVEYING

Mark L. Miritz

Wisconsin Professional Land Surveyor S-2582

N9330 Knuteson Drive  
Whitewater, WI 53190  
Phone: (262) 495-3284  
MARKMIRITZ@



LAND-MARKSURVEYING.COM

PLAT OF SURVEY


LOT 34 OF OAK MEADOWS SUBDIVISION, BEING A SUBDIVISION LOCATED IN THE NORTHEAST 1/4 OF SECTION 29, TOWN 2 NORTH, RANGE 16 EAST, DELAVAN TOWNSHIP, WALWORTH COUNTY, WISCONSIN.

OWNER:  
PAMELA S. PREDICK AMENDED &  
RESTATED REVOCABLE LIVING TRUST  
2023 GREEN MEADOW DRIVE  
DELAVAN, WI 53115

GREEN MEADOW DRIVE  
(66' WIDE)

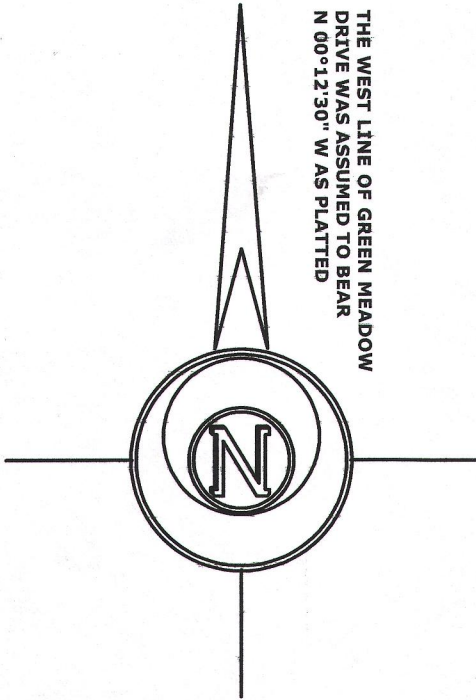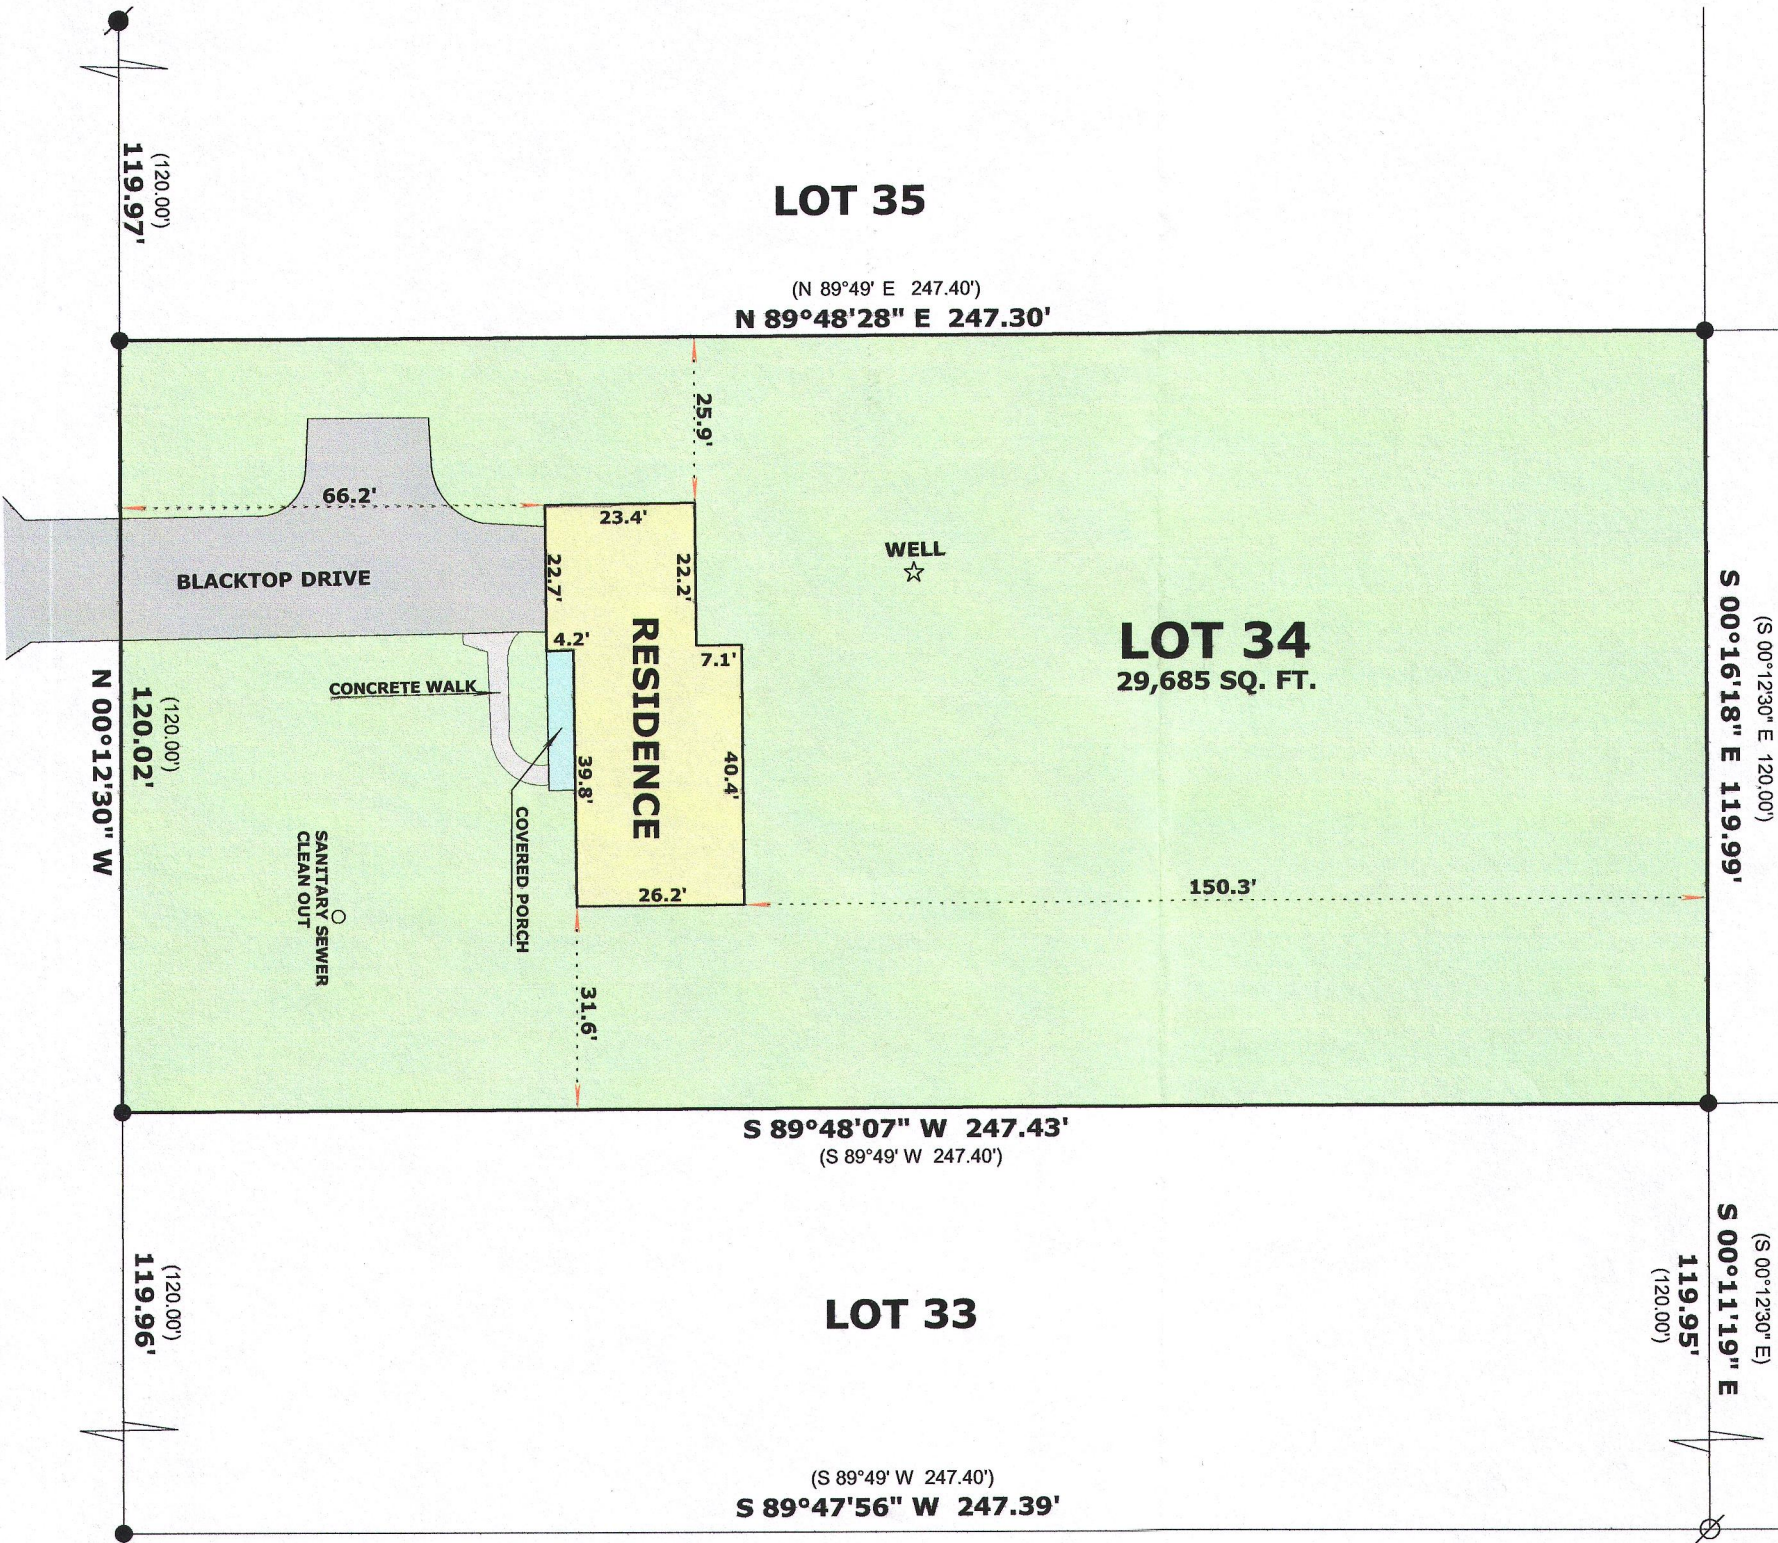

LOT 27

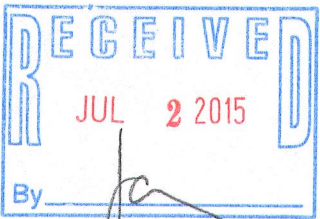

FOM 8-34

216-5215