


BOUNDARY & TOPOGRAPHIC MAPPING  
PART OF THE SE 1/4 OF THE SW 1/4 SECTION 29  
TOWN 2 NORTH, RANGE 16 EAST  
WALWORTH COUNTY, WISCONSIN


All that certain piece or parcel of land lying and being in the SE 1/4 of the SW 1/4 of Section 29, T2N, R16E, to-wit: Beginning at a point in the 1/8 Section line running East and West through the SW 1/4 of said Section 29, 413-1/2 feet East of the NE corner of the West one-half of the SE 1/4 of said SW 1/4 of Section 29, running thence South parallel with and 413-1/2 feet East of the East line of lands conveyed to Jane T. Moulding by deed recorded in Office of the Register of Deeds for Walworth County, Wisconsin, in Volume 127 of Deeds on page 406, to the shore of Delavan Lake; thence Easterly along the shore of Delavan Lake 50 feet more or less to a point 200 feet West of the East line of said SW 1/4 of Section 29; thence North parallel with and 200 feet West of the E. line of said Southwest quarter of Section 29 to said 1/8 section line, thence West 50 feet more or less to the place of beginning.

Tax Key No: F D 2900014A

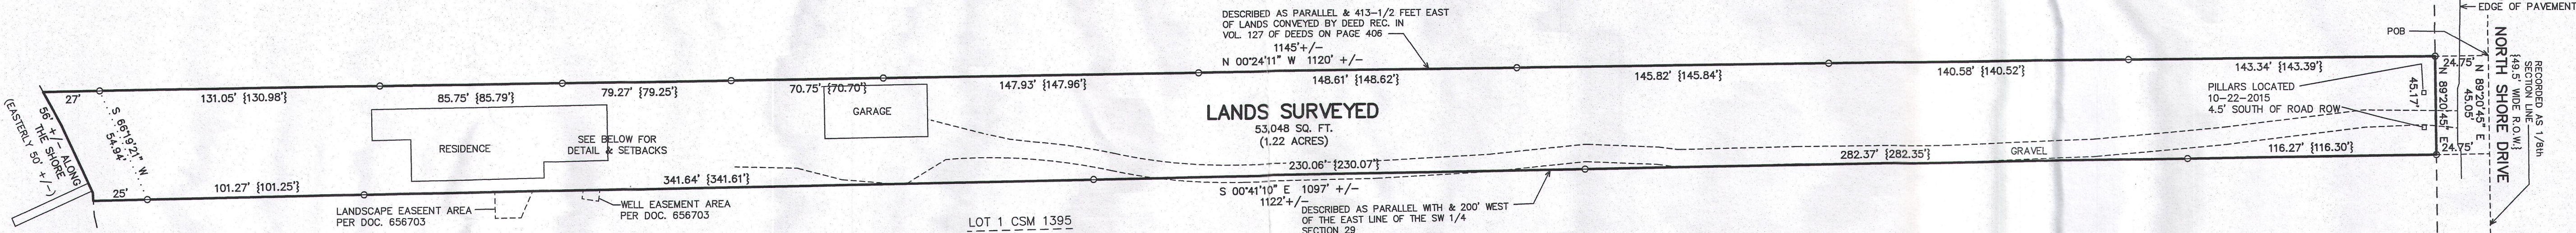


LEGEND  
○ = FOUND IRON PIPE STAKE  
{xxx} = RECORDED AS  
GROSS AREA SURVEYED = 54,165 S.F. (1.24 ACRES)  
NET AREA EXCLUSIVE OF ROAD ROW = 53,048 S.F. (1.22 AC.)

MAP SCALE IN FEET ORIGINAL 1" = 40'

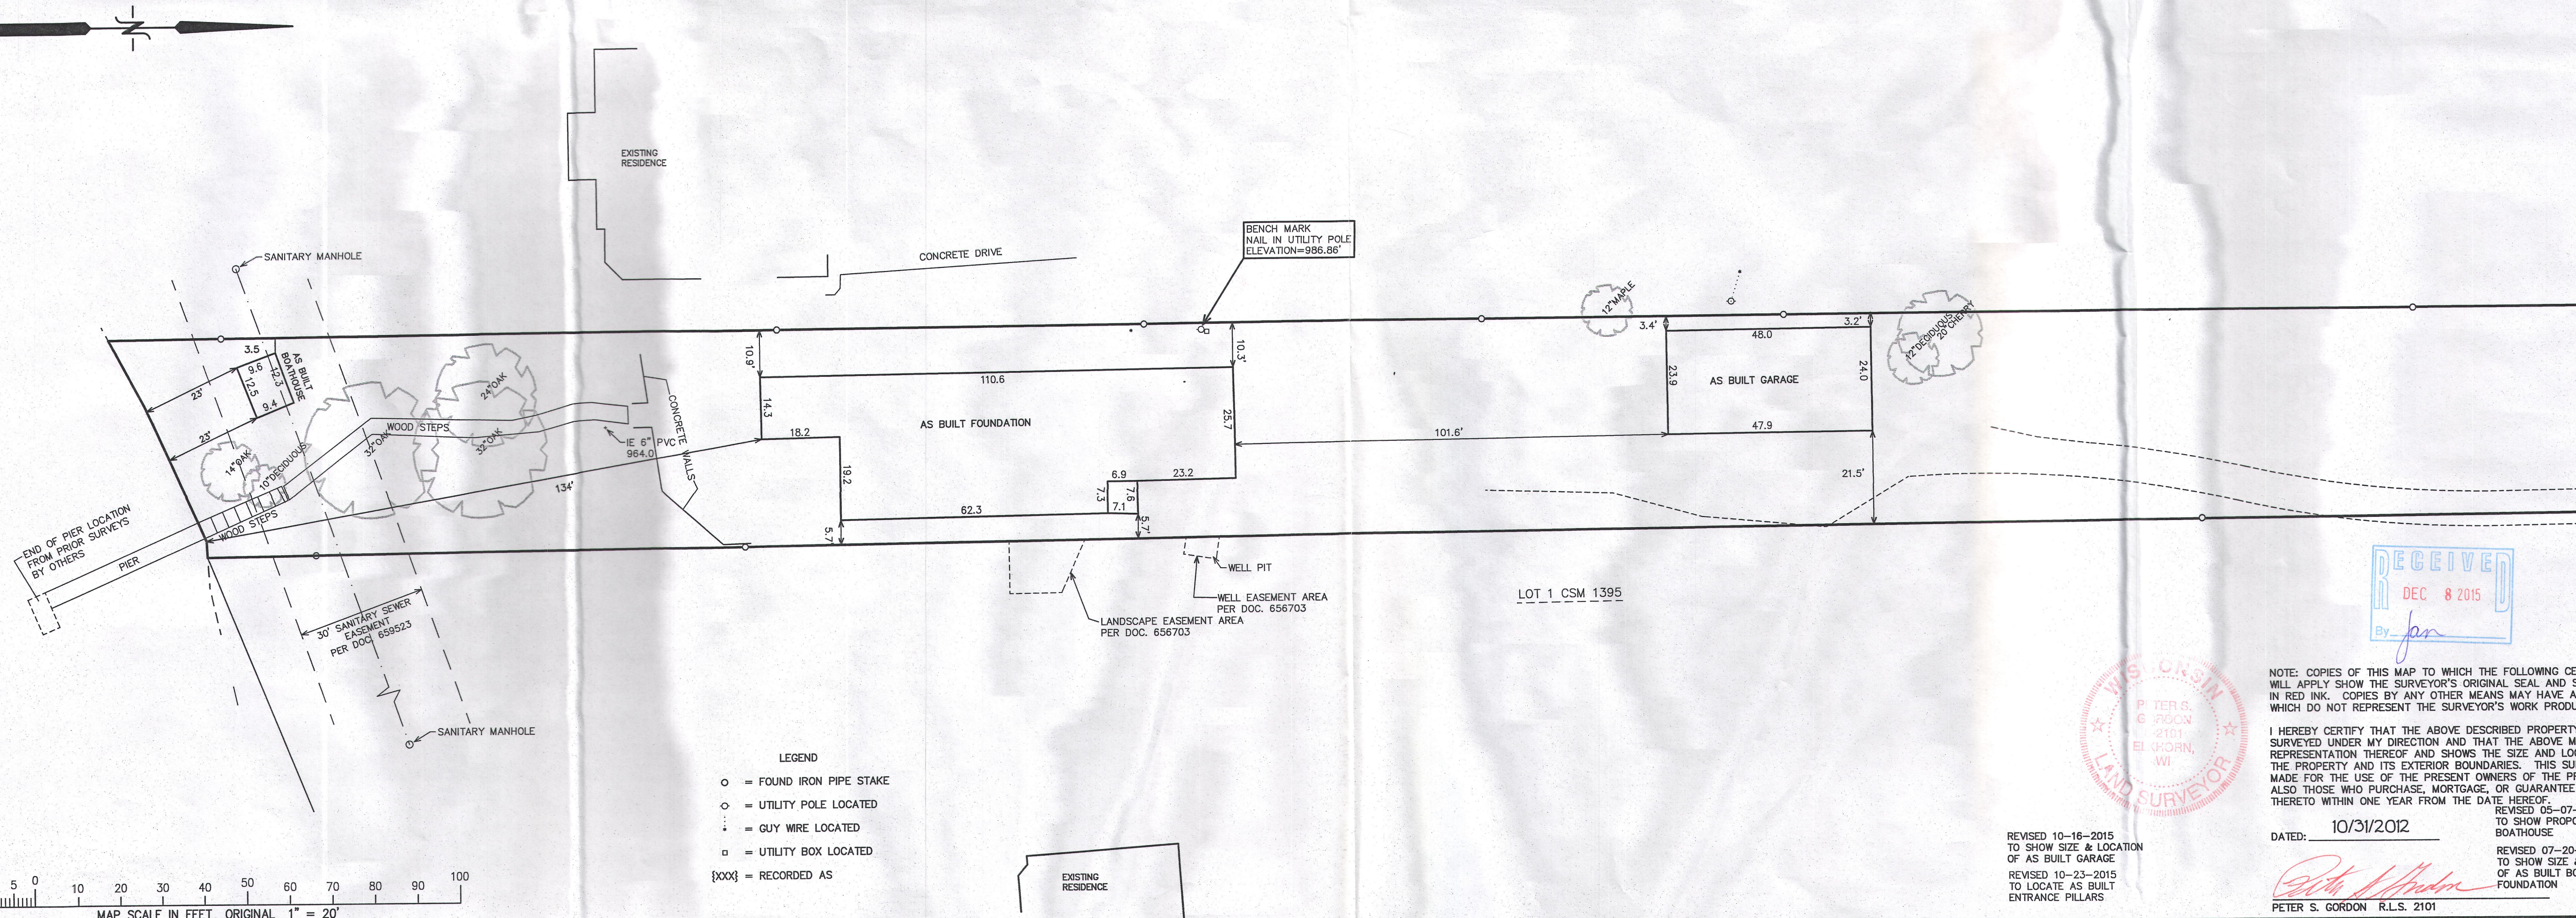

LEGEND  
○ = FOUND IRON PIPE STAKE  
○ = UTILITY POLE LOCATED  
○ = GUY WIRE LOCATED  
○ = UTILITY BOX LOCATED  
{xxx} = RECORDED AS

MAP SCALE IN FEET ORIGINAL 1" = 20'

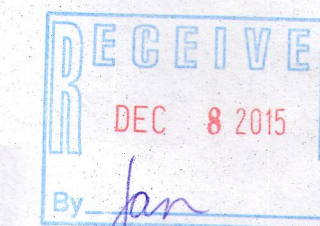

NOTE: COPIES OF THIS MAP TO WHICH THE FOLLOWING CERTIFICATE WILL APPLY SHOW THE SURVEYOR'S ORIGINAL SEAL AND SIGNATURE IN RED INK. COPIES BY ANY OTHER MEANS MAY HAVE ALTERATIONS WHICH DO NOT REPRESENT THE SURVEYOR'S WORK PRODUCT.

I HEREBY CERTIFY THAT THE ABOVE DESCRIBED PROPERTY HAS BEEN SURVEYED UNDER MY DIRECTION AND THAT THE ABOVE MAP IS A TRUE REPRESENTATION THEREOF AND SHOWS THE SIZE AND LOCATION OF THE PROPERTY AND ITS EXTERIOR BOUNDARIES. THIS SURVEY IS MADE FOR THE USE OF THE PRESENT OWNERS OF THE PROPERTY, AND ALSO THOSE WHO PURCHASE, MORTGAGE, OR GUARANTEE THE TITLE THERETO WITHIN ONE YEAR FROM THE DATE HEREOF.

REVISOR 07-20-2014 TO SHOW SIZE & LOCATION OF AS BUILT BOATHOUSE & FOUNDATION

REVISOR 10-16-2015 TO SHOW SIZE & LOCATION OF AS BUILT GARAGE

REVISOR 10-23-2015 TO LOCATE AS BUILT ENTRANCE PILLARS

REVISOR 05-07-2013 TO SHOW PROPOSED BOATHOUSE

DATE: 10/31/2012

PETER S. GORDON R.L.S. 2101

FARRIS, HANSEN & ASSOCIATES, INC.  
ENGINEERING - ARCHITECTURE - SURVEYING  
7 RIDGWAY COURT P.O. BOX 437  
ELKHORN, WISCONSIN 53121

REVISIONS  
01-29-2013  
ADD ADJUTING RESIDEN

PROJECT NO.  
8690  
DATE  
10/23/2012  
SHEET NO.  
1 OF 1