
LAND-MARK SURVEYING

Mark L. Miritz

Wisconsin Professional Land Surveyor S-2582

N9330 Knuteson Drive Whitewater, WI 53190 Phone: (262)495-3284 MARKMIRITZ@



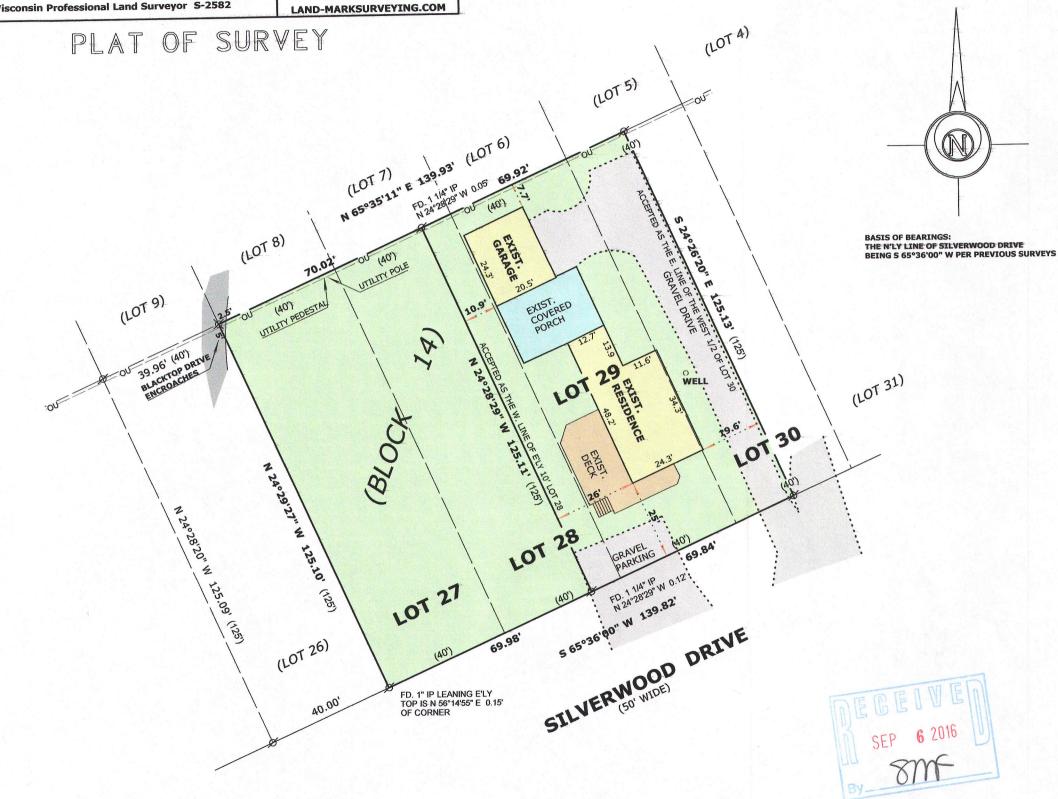

PARCEL 1

THE WEST 1/2 OF LOT 30 AND LOT 29 AND THE EASTERLY 10 FEET OF LOT 28, ALL IN BLOCK 14 OF DELAVAN LAKE VIEW CREST SUBDIVIION LOCATED IN THE NORTHWEST 1/4 OF SECTION 31, TOWNSHIP 2 NORTH, RANGE 16 EAST, IN THE TOWN OF DELAVAN, WALWORTH COUNTY, WISCONSIN

PARCEL 2

CONS

MARK L.

MIRITZ

S-2582 WHITEWATER

LOT 27 AND LOT 28, EXCEPT THE EASTERLY 10 FEET OF SAID LOT 28, ALL IN BLOCK 14 OF DELAVAN LAKE VIEW **CREST SUBDIVIION** LOCATED IN THE NORTHWEST 1/4 OF SECTION 31, TOWNSHIP 2 NORTH, RANGE 16 EAST, IN THE TOWN OF **DELAVAN, WALWORTH COUNTY, WISCONSIN**

ORDERED BY: MARK LARKIN **KEEFE REAL ESTATE 751 GENEVA PARKWAY LAKE GENEVA, WI 53147**

LEGEND

FOUND IRON PIPE

FOUND PK NAIL X

RECORDED AS DIMENSION (xx)

-0U--0U- **OVERHEAD UTILITY LINES**

SCALE: 1 INCH = 30 FEET

"I hereby certify that the above described property has been surveyed by me or under my direction and that the above map is a true representation thereof and shows the size and location of the property, its exterior boundaries, the location of all visible structures and dimensions of all principal buildings thereon, boundary fences, apparent easements, roadways and visible encroachments, if any."

"This survey is made for the use of the present owners of the property, and also those who purchas

MARK L. MIRITZ WISCONSIN PROFESSIONAL

LAND SURVEYOR S-2582

DATE: JULY 26, 2016 JOB NO. 16.715

FDLV-65 FDLV-65A