
## FARRIS, HANSEN & ASSOC. INC.

PLAT OF SURVEY

7 RIDGWAY COURT— P.O. BOX 437 LOT 10 OF BLOCK 14 OF INLET OAKS SUBDIVISION NO. 5
ELKHORN, WSCONSIN 53121
PHONE (262) 723—2098
FAX (262) 723—5886
LOCATED IN THE SE 1/4 SECTION 15, TOWN 2 NORTH, RANGE 16 EAST
WALWORTH COUNTY, WSCONSIN

ORDERED BY: JASON DOWNING 528 VALENCIA DRIVE

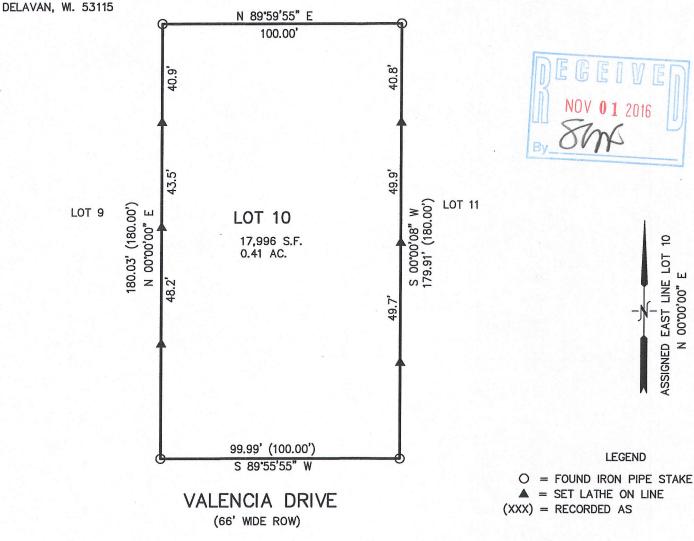

NOTE: COPIES OF THIS MAP TO WHICH THE FOLLOWING CERTIFICATE WILL APPLY SHOW SURVEYOR'S ORIGINAL SEAL AND SIGNATURE IN RED INK. COPIES BY ANY OTHER MEANS MAY HAVE ALTERATIONS WHICH DO NOT REPRESENT THE SURVEYOR'S WORK PRODUCT.

I HEREBY CERTIFY THAT THE ABOVE DESCRIBED PROPERTY HAS BEEN SURVEYED UNDER MY DIRECTION AND THAT THE ABOVE MAP IS A TRUE REPRESENTATION THEREOF AND SHOWS THE SIZE AND LOCATION OF THE PROPERTY AND ITS EXTERIOR BOUNDARIES. THIS SURVEY IS MADE FOR THE USE OF THE PRESENT OWNERS OF THE PROPERTY, AND ALSO THOSE WHO PURCHASE, MORTGAGE, OR GUARANTEE THE TITLE THERETO WITHIN ONE YEAR FROM THE DATE HEREOF.

PETER S.
GORDON
S-2101
ELKHORN,
WI
ONE

E

SURVE

E

SURVE

E

SURVE

MI
ONE

DATED: SEPTEMBER 26, 2016

PETER S. GORDON R.L.S. 2101

SEP 26 2016 FIN5-48

PROJECT NO. 9610 DATED: 09-26-2016 SHEET 1 OF 1 SHEETS

216-5327