



ENGINEERING — ARCHITECTURE — SURVEYING
7 RIDGWAY COURT — P.O. BOX 437 — ELKHORN, WISCONSIN 53121
PHONE: (262) 723-2098 FAX: (262) 723-5886

LOT 15 OF BLOCK D DELAVAN LAKE ASSEMBLY GROUNDS
LOCATED IN THE NW 1/4 OF THE SE 1/4 SEC. 21
T2N, R16E, WALWORTH COUNTY, WI.


ASSIGNED EAST LINE LOT 15
S 10°02'19" E


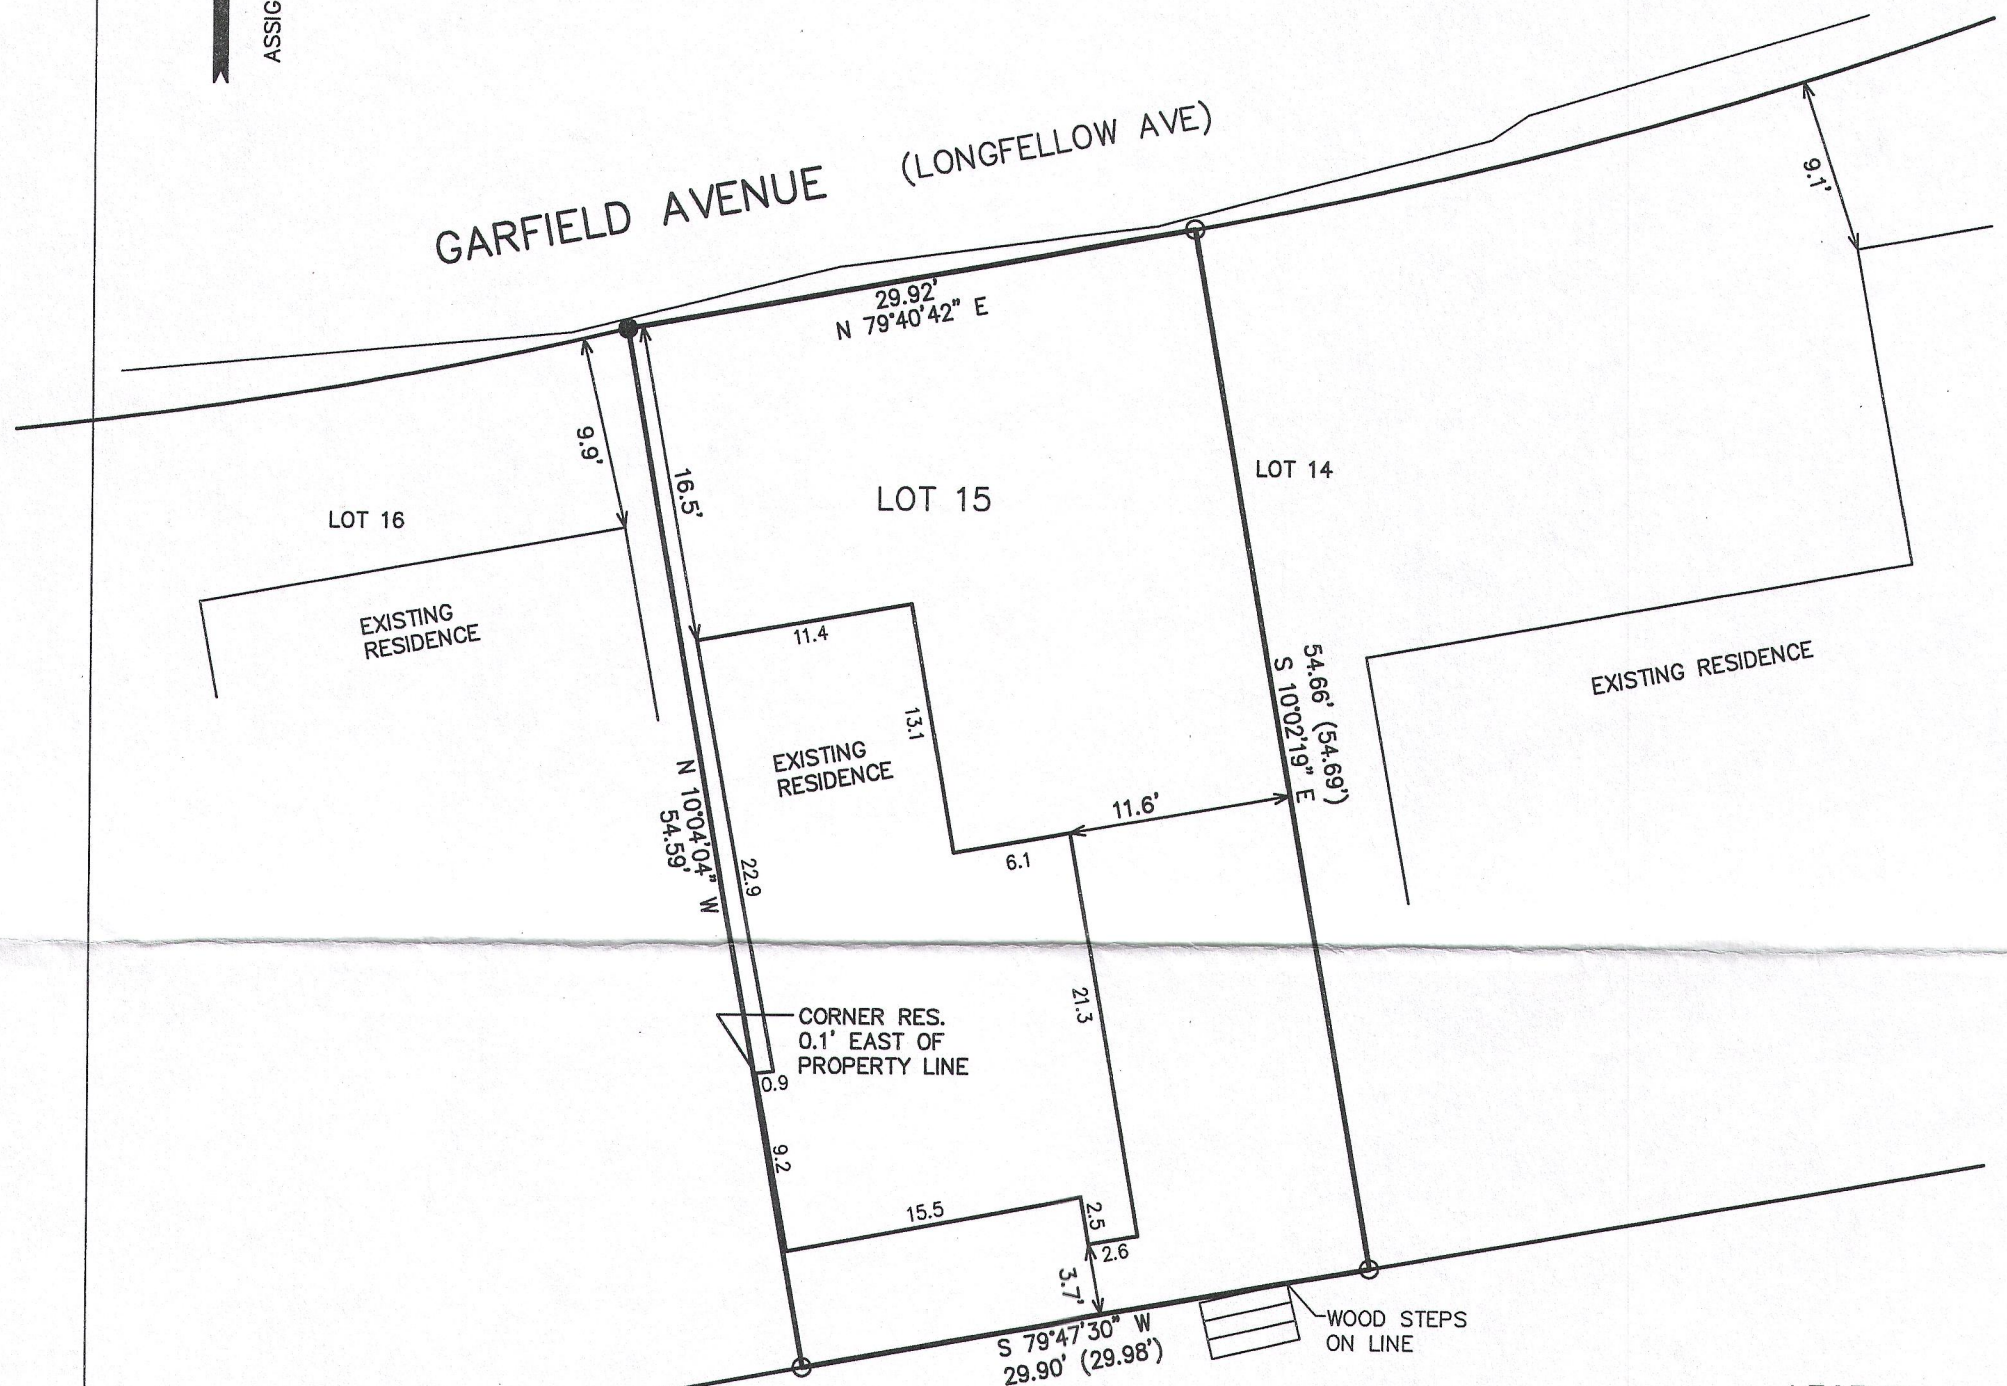


○ = FOUND IRON PIPE STAKE
● = SET IRON REBAR STAKE
(XXX) = RECORDED AS
AREA = 1635 S.F.

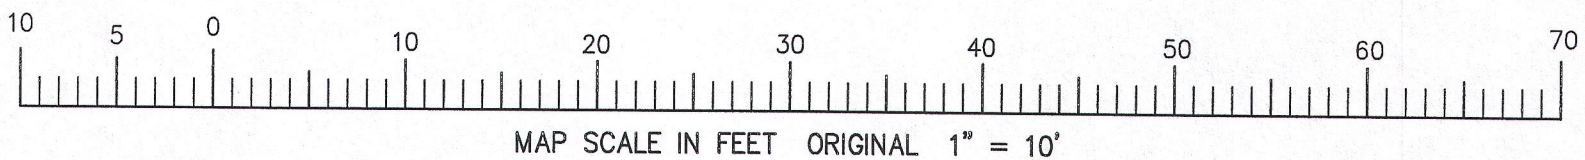

I HEREBY CERTIFY THAT THE ABOVE DESCRIBED PROPERTY HAS BEEN SURVEYED UNDER MY DIRECTION AND THAT THE ABOVE MAP IS A TRUE REPRESENTATION THEREOF AND SHOWS THE SIZE AND LOCATION OF THE PROPERTY AND ITS EXTERIOR BOUNDARIES. THIS SURVEY IS MADE FOR THE USE OF THE PRESENT OWNERS OF THE PROPERTY, AND ALSO THOSE WHO PURCHASE, MORTGAGE, OR GUARANTEE THE TITLE THERETO WITHIN ONE YEAR FROM THE DATE HEREOF.


PETER S. GORDON P.L.S. 2101

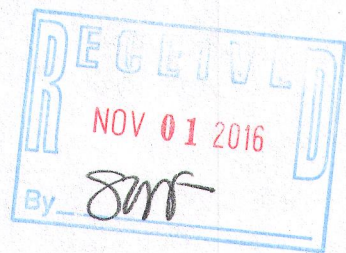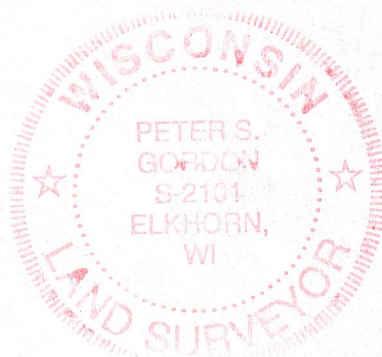

PROJECT: 9579
DATE: 08-29-2016
SHEET 1 OF 1