

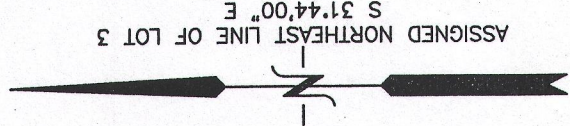


PLAT OF SURVEY
LOT 3 OF MERENESS SPRINGS SUBDIVISION
LOCATED IN PART OF THE SOUTHEAST 1/4 OF SECTION 22,
TOWN 2 NORTH, RANGE 16 EAST, WALWORTH COUNTY, WISCONSIN

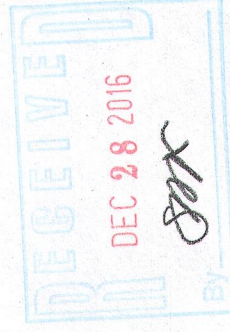

ASSIGNED NORTHEAST LINE OF LOT 3
S 31°44'00" E

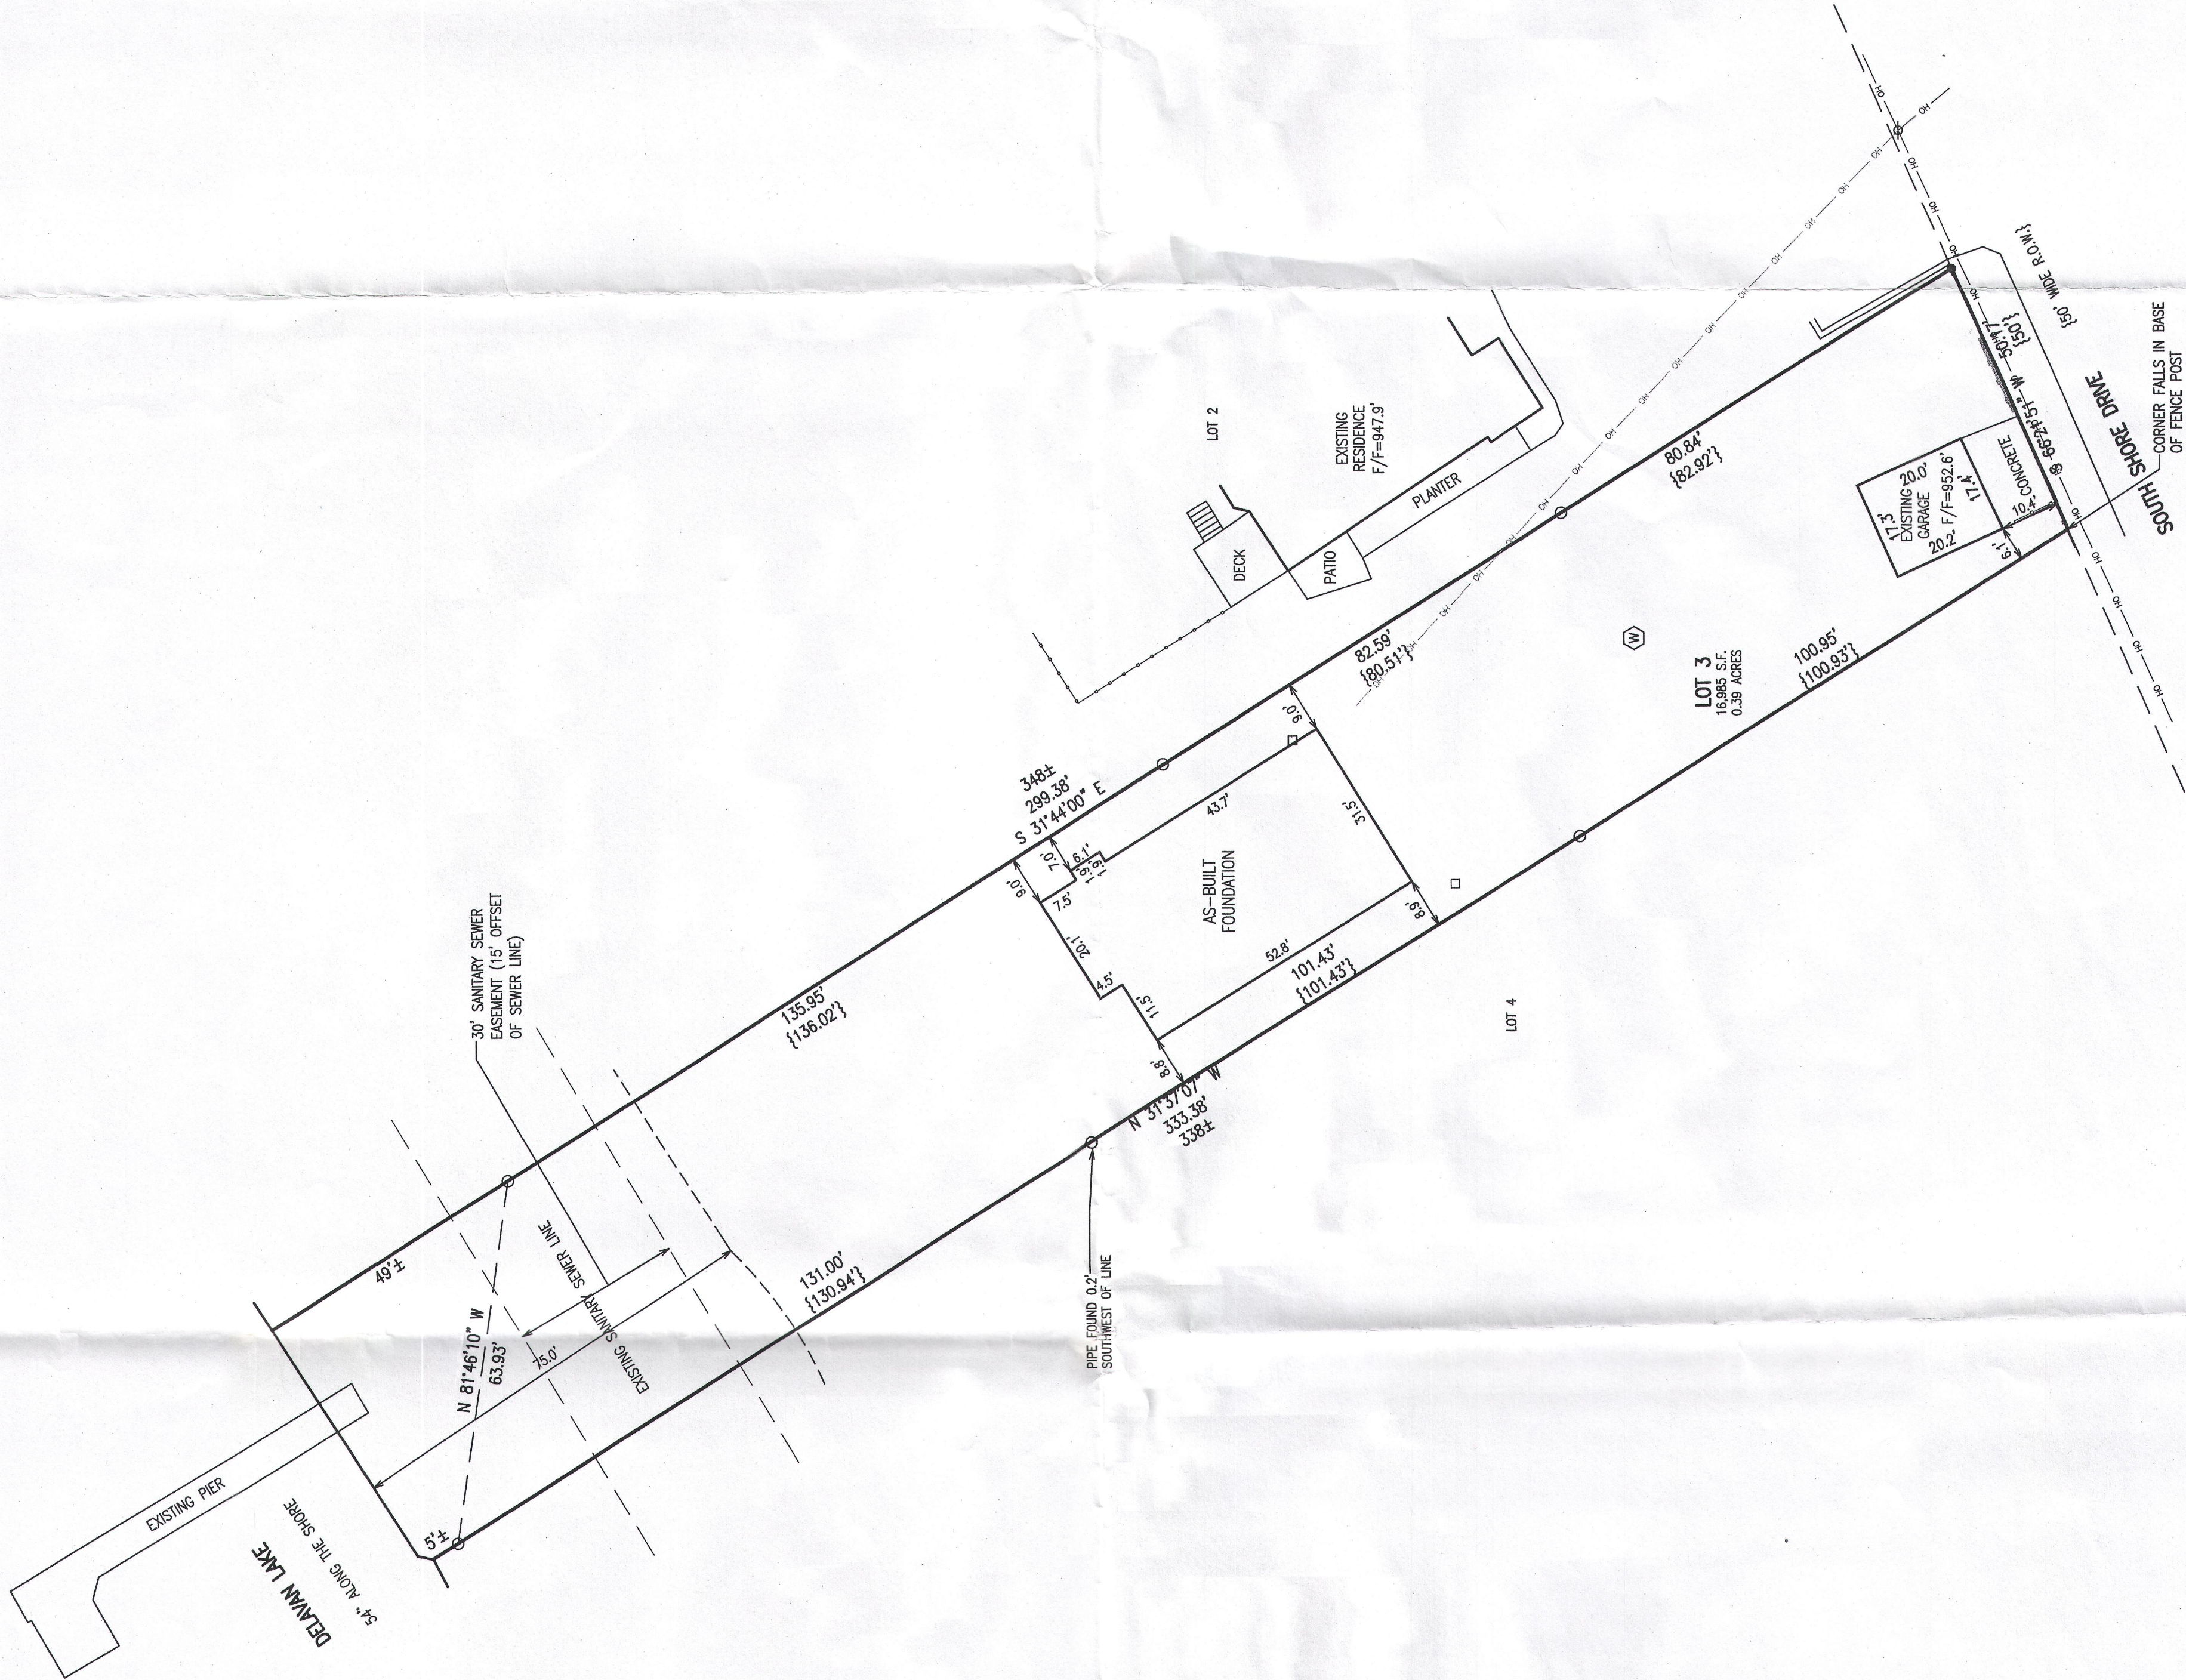

NOTE: COPIES OF THIS MAP TO WHICH THE FOLLOWING CERTIFICATE WILL APPLY SHOW THE SURVEYOR'S ORIGINAL SEAL AND SIGNATURE IN RED INK. COPIES BY ANY OTHER MEANS MAY HAVE ALTERATIONS WHICH DO NOT REPRESENT THE SURVEYOR'S WORK PRODUCT.

I HEREBY CERTIFY THAT THE ABOVE DESCRIBED PROPERTY HAS BEEN SURVEYED UNDER MY DIRECTION AND THAT THE ABOVE MAP IS A TRUE REPRESENTATION OF THE SURVEY AND SHOWS THE LOCATION OF THE PROPERTY AND THE LOCATION OF THE PROPERTY AND ALSO THOSE WHO PURCHASE, MORTGAGE, OR GUARANTEE THE TITLE THERETO WITHIN ONE YEAR FROM THE DATE HEREOF.

REMOVED 9/12/2016-KB
SITE, GRADING, DRAINAGE &
EROSION CONTROL PLAN

REMOVED 12/13/2016-CB
TO SHOW SIZE & LOCATION OF
AS-BUILT FOUNDATION

DATED: APRIL 27, 2016

PETER S. GORDON P.L.S. 2101

LEGEND

- = FOUND IRON PIPE STAKE, 1 3/8" O.D.
- = FOUND IRON FERRIS STAKE, 3/4" DIA.
- {XXX} = RECORDED AS WEST LINE RECORDS BY KENNETH B. MEHRING OF DECEMBER 26 2014
- RECORDED AS EAST LINE RECORDS BY PETER S. GORDON OF JANUARY 15 2002

FARRIS, HANSEN & ASSOCIATES, INC.
ENGINEERING - ARCHITECTURE - SURVEYING
7 RIDGWAY COURT
ELKHORN, WISCONSIN 53121
P.O. BOX 437
OFFICE: (262) 723-2098 FAX: (262) 723-5886

- WORK ORDERED BY -
JORDNT- FAHEY, LLC
168 ELKHORN ROAD
WILLIAMS BAY, WI 53191

CLARK RESIDENCE
1709 SOUTH SHORE DRIVE, DELAVAN, WISCONSIN

