


PREPARE FOR:  
 RYAN SIMONS  
 KEEFE REAL ESTATE  
 DELAVAN, WI.

# PLAT OF SURVEY


- OF -

LOTS 255 AND 256 LAKE DELAVAN HIGHLANDS, A SUBDIVISION LOCATED  
 IN THE SOUTH 1/2 OF THE SOUTHEAST 1/4 OF SECTION 31, TOWN 2 NORTH,  
 RANGE 16 EAST OF THE FOURTH PRINCIPAL MERIDIAN, TOWN OF DELAVAN,  
 COUNTY OF WALWORTH AND STATE OF WISCONSIN.

PATHFINDER SURVEYING INC.  
 (formerly)  
 J.K. SURVEYING INC.  
 P.O BOX 322  
 LAKE GENEVA, WI. 53147  
 WWW.PATHFINDERSURVEYING.NET  
 262-248-8303

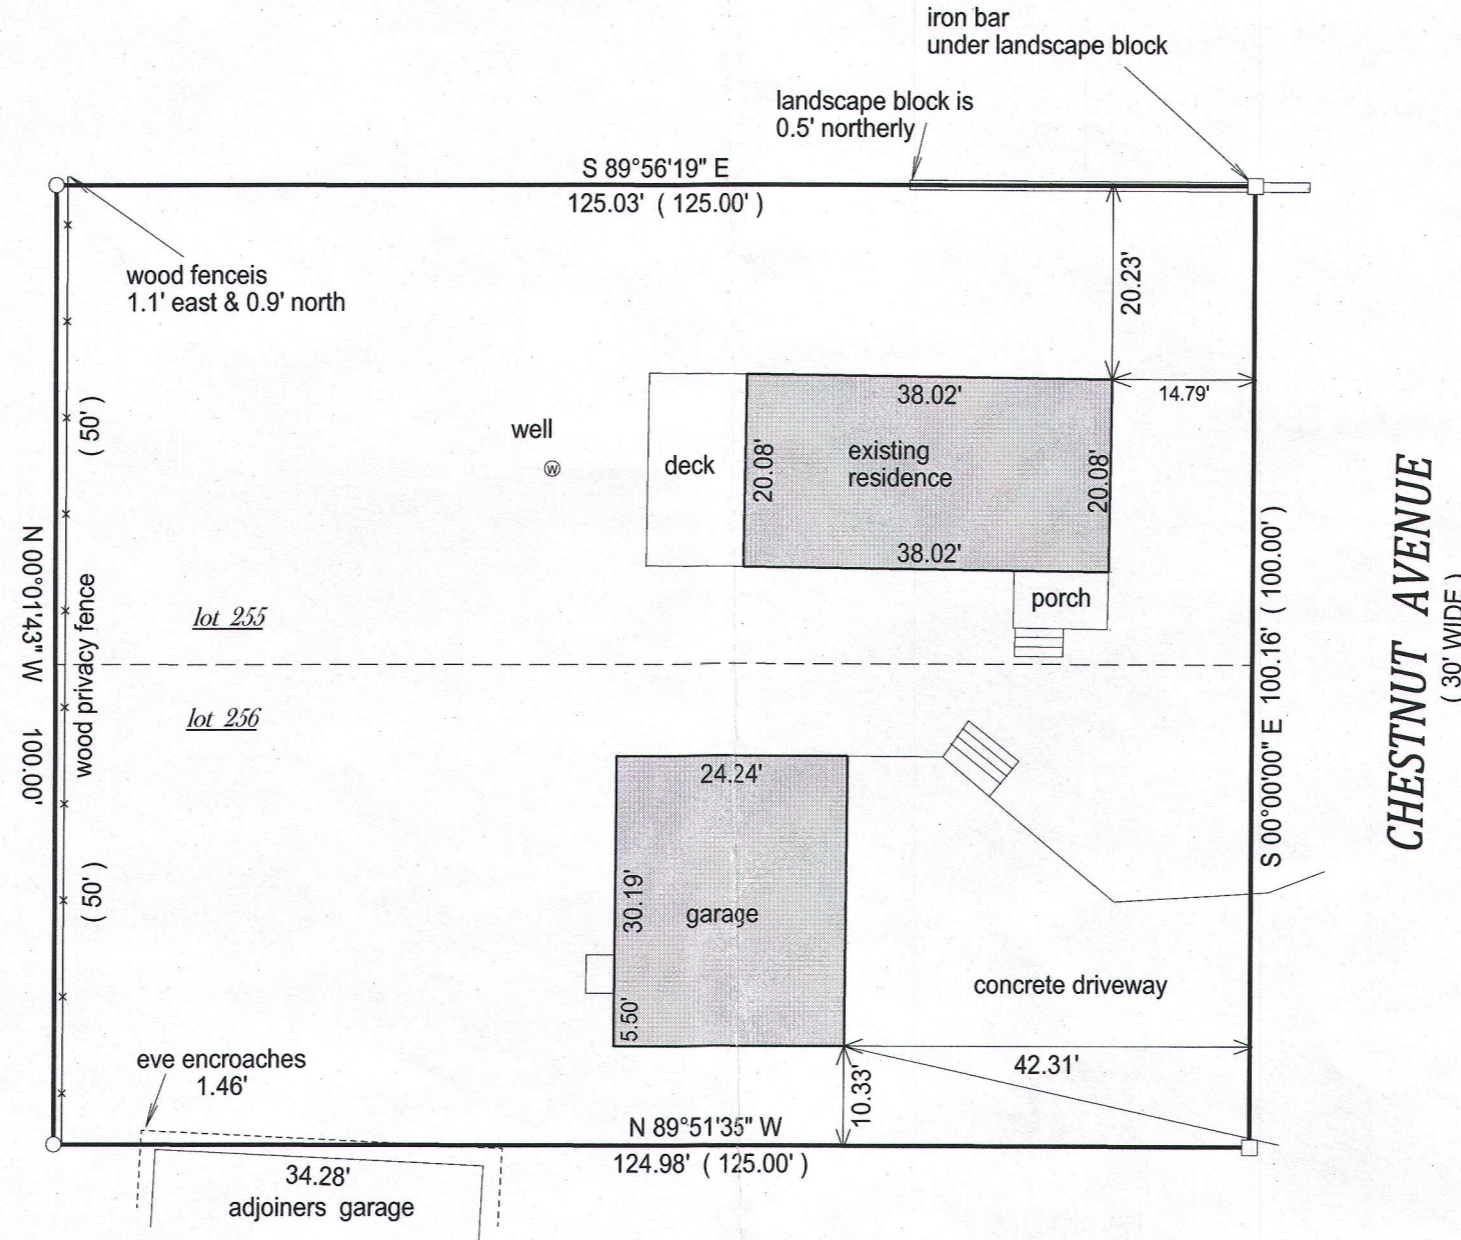


- ( ) = recorded as
- = found iron bar
- = found iron pipe
- = set iron pipe
- = set iron bar

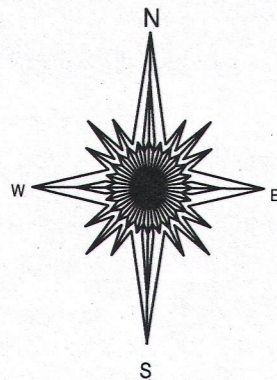

SCALE 1" = 20'

JOB # 16-296

TAX ID #  
 FLAD00193


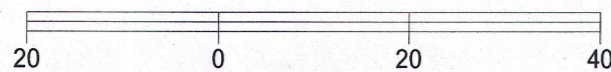


BASIS OF BEARING OF THIS PLAT: THE WEST LINE  
 OF CHESTNUT WAS ASSUMED TO BEAR NORTH / SOUTH.

"I hereby certify that I have surveyed the above described property and that the above map is a true representation of its exterior boundary and shows the size and location of all visible structures, apparent easements and encroachments if any."

This survey is made for the present owners of the property, and those who purchase, mortgage, or guarantee the title thereto, within one year from the date hereof.

DATED THIS 22ND DAY OF SEPTEMBER, 2016.

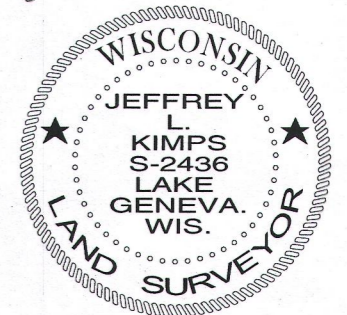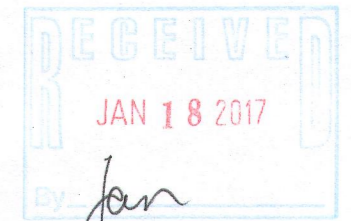

*Jeffrey L. Kimps*  
 JEFFREY L. KIMPS S-2436  
 Wisconsin Registered Land Surveyor  
 (original if signed in red)

FLAd-193

216-5351