WORK ORDERED BY –
DAN GRAINGE
489 COTTAGE HILL AVE
ELMHURST, IL. 60126

REVISIONS


NOTE: COPIES OF THIS MAP TO WHICH THE FOLLOWING CERTIFICATE WILL APPLY SHOW THE SURVEYOR'S ORIGINAL SEAL AND SIGNATURE IN RED INK. COPIES BY ANY OTHER MEANS MAY HAVE ALTERATIONS WHICH DO NOT REPRESENT THE SURVEYOR'S WORK PRODUCT.

I HEREBY CERTIFY THAT THE ABOVE DESCRIBED PROPERTY HAS BEEN SURVEYED UNDER MY DIRECTION AND THAT THE ABOVE MAP IS A TRUE REPRESENTATION THEREOF AND SHOWS THE SIZE AND LOCATION OF THE PROPERTY AND ITS EXTERIOR BOUNDARIES. THIS SURVEY IS MADE FOR THE USE OF THE PRESENT OWNERS OF THE PROPERTY, AND ALSO THOSE WHO PURCHASE, MORTGAGE, OR GUARANTEE THE TITLE THERETO WITHIN ONE YEAR FROM THE DATE HEREOF.

DATED: JUNE 7, 2007

REVISED 09-12-2007 TO SHOW SIZE & LOCATION OF AS BUILT FOUNDATION REVISED 12-9-2008 TO UPDATE SURVEY REVISED 3-22-2017 TO SHOW IMPERVIOUS SURFACE AREAS & ADDITIONS

PROJECT NO. 7123 06/07/2007 1 OF 1

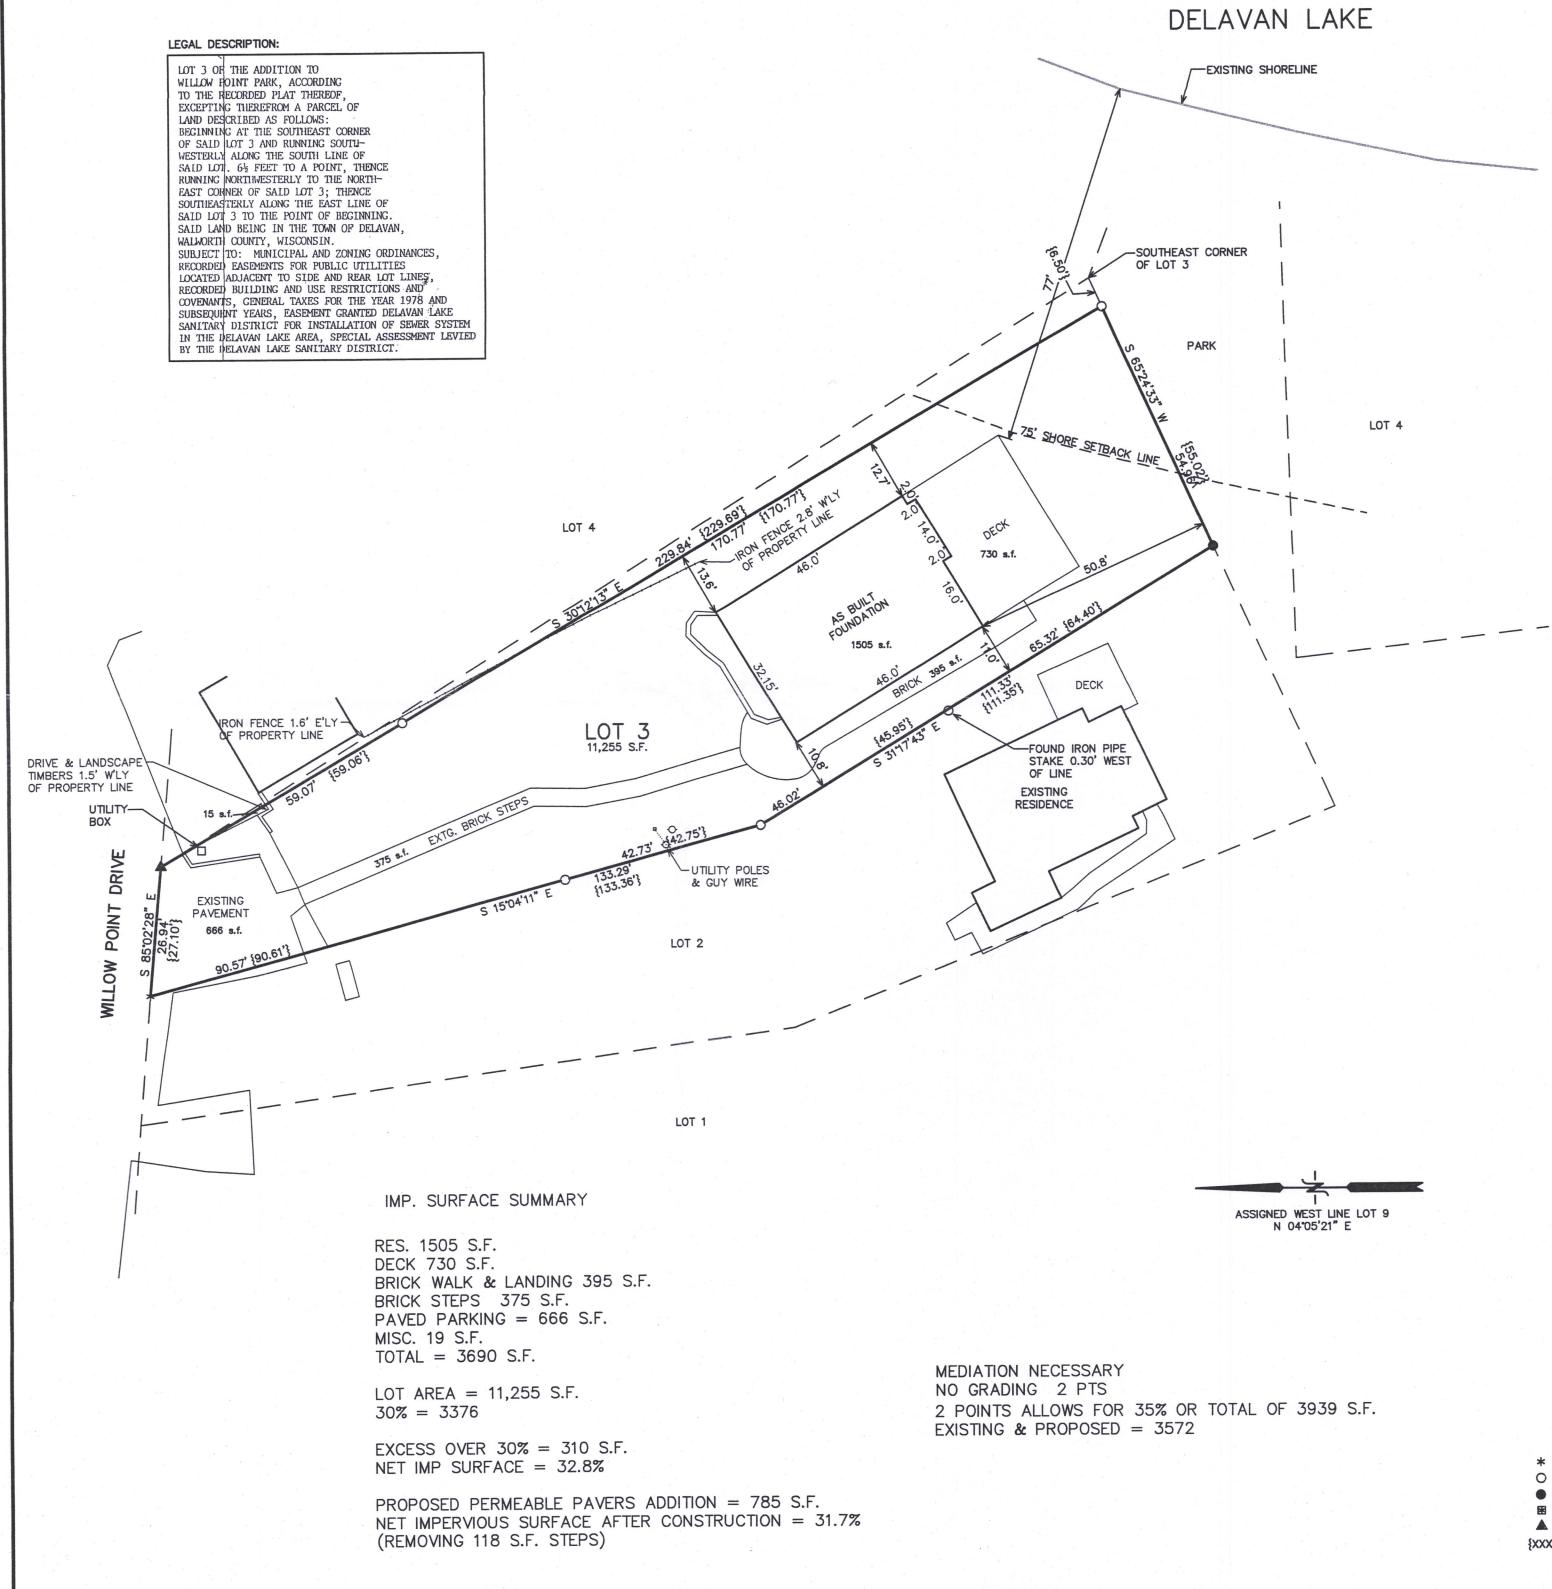

ELEV.=957.80 FLOOR ELEV.=958.3' EXISTING TOP OF WALL = 956.0' UTILITY BOX TO BE REMOVED EXISTING PINE TREE— TO BE REMOVED EXISTING PAVEMENT (TO REMAIN) NOTE: ANY DISTURBED AREAS ARE TO BE RESTORED AS SOON AS POSSIBLE FOLLOWING CONSTRUCTION. REFUSE AREA EXISTING GRAVEL SITE PLAN DETAIL SCALE: 1"=10'

LEGEND

\* = SET NAIL O = FOUND IRON PIPE STAKE

= FOUND IRON REBAR STAKE

■ SET LANDSCAPE SPIKE IN CONCRETE MONUMENT

= EXISTING GEAR SPIKE

 $\{XXX\} = RECORDED AS$ 

MAY **25** 2017

