




# Plat of Survey

of  
**Lot 76 of Lake Delavan Highlands,**  
 a subdivision located in the Southwest 1/4 of the Southeast 1/4 of Section 31,  
 Town 2 North, Range 16 East, Town of Delavan, Walworth County, Wisconsin.

Surveyed for: **Dave & Andrea Kelly**  
 4229 Central Boulevard  
 Delavan, Wisconsin. 53115

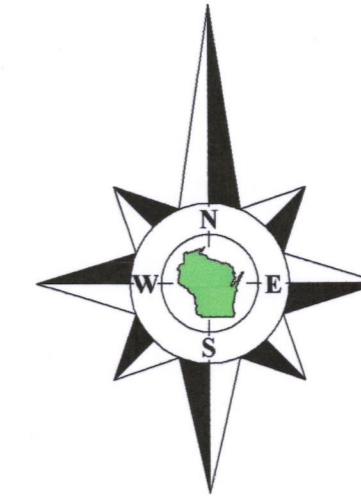

Bearings referenced to the West line of Central Boulevard,  
 recorded as N0°13'40"E on the plat of Lake Delavan Highlands.

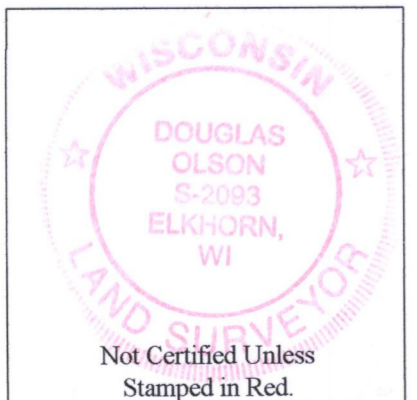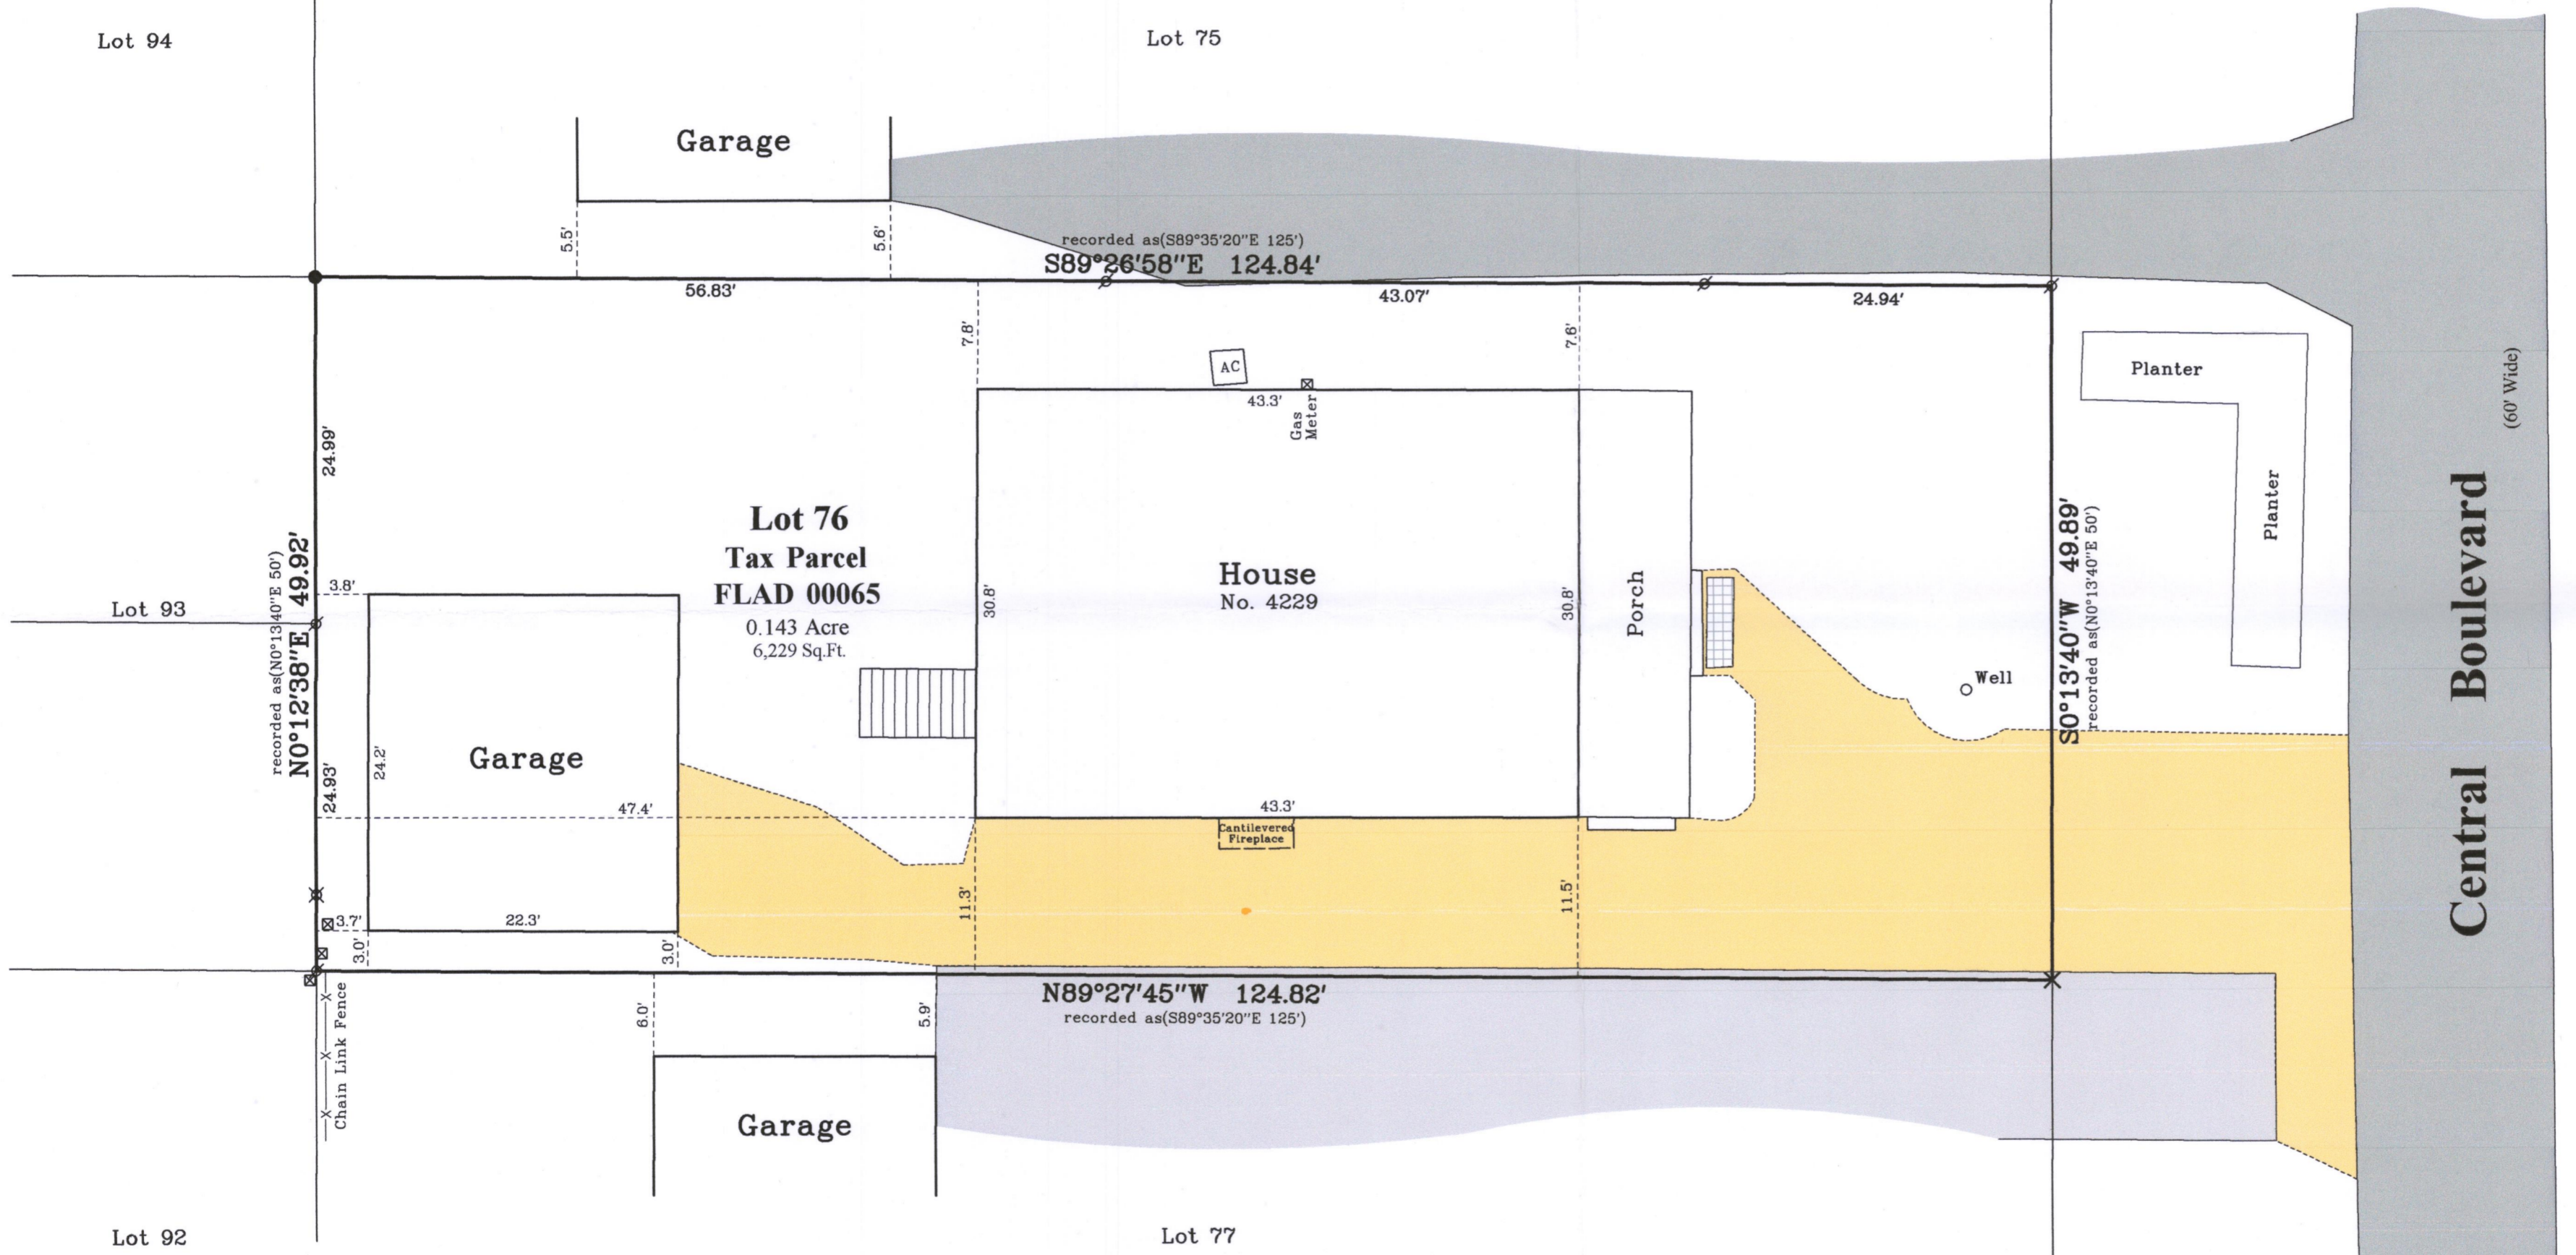


Copyright ©2017 by Olson Land Surveying, LLC.  
 All rights reserved. No part of this survey plat may be reproduced or transmitted in any form by any means - graphic, electronic, or mechanical, including photocopying, tracing, or information storage and retrieval systems - without permission in writing from Douglas G. Olson, Olson Land Surveying, LLC.


I hereby certify that I have surveyed the above described property in compliance with Chapter A-E 7 of the Wisconsin Administrative Code and that the map hereon is correct to the best of my knowledge and belief.

Douglas G. Olson  
 Wisconsin Professional Land Surveyor - 2093

- Notes:**
- 1) This Plat of Survey is not certified unless signed and sealed in red ink.
  - 2) This survey is subject to Wisconsin lien laws. This Plat of Survey is the notice of intent to file lien. Lien waiver required.
  - 3) The Survey Date shown on this Plat of Survey is the completion date of the field work.

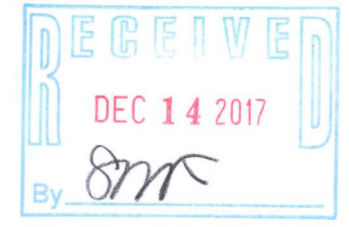

Survey Date: May 18, 2017.  
 Revisions: No. 1 - Proposed Garage  
 No. 2 - As-Built Garage

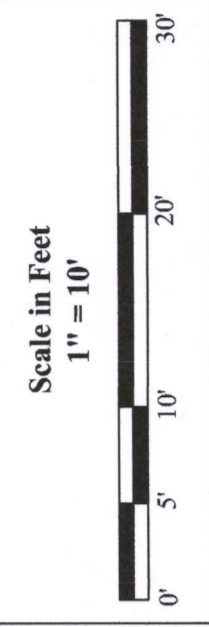

45 South Wisconsin Street | P.O. Box 322  
 Elkhorn, Wisconsin. 53121  
 Telephone: (262) 723-3434  
 Facsimile: (262) 723-8044  
 Email: doug@olsonsurveying.com  
 Website: www.olsonsurveying.com



Legend of Symbols & Abbreviations

N	North
S	South
E	East
W	West
in	Inches
ft	Feet
mi	Miles
sec	Seconds
min	Minutes
hr	Hours
°	Degrees
'	Minutes
''	Seconds
---	Found Iron Pipe
⊗	Found Iron Rod
⊙	Set Cut Cross
⊕	Recorded Information
⊖	Utility Pedestal
⊗	Asphalt Surface
⊙	Concrete Surface
⊖	Gravel Surface
⊕	Brick Pavers

Sheet 1 of 1 Sheets  
 Drawing Name:  
 Job Reference Number  
**2017.031**

2017.031

FLAD-105

2116-5449