
FARRIS, HANSEN & ASSOCIATES, INC.

ENGINEERING – ARCHITECTURE – SURVEYING
7 RIDGWAY COURT – P.O. BOX 437 – ELKHORN, WISCONSIN 53121
PHONE: (262) 723–2098 FAX: (262) 723–5886

PLAT OF SURVEY

LOTS 13 & 14 OF BLOCK D OF DELAVAN LAKE ASSEMBLY GROUNDS LOCATED IN THE NW 1/4 OF THE SE 1/4 OF SECTION 21, TOWN 2 NORTH, RANGE 16 EAST, WALWORTH COUNTY, WISCONSIN

WORK ORDERED BY –
 AMY DIGREGORIO
 2385 DELTA LANE
 ELK GROVE, IL 60007

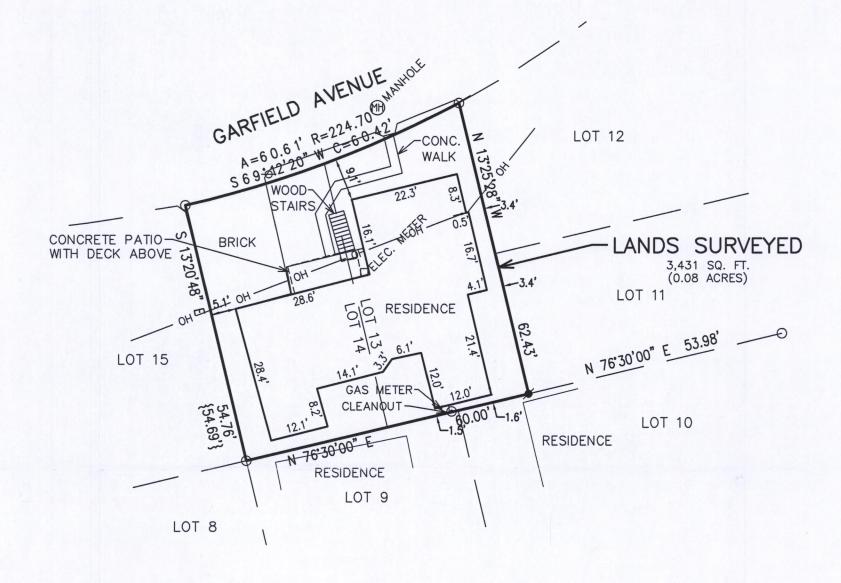

ASSIGNED THE SOUTHERLY BOUNDAR OF LANDS SURVEYED N 76'30'00" E

LEGEND

O = FOUND IRON PIPE STAKE

■ SET IRON REBAR STAKE

 \rightarrow = UTILITY POLE LOCATED

— OH — = OVERHEAD WIRES LOCATED


 $\{XXX\}$ = RECORDED AS

NOTE: COPIES OF THIS MAP TO WHICH THE FOLLOWING CERTIFICATE WILL APPLY SHOW THE SURVEYOR'S ORIGINAL SEAL AND SIGNATURE IN RED INK. COPIES BY ANY OTHER MEANS MAY HAVE ALTERATIONS WHICH DO NOT REPRESENT THE SURVEYOR'S WORK PRODUCT.

I HEREBY CERTIFY THAT THE ABOVE DESCRIBED PROPERTY HAS BEEN SURVEYED UNDER MY DIRECTION AND THAT THE ABOVE MAP IS A TRUE REPRESENTATION THEREOF AND SHOWS THE SIZE AND LOCATION OF THE PROPERTY AND ITS EXTERIOR BOUNDARIES. THIS SURVEY IS MADE FOR THE USE OF THE PRESENT OWNERS OF THE PROPERTY, AND ALSO THOSE WHO PURCHASE, MORTGAGE, OR GUARANTEE THE TITLE THERETO WITHIN ONE YEAR FROM THE DATE HEREOF.

DATED: 12/4/2017

BRIAN M. CARLSON P.L.S. 2039

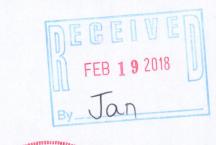



PROJECT: 9881 DATE: 12/04/2017 SHEET 1 OF 1

\PROJECTS\9881\ACAD\9881.DWG