AMBIT LAND SURVEYING

8120-312th Avenue Wheatland, WI. 53105-8934 Licensed Professionals in both Illinois & Wisconsin

PLAT OF SURVEY

PHONE:

262-537-4874

FAX:


262-537-4221

EMAIL:

ambit@tds.net

Lot 9 and the East Half of Lot 8 of BRATLEY'S SUBDIVISION of part of Section 28, Town 2 North, Range 16 East of the 4th Pricipal Meridian, Walworth County. Wisconsin.

PARCEL IDENTIFICATION NO: FBRS 00006A

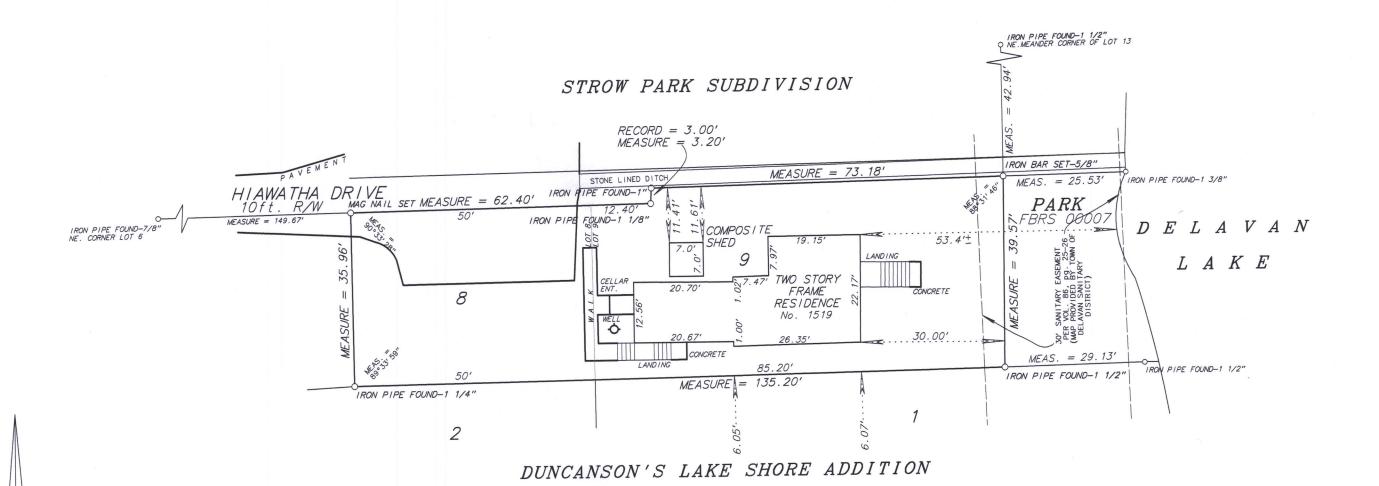

NOTE:

NO DOCUMENT WAS PROVIDED OR LOCATED FOR THE "PARK" AREA. THE ONLY EVIDENCE FOR THE "PARK" IS FROM THE COUNTY TAX MAP AT THIS TIME.



Fieldwork completed on and date of certification:	ember	5,	2017
Fieldwork completed on and date of certain in the completed on and date of certain in the complete of certain in the complete of certain in the complete of certain in the			
I hereby certify that I have surve ed in above described plat is a true representation true of a shows the size property, its exterior boundaries, the location and dimens structures thereon, boundary longs, apparent easements are encroachments, if any	and losions of	cati al ys a	on of the visible of visible of visible of visible of the visible
This survey is take for the exclusive use of the present and also those who processe, mortgage or guarantee the tityEAR from the large vereof.	owners o	f th to w	e propert ithin ON
Dated as B sett, Wisconsin this day of		2	017.
Mark A. Bolender Wisconsin Professional Land Surveyor — 1784			

JOB NO.: 17142 FBRS-6A

SCALE: 1 inch = 20 feet

ORDERED BY: D. Morrissey