

Tax Parcel
FD 2900002

recorded as (N89°29'37"E 418.31')
N89°30'28"E 418.31'

Quiet Lane

(66' Wide)

Plat of Survey

of


Lots 1 & 2 of Certified Survey Map No. 3923,

recorded in Vol. 24 of Certified Survey Maps of Walworth County on Page 69 and located in the Southeast 1/4 of the Northeast 1/4 of Section 29, Town 2 North, Range 16 East, Town of Delavan, Walworth County, Wisconsin.

Surveyed for: **Martha Genzlinger**

2629 North Shore Drive
Delavan, Wisconsin. 53115

Lot 1
C.S.M. 1442

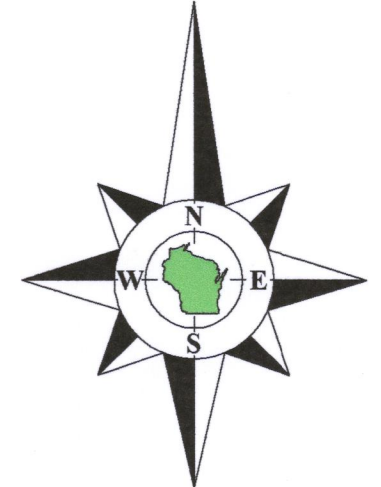


Bearings referenced to the South line of the Northeast 1/4 of Section 29-2-16, recorded as N89°20'10"E in the Wisconsin State Plane Coordinate System, South Zone, (NAD-27).

Coordinates are referenced to the Wisconsin State Plane Coordinate System, South Zone, (NAD-27).

Lot 2
Tax Parcel
FA392300002
5.338 Acres
232,507 Sq.Ft.

Lot 1
Tax Parcel
FA392300001
0.689 Acre
30,016 Sq.Ft.

Lot 4
C.S.M. 1442

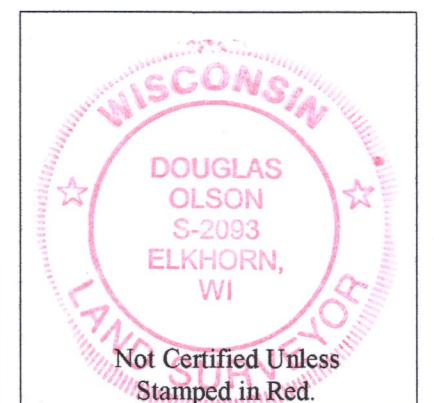

Notes:

- 1) This Plat of Survey is not certified unless signed and sealed in red ink. This survey is subject to Wisconsin lien laws. This Plat of Survey is the notice of intent to file lien. Lien waiver required.
- 2) The Survey Date shown on this Plat of Survey is the completion date of the field work.

North Shore Drive

South line of the Northeast 1/4 of Section 29-2-16.

N89°20'10"E 2672.56'
(S89°20'10"W 2672.50') State Plane

S89°20'10"W 417.86'
recorded as (S89°20'10"W 417.82')

recorded as (West 668.00')
recorded as (S89°20'10"W 668.04')
S89°20'10"W 668.00'

East 1/4 Corner
Section 29-2-16
N. 223,205.99
E. 2,371,697.42

Copyright © 2018 by Olson Land Surveying, LLC.

All rights reserved. No part of this survey plat may be reproduced or transmitted in any form by any means - graphic, electronic, or mechanical, including photocopying, tracing, or information storage and retrieval systems - without permission in writing from Douglas G. Olson, Olson Land Surveying, LLC.

I hereby certify that I have surveyed the above described property in compliance with Chapter A-E 7 of the Wisconsin Administrative Code and that the map hereon is correct to the best of my professional knowledge and belief and shows the size and location of the property, its exterior boundaries, the location and dimensions of all visible structures thereon, boundary fences, apparent easements and roadways and visible encroachments, if any.

This survey is made for the exclusive use of the present owners of the property, and also those who purchase, mortgage or guarantee title thereto, within one year from the date hereof.

Douglas G. Olson
Wisconsin Professional Land Surveyor - 2093

Sheet 1 of 1 Sheets

Drawing Name:

Job Reference Number
2018.090

Legend of Symbols & Abbreviations


Found County Section Corner
Found Iron Pipe
Found Iron Rod
Recorded Information
Utility Pole
Utility Box or Pedestal
Septic Cleanout
Asphalt Surface
Concrete Surface
Gravel Surface

N North
S South
E East
W West
In Bearings
Degrees
Minutes
Seconds
In Distances
Feet
Inches



45 South Wisconsin Street | P.O. Box 322
Elkhorn, Wisconsin. 53121
Telephone: (262) 723-3434
Facsimile: (262) 723-8044
Email: doug@olsonsurveying.com
Website: www.olsonsurveying.com

Scale in Feet
1" = 40'

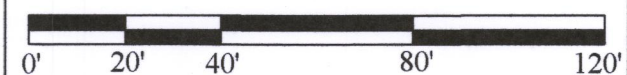

Survey Date: July 17, 2018.

Revisions:

2018.090

FA3923-1

FA3923-2

216-5520