


Plat of Survey

of  
Lot 26 of Ravenswood,  
a subdivision located in the Northwest 1/4 of the Northeast 1/4  
of Section 31, Town 2 North, Range 16 East, Town of Delavan,  
Walworth County, Wisconsin.

Surveyed for: **Walter Pacult**  
3911 Country Lane Drive  
Delavan, Wisconsin. 53115



Bearings referenced to the West line of Country Lane  
Drive, recorded as N0°50'W on the plat of Ravenswood.

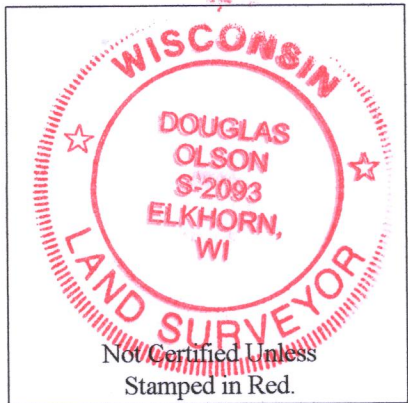


- Notes:
- 1) This Plat of Survey is not certified unless signed and sealed in red ink.
  - 2) This survey is subject to Wisconsin lien laws. This Plat of Survey is the notice of intent to file lien. Lien waiver required.
  - 3) The Survey Date shown on this Plat of Survey is the completion date of the field work.

Copyright ©2019 by Olson Land Surveying, LLC.  
All rights reserved. No part of this survey plat may be reproduced or transmitted in any form by any means - graphic, electronic, or mechanical, including photocopying, tracing, or information storage and retrieval systems - without permission in writing from Douglas G. Olson, Olson Land Surveying, LLC.

I hereby certify that I have surveyed the above described property in compliance with Chapter A-E 7 of the Wisconsin Administrative Code and that the map hereon is correct to the best of my professional knowledge and belief and shows the size and location of the property, its exterior boundaries, the location and dimensions of all visible structures thereon, boundary fences, apparent easements and roadways and visible encroachments, if any.  
This survey is made for the exclusive use of the present owners of the property, and also those who purchase, mortgage or guarantee title thereto, within one year from the date hereof.

Douglas G. Olson  
Wisconsin Professional Land Surveyor - 2093

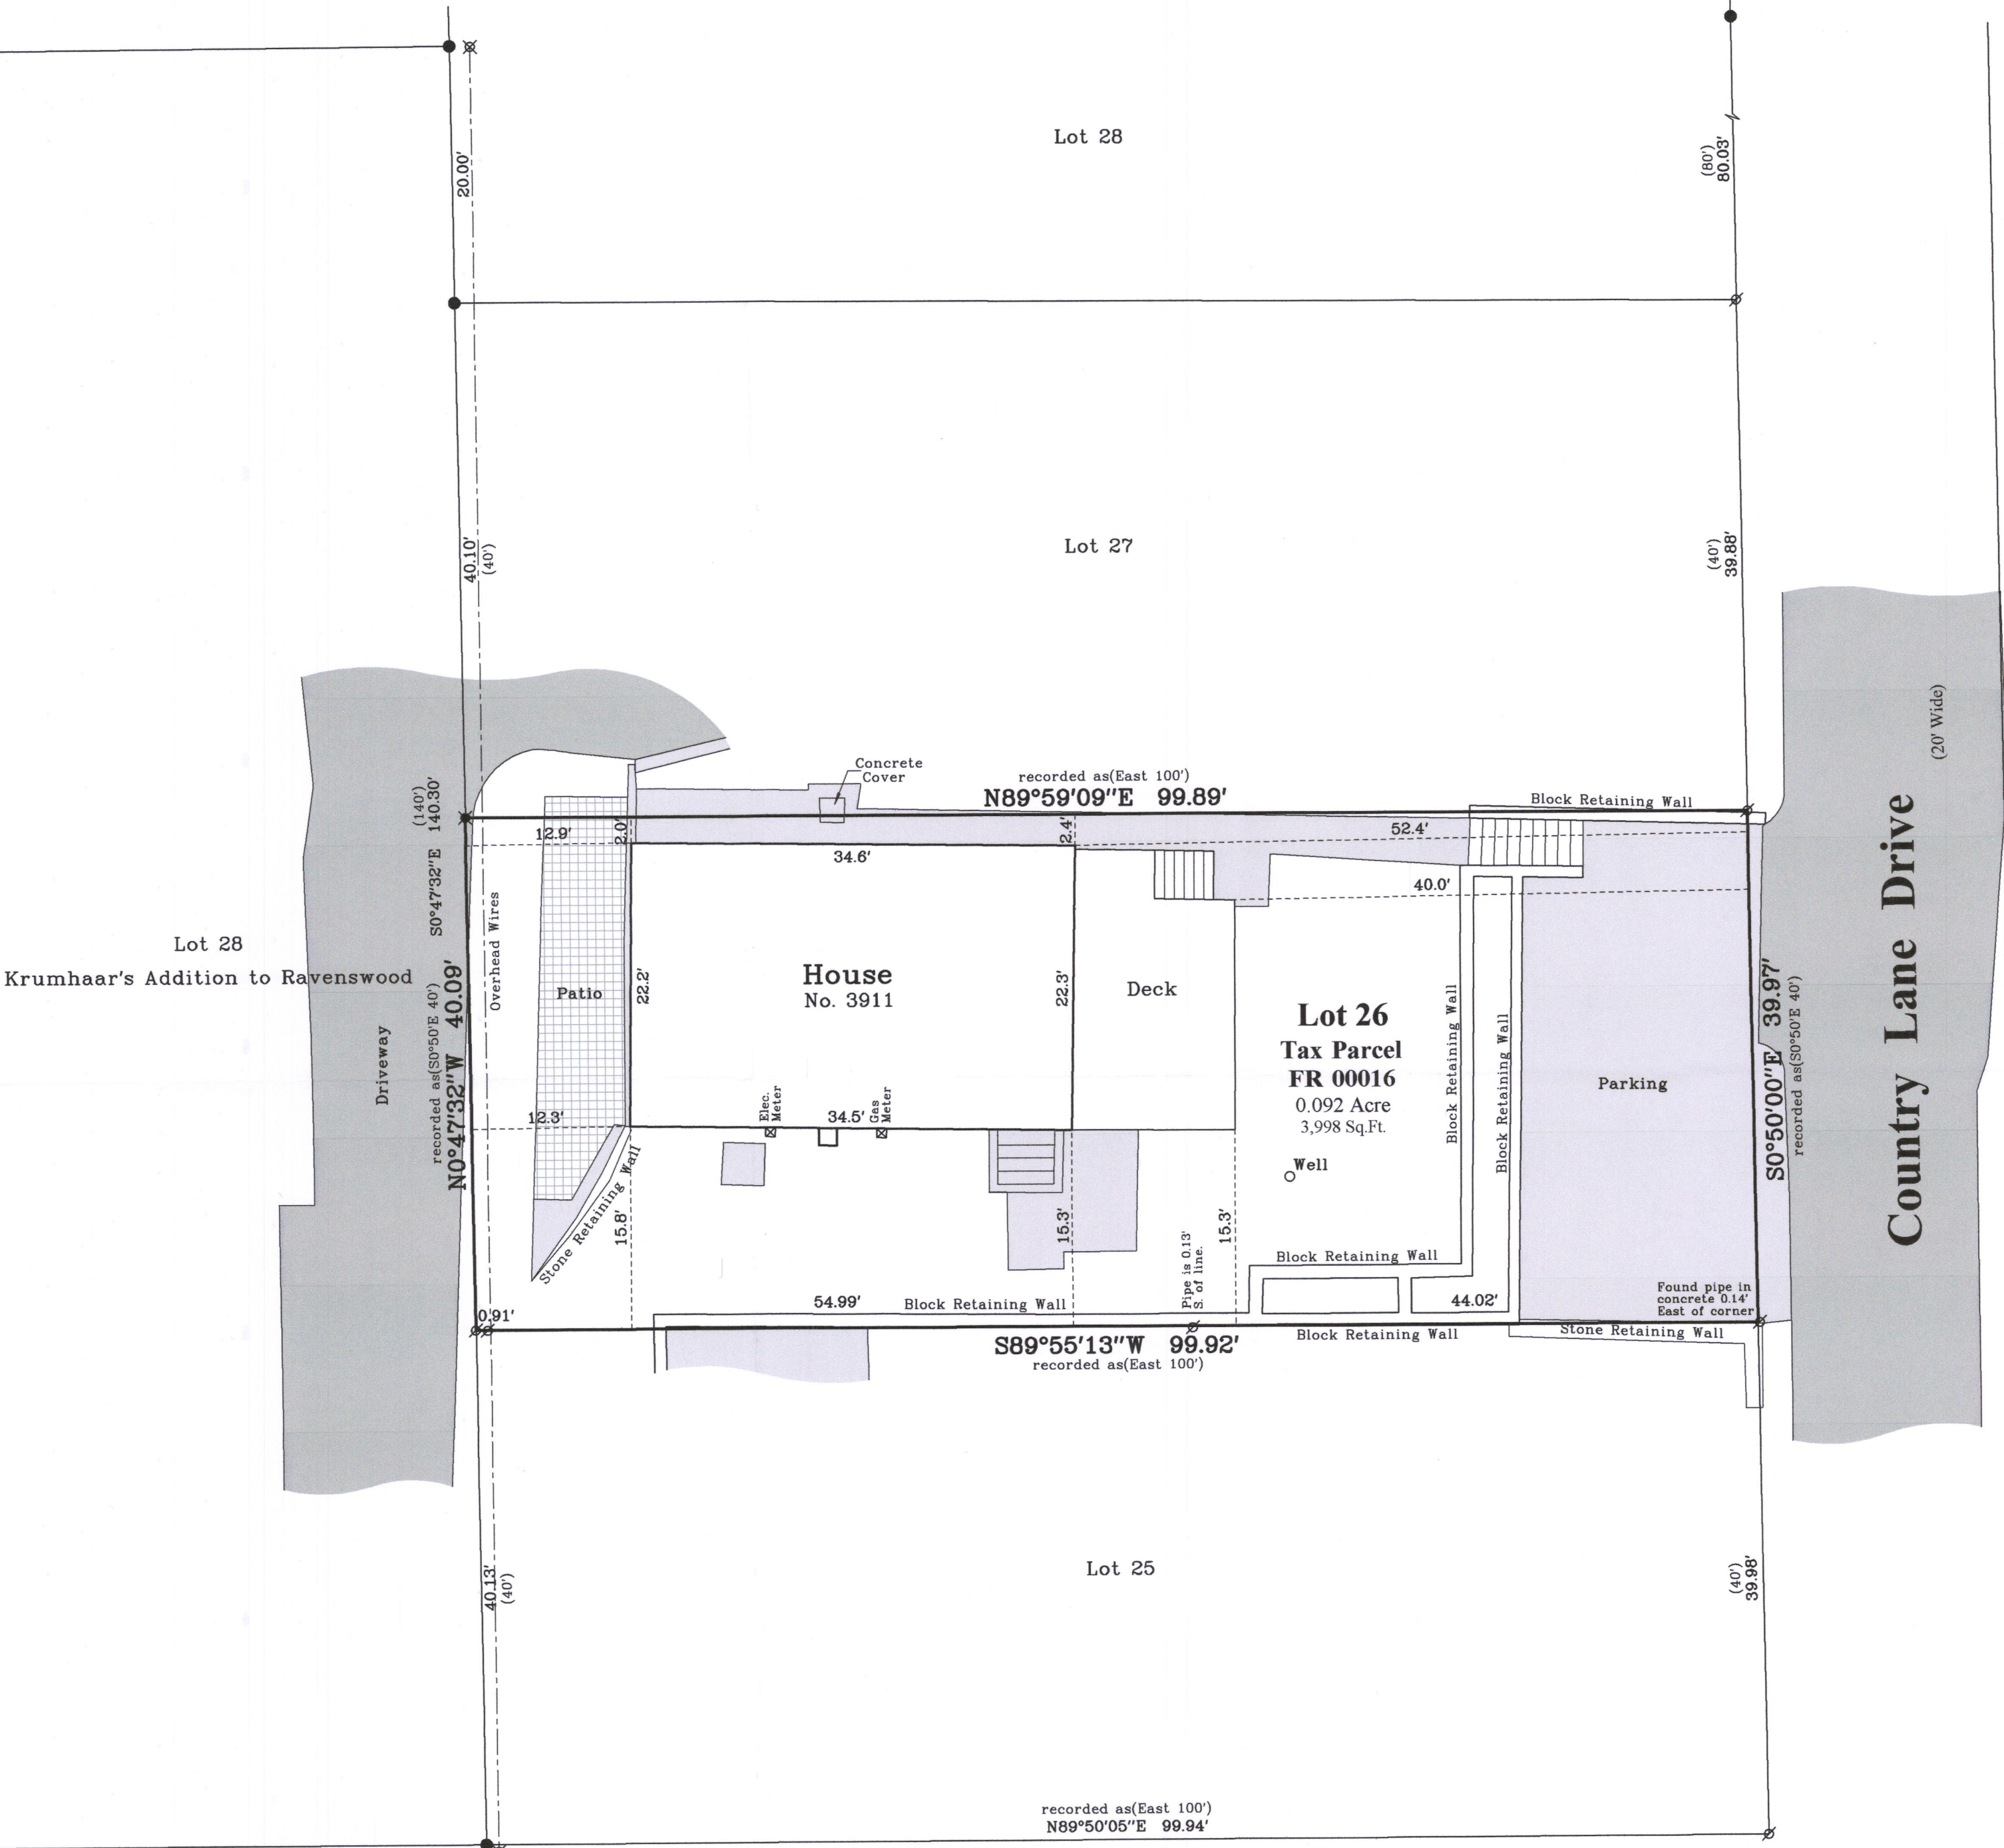

Maple Drive  
(20' Wide)



FR-16 216-5578

Survey Date: April 4, 2019.  
Revisions:

Scale in Feet  
1" = 10'

45 South Wisconsin Street | P.O. Box 322  
Elkhorn, Wisconsin, 53121  
Telephone: (262) 723-3434  
Facsimile: (262) 723-8044  
Email: doug@olsonsurveying.com  
Website: www.olsonsurveying.com

**OLSON**  
LAND SURVEYING, LLC  
Rural | Residential | Commercial

North  
South  
East  
West  
In  
Bearings  
in  
Minutes  
Seconds  
Tenths  
of  
Seconds  
in  
Feet  
Inches

Legend of Symbols & Abbreviations  
Found Iron Pipe  
Found Iron Rod  
Found Spindle  
Recorded Information  
Utility Pole  
Concrete Foundation  
Asphalt Surface  
Concrete Surface  
Brick Pavers

Sheet 1 of 1 Sheets  
Drawing Name:  
Job Reference Number  
2018.157

2018.157