
PLAT OF SURVEY

OF LOT 9, BLOCK 6 OF DELMAR SUBDIVISION LOCATED IN THE TOWN OF DELAVAN, WALWORTH COUNTY, WISCONSIN

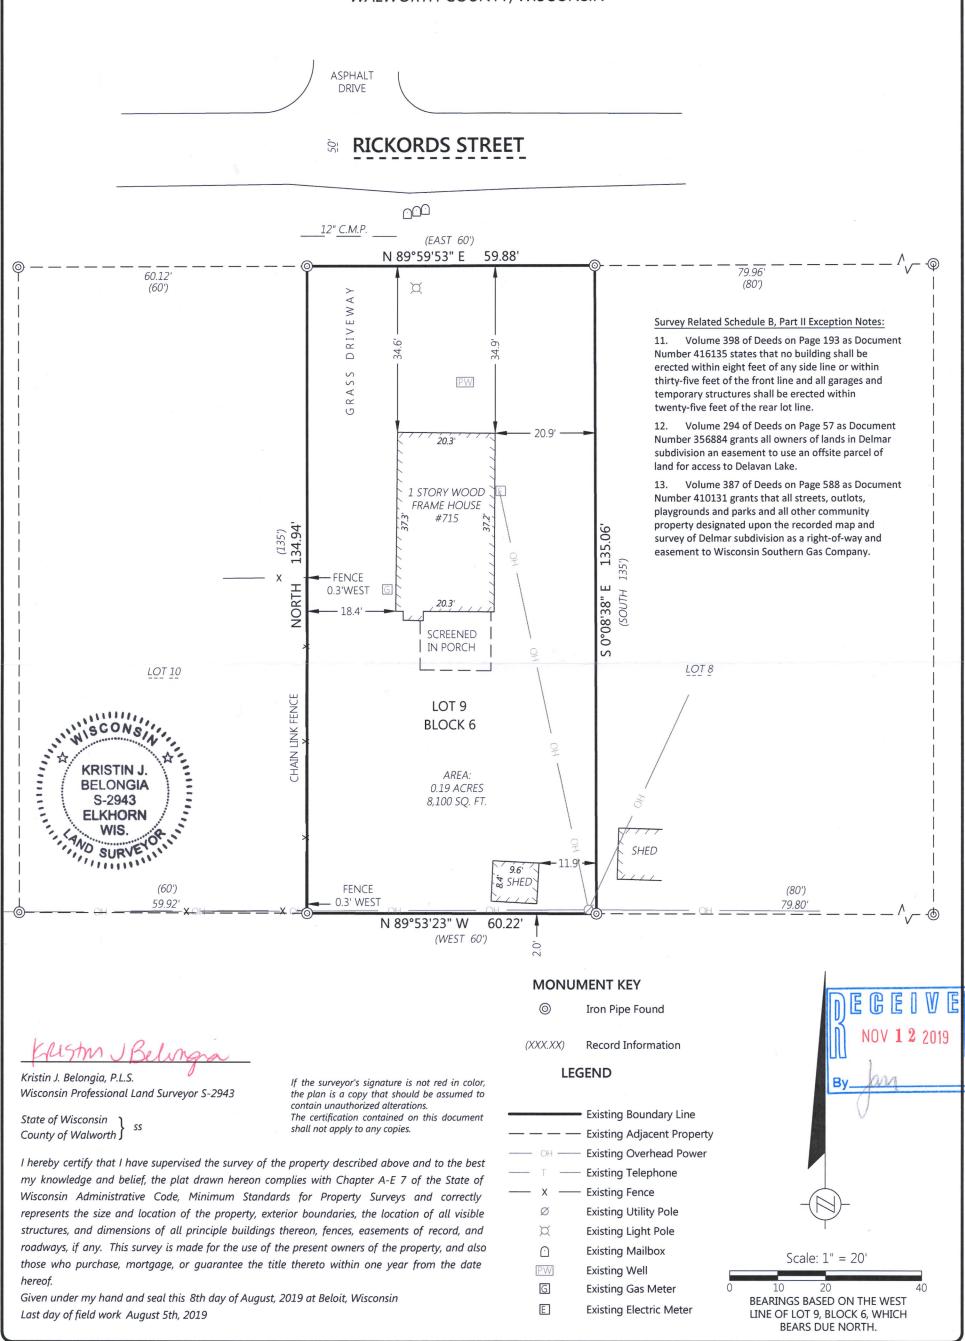

ORDER NO: 33370

BOOK: 585/17-18 FIELD CREW: DJE DRAWN BY: DJE DATE: August 7, 2019 FOR THE EXCLUSIVE USE OF: DIANE PIERRARD SHOREWEST REALTORS 623 W. MAIN ST. LAKE GENEVA, WI 53147

PLAT OF SURVEY



2857 Bartells Drive Beloit, Wisconsin 53511 608.365.4464 www.rhbatterman.com

