





LAKELAND SURVEYORS, LLC  
236B STH 50  
DELAVAN, WI 53115  
262-475-9567

# PLAT OF SURVEY

OF

THE EASTERLY 30 FEET OF LOT 29, LOT 30, AND THE WESTERLY 30 FEET OF LOT 31,  
BLOCK 15, IN DELAVAN LAKE VIEW CREST, A SUBDIVISION LOCATED IN SECTION 31,  
TOWN 2 NORTH, RANGE 16 EAST, WALWORTH COUNTY, WISCONSIN.

BEARINGS REFERENCED FROM PREVIOUS SURVEY OF RECORD

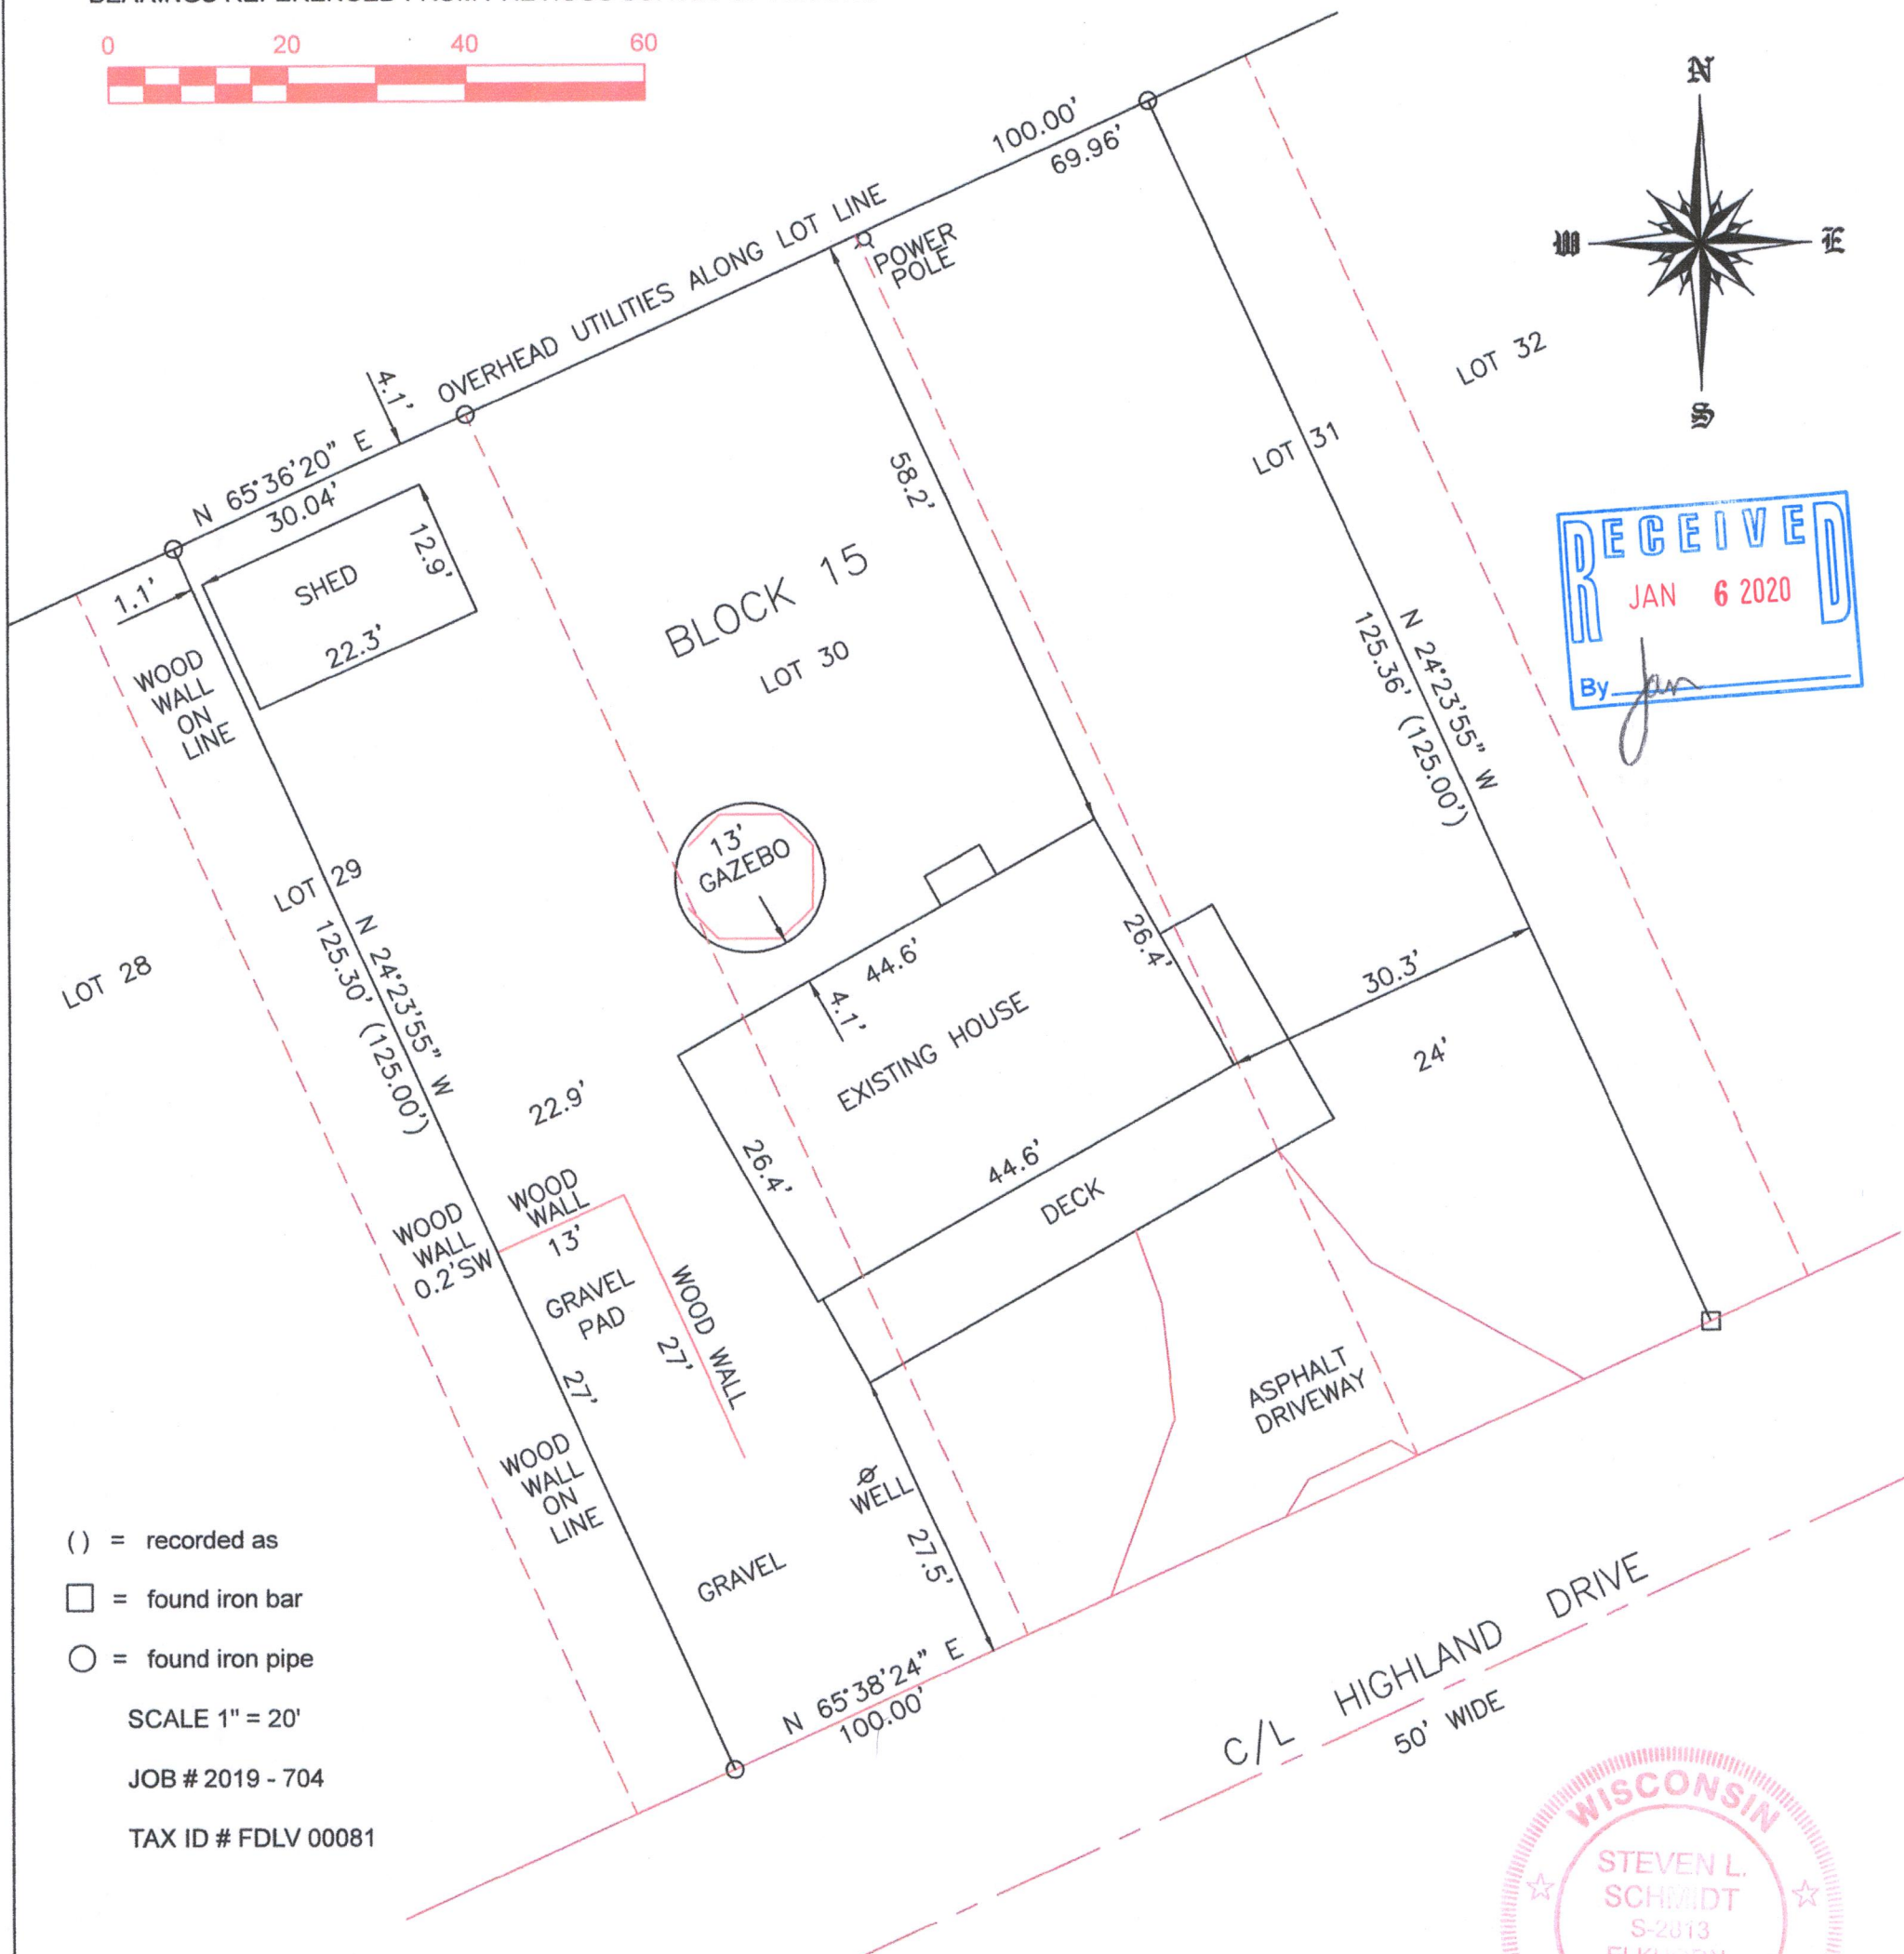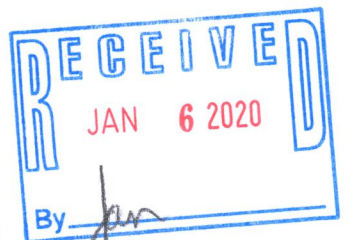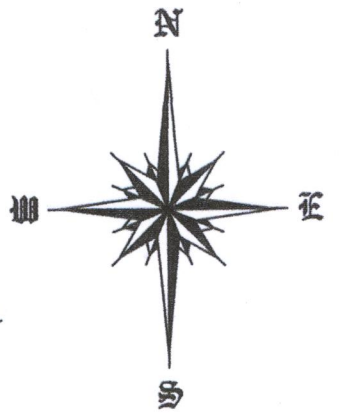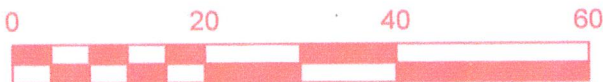

- ( ) = recorded as
- = found iron bar
- = found iron pipe

SCALE 1" = 20'

JOB # 2019 - 704


TAX ID # FDLV 00081

I hereby certify that I have surveyed the above described property and the above map is a true representation thereof and shows the size and location of the property, its exterior boundaries, the location and dimensions of all structures thereon, fences, apparent easements and roadways and visible encroachments if any.

This survey is made for the present owners of the property, and those who purchase, mortgage, or guarantee the title thereto, within one year from this date hereof.

DATED THIS 2ND DAY OF AUGUST 2019

FdLV-81 216-5635

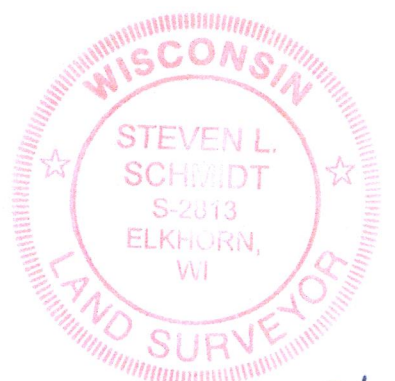

*Steven L. Schmidt*  
STEVEN L SCHMIDT S - 2813  
Wisconsin Professional Land Surveyor  
(original if signed in red)