

PLAT OF SURVEY
LOTS 1, 2 & 4 OF BLOCK 2 OF OAKHILL SUBDIVISION

LOCATED IN PART OF THE NE 1/4 OF THE SW 1/4
OF SECTION 31, TOWN 2 NORTH, RANGE 16 EAST,
TOWN OF DELAVAN, WALWORTH COUNTY, WISCONSIN



PLAT OF SURVEY
4111 WOOD DRIVE
DELAVAN, WI 53115

WORK ORDERED BY -
KEN MEUDT
4111 WOOD DRIVE
DELAVAN, WI 53115

FARRIS, HANSEN & ASSOCIATES, INC.
ENGINEERING - ARCHITECTURE - SURVEYING
7 RIDGWAY COURT P.O. BOX 437
ELKHORN, WISCONSIN 53121
OFFICE: (262) 723-2098 FAX: (262) 723-5886

REVISIONS
04/01/2020 - LB
SURVEY

PROJECT NO.
10236

DATE
04/01/2020

SHEET NO.
1 OF 1

LEGEND


- O = FOUND IRON PIPE STAKE
- = FOUND CONCRETE MONUMENT
- ⊕ = SANITARY SEWER MANHOLE
- ⊙ = WELL
- [XXX] = RECORDED AS
- [XXX] = AS RECORDED BY DAVID F. ABELL SURVEY DATED 01/26/1987
- [XXX] = SUBDIVISION PLAT

NOTE: COPIES OF THIS MAP TO WHICH THE FOLLOWING CERTIFICATE WILL APPLY SHOW THE SURVEYOR'S ORIGINAL SEAL AND SIGNATURE IN RED INK. COPIES BY ANY OTHER MEANS MAY HAVE ALTERATIONS WHICH DO NOT REPRESENT THE SURVEYOR'S WORK PRODUCT.

I HEREBY CERTIFY THAT THE ABOVE DESCRIBED PROPERTY HAS BEEN SURVEYED UNDER MY DIRECTION AND THAT THE ABOVE MAP IS A TRUE REPRESENTATION THEREOF AND SHOWS THE SIZE AND LOCATION OF THE PROPERTY AND ITS EXTERIOR BOUNDARIES. THIS SURVEY IS MADE FOR THE USE OF THE PRESENT OWNERS OF THE PROPERTY, AND ALSO THOSE WHO PURCHASE, MORTGAGE, OR GUARANTEE THE TITLE THERETO WITHIN ONE YEAR FROM THE DATE HEREOF.

DATED: 04/01/2020

BMC
BRIAN M. CARLSON P.L.S. 2039

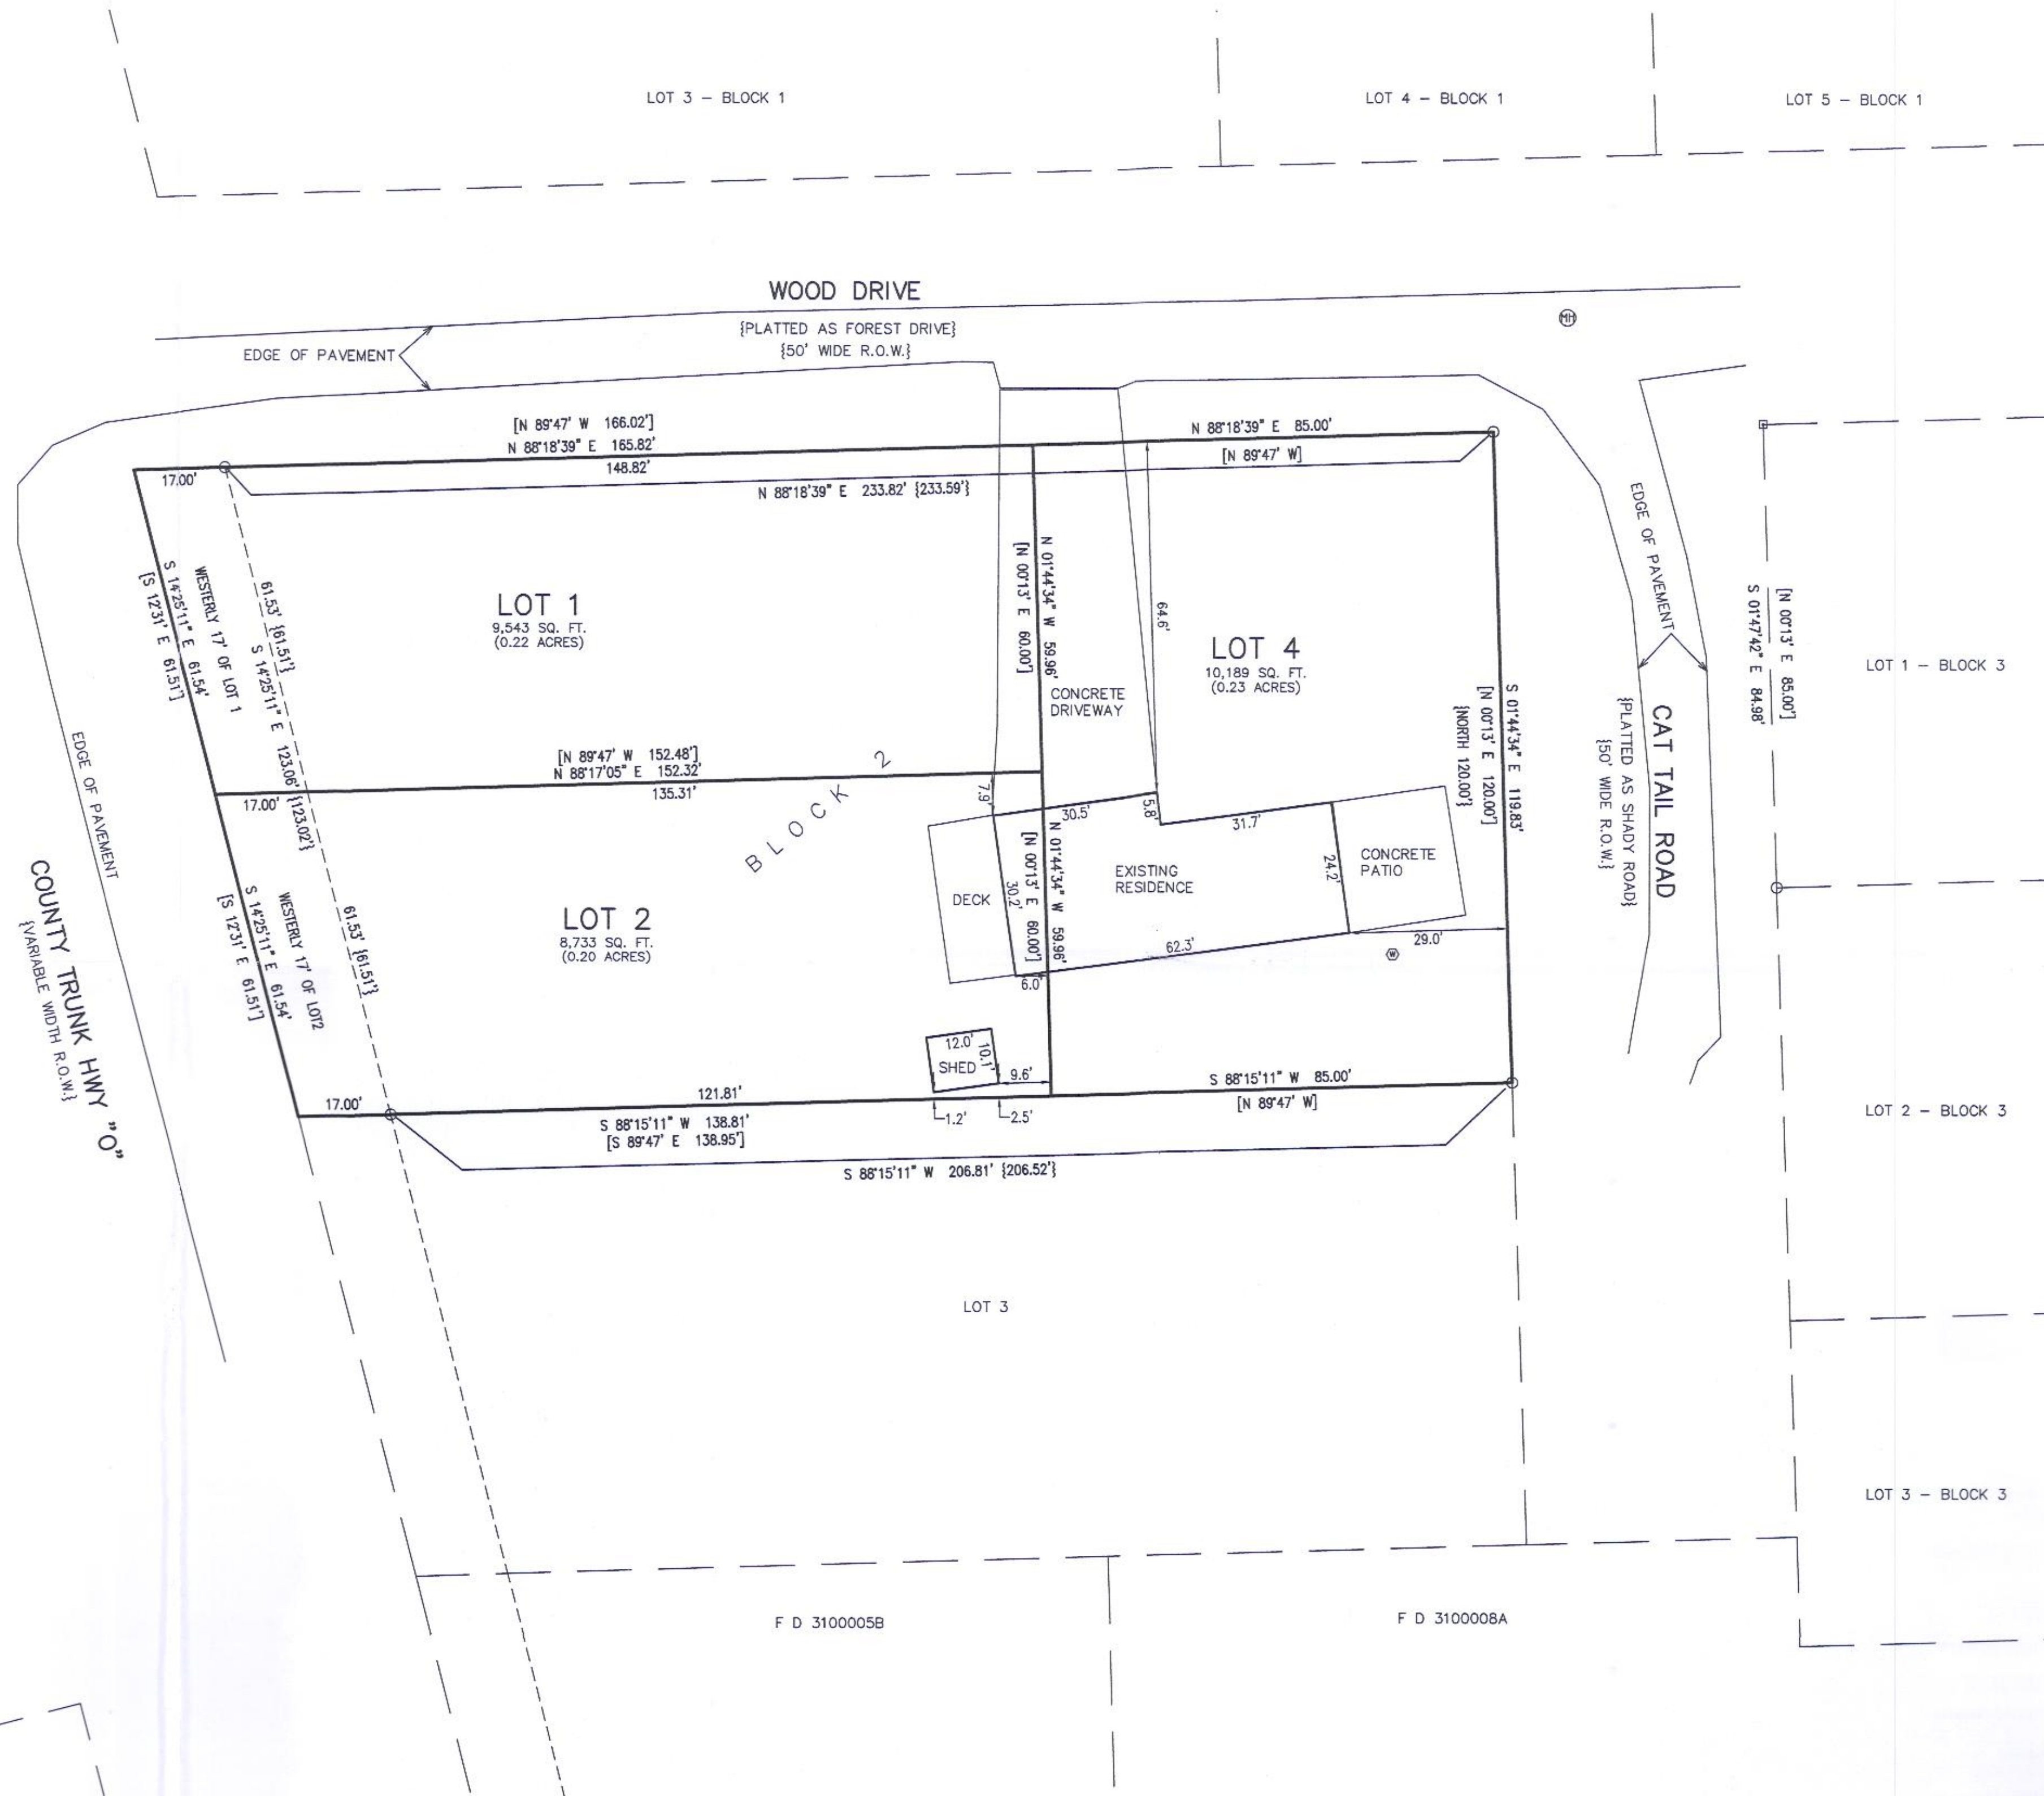

MAP SCALE IN FEET - ORIGINAL 1"=20'

FO-3 FO-3B

216-5374